

5 MAY 1944

GLASGOW REPORT No. 68417

Rpt. C. 11 (Contd.)



Index No. ....

# Lloyd's Register of Shipping.

Ship's Name S.S. "LADY CONNAUGHT"

Official No. 132019

Memorandum of alterations reported since ship was surveyed for assignment of Load Lines in \_\_\_\_\_

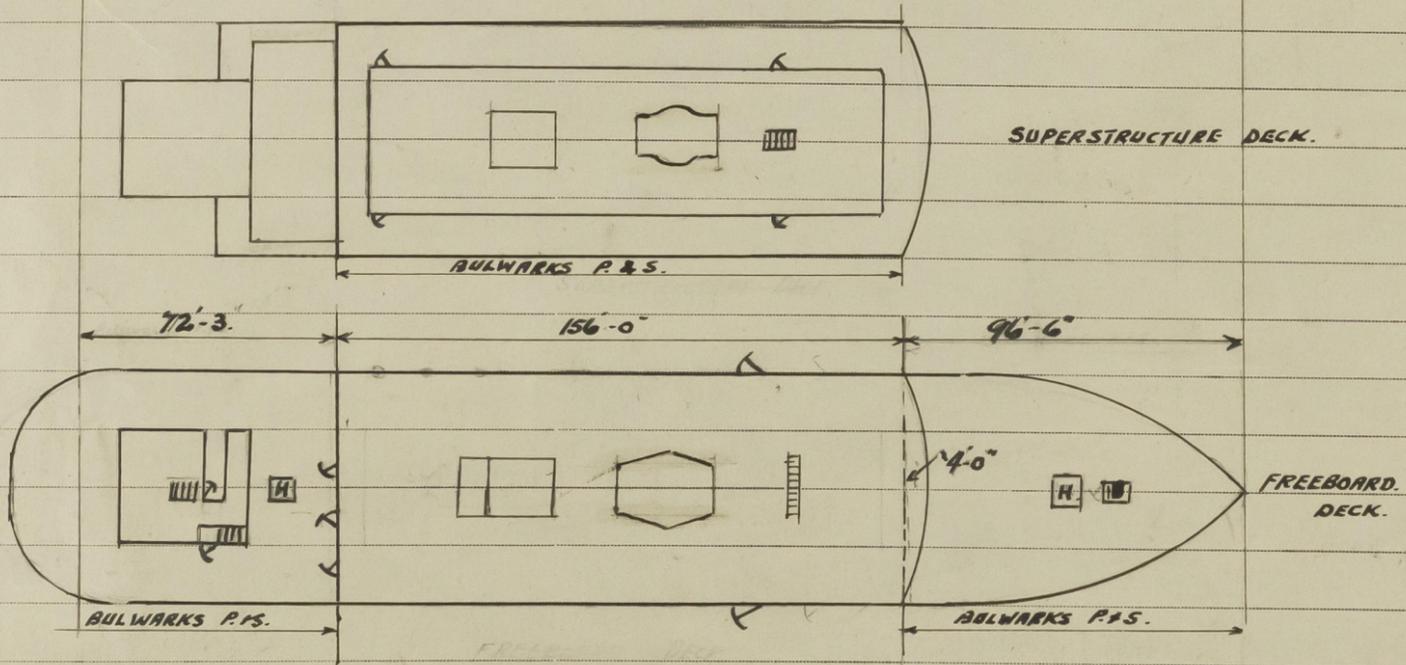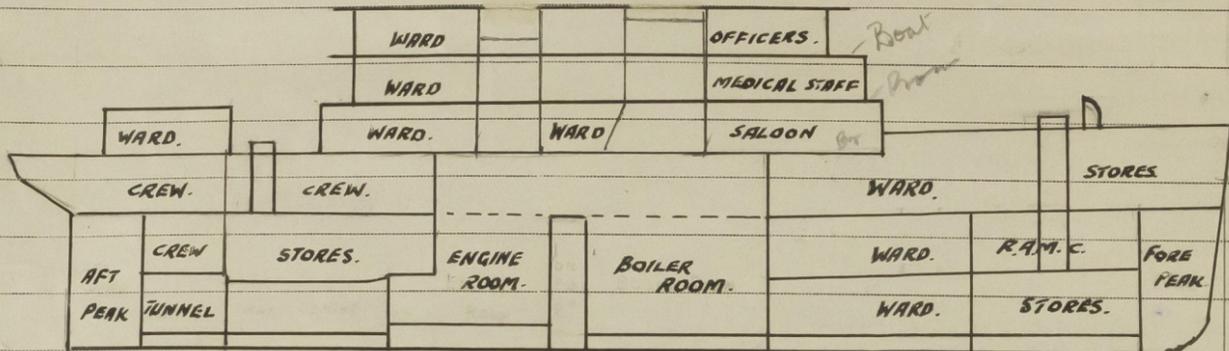

5/96.5  
 19.3

George Fullin  
 Glasgow 3<sup>rd</sup> May 1944.

