

MOTOR BENZINE LIGHTER.


STEELWORK PROFILE & DECK.

SCALE - 1/4" = 1 FOOT.

VESSEL ALL WELDED EXCEPT THAT FRAMES ARE TO BE RIVETED TO SHELL & MAIN DECK STRINGER ANGLE TO BE RIVETED TO DECK SHELL.

SEE WELDING SCHEDULE FOR ALL WELDING.

TO CLASS + 100 A. for Malayan  
Central Service, CARRYING PETROLEUM IN BULK.

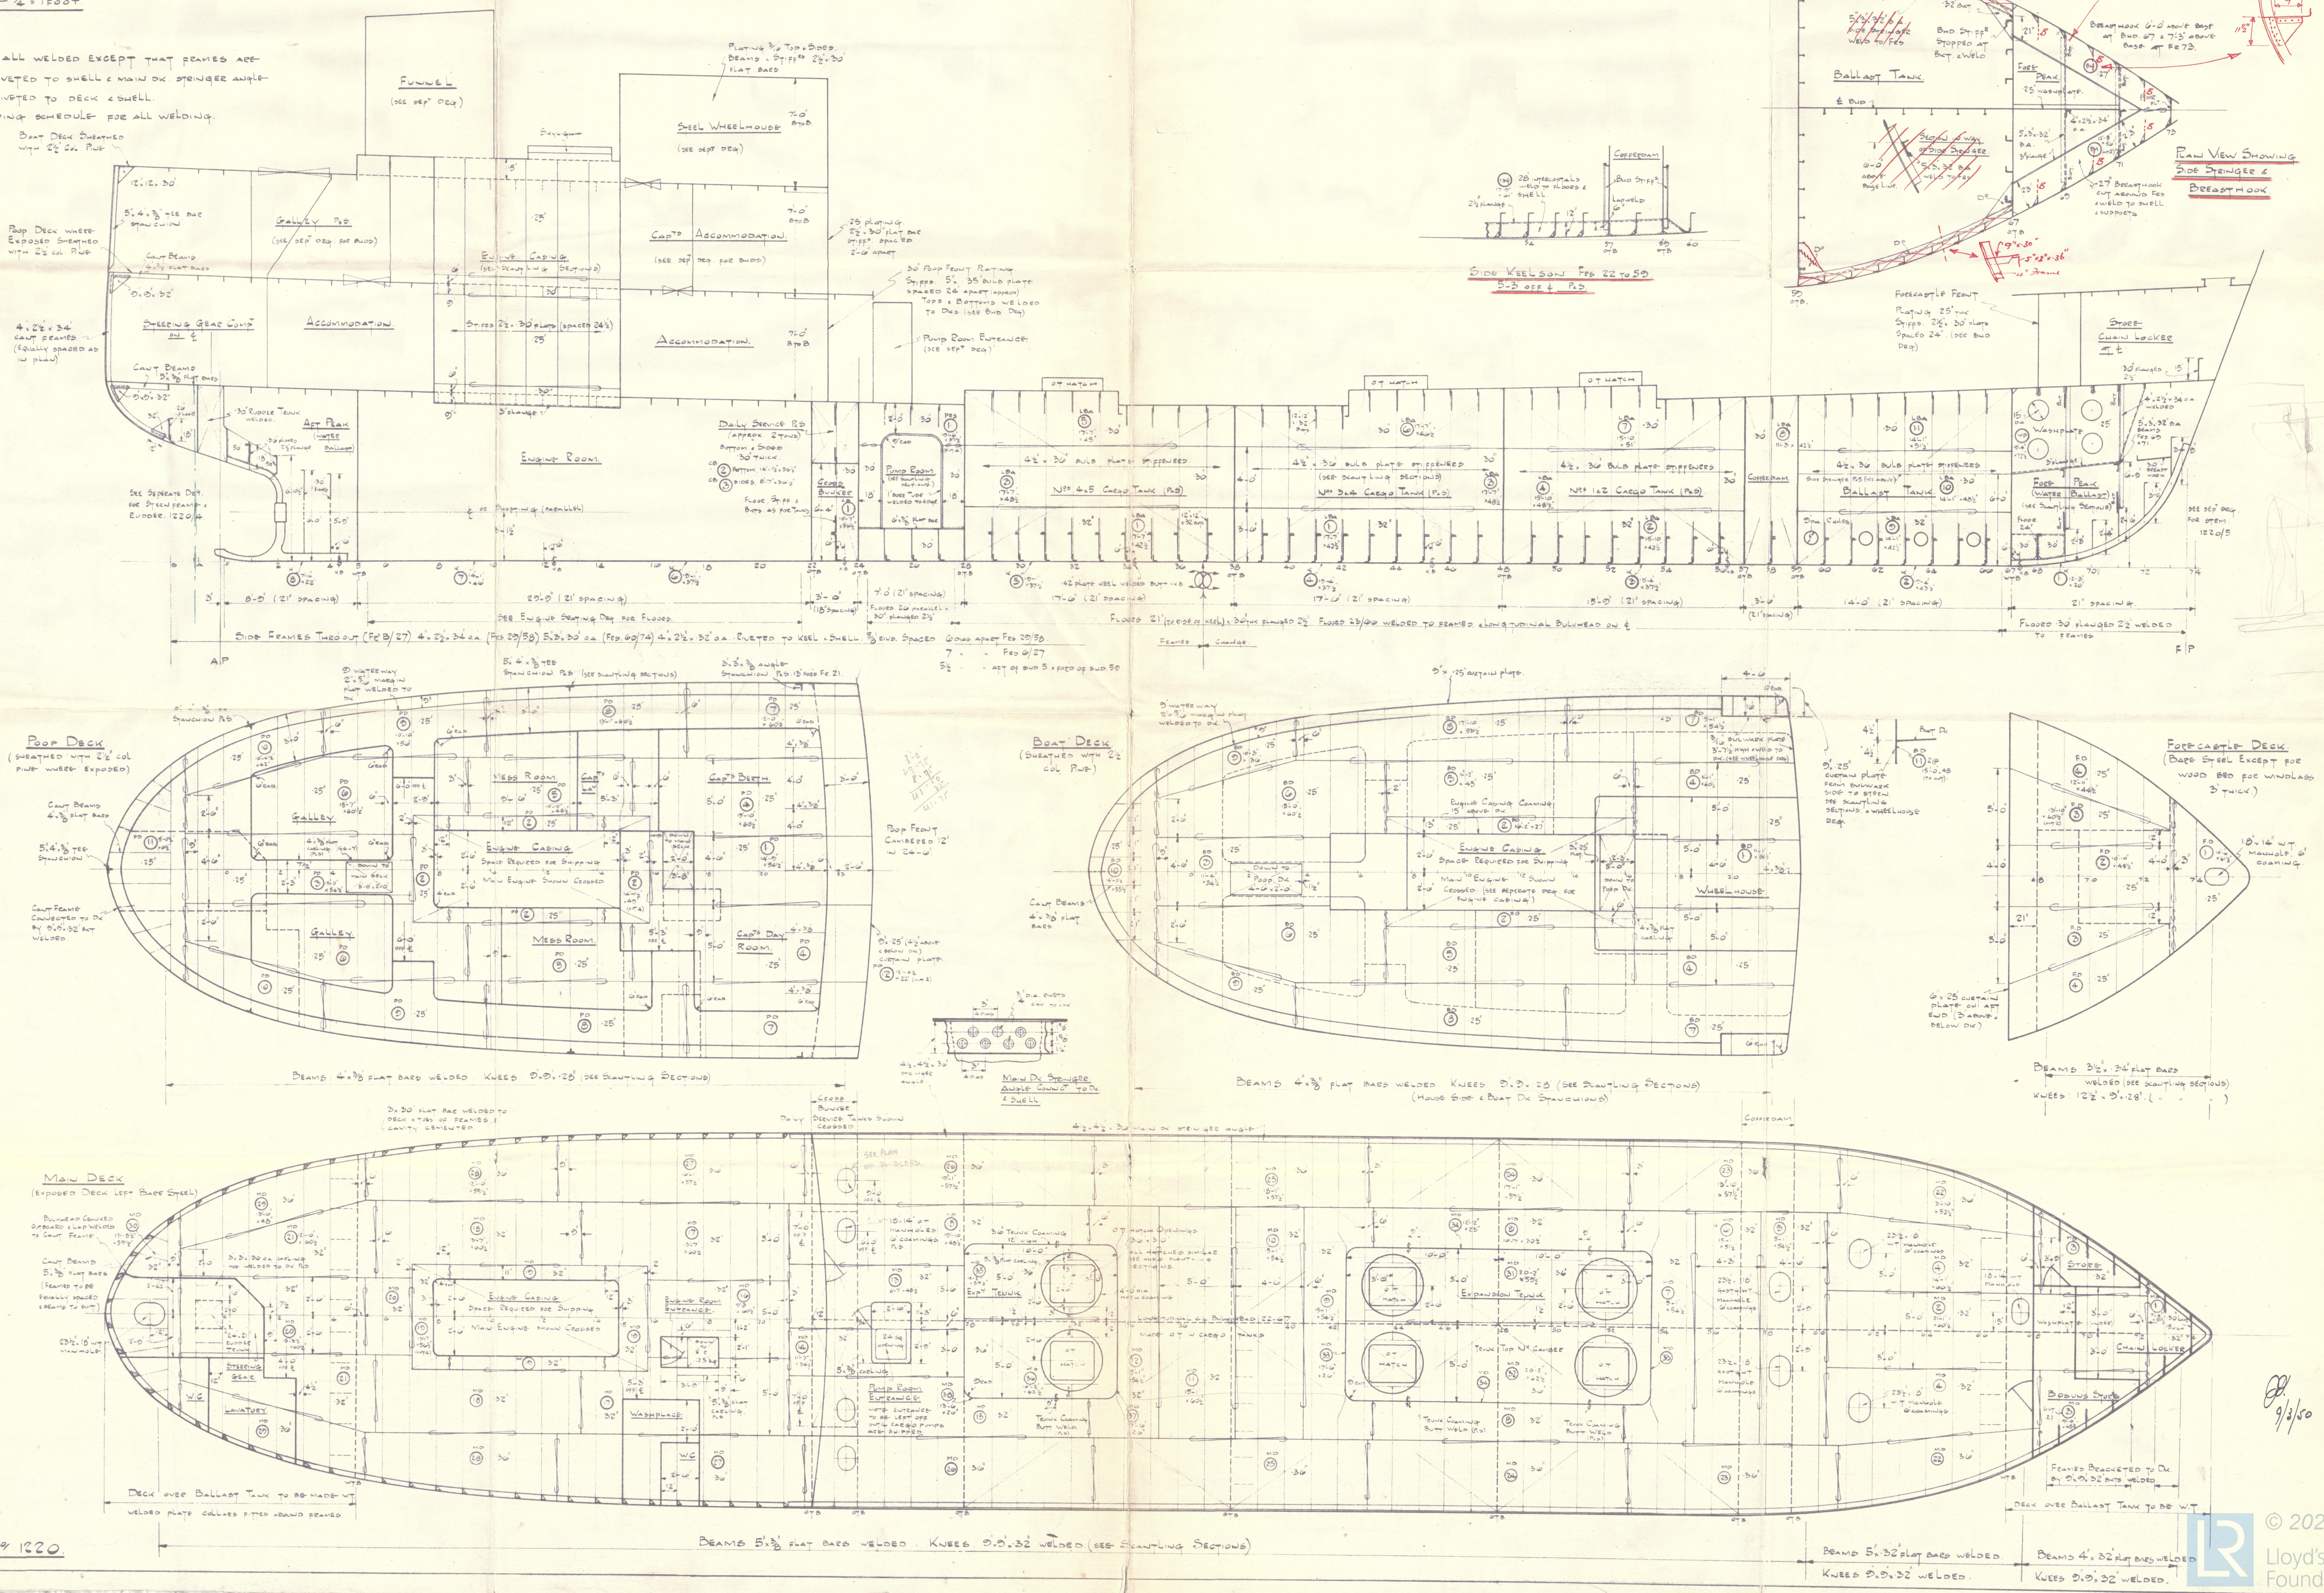

9/3/50



"LANDAK" ★

PHILIP & SON YARD N<sup>o</sup> 1220

PLYMOUTH REPORT N<sup>o</sup> 8116

STEELWORK PROFILE & DECKS.

RECORDS DEPT.,  
LONDON



© 2020

Lloyd's Register  
Foundation

002157-002164-0086