


TO . .  
CITY LINE LTD.,  
75 Bothwell Street,  
GLASGOW, C.2.

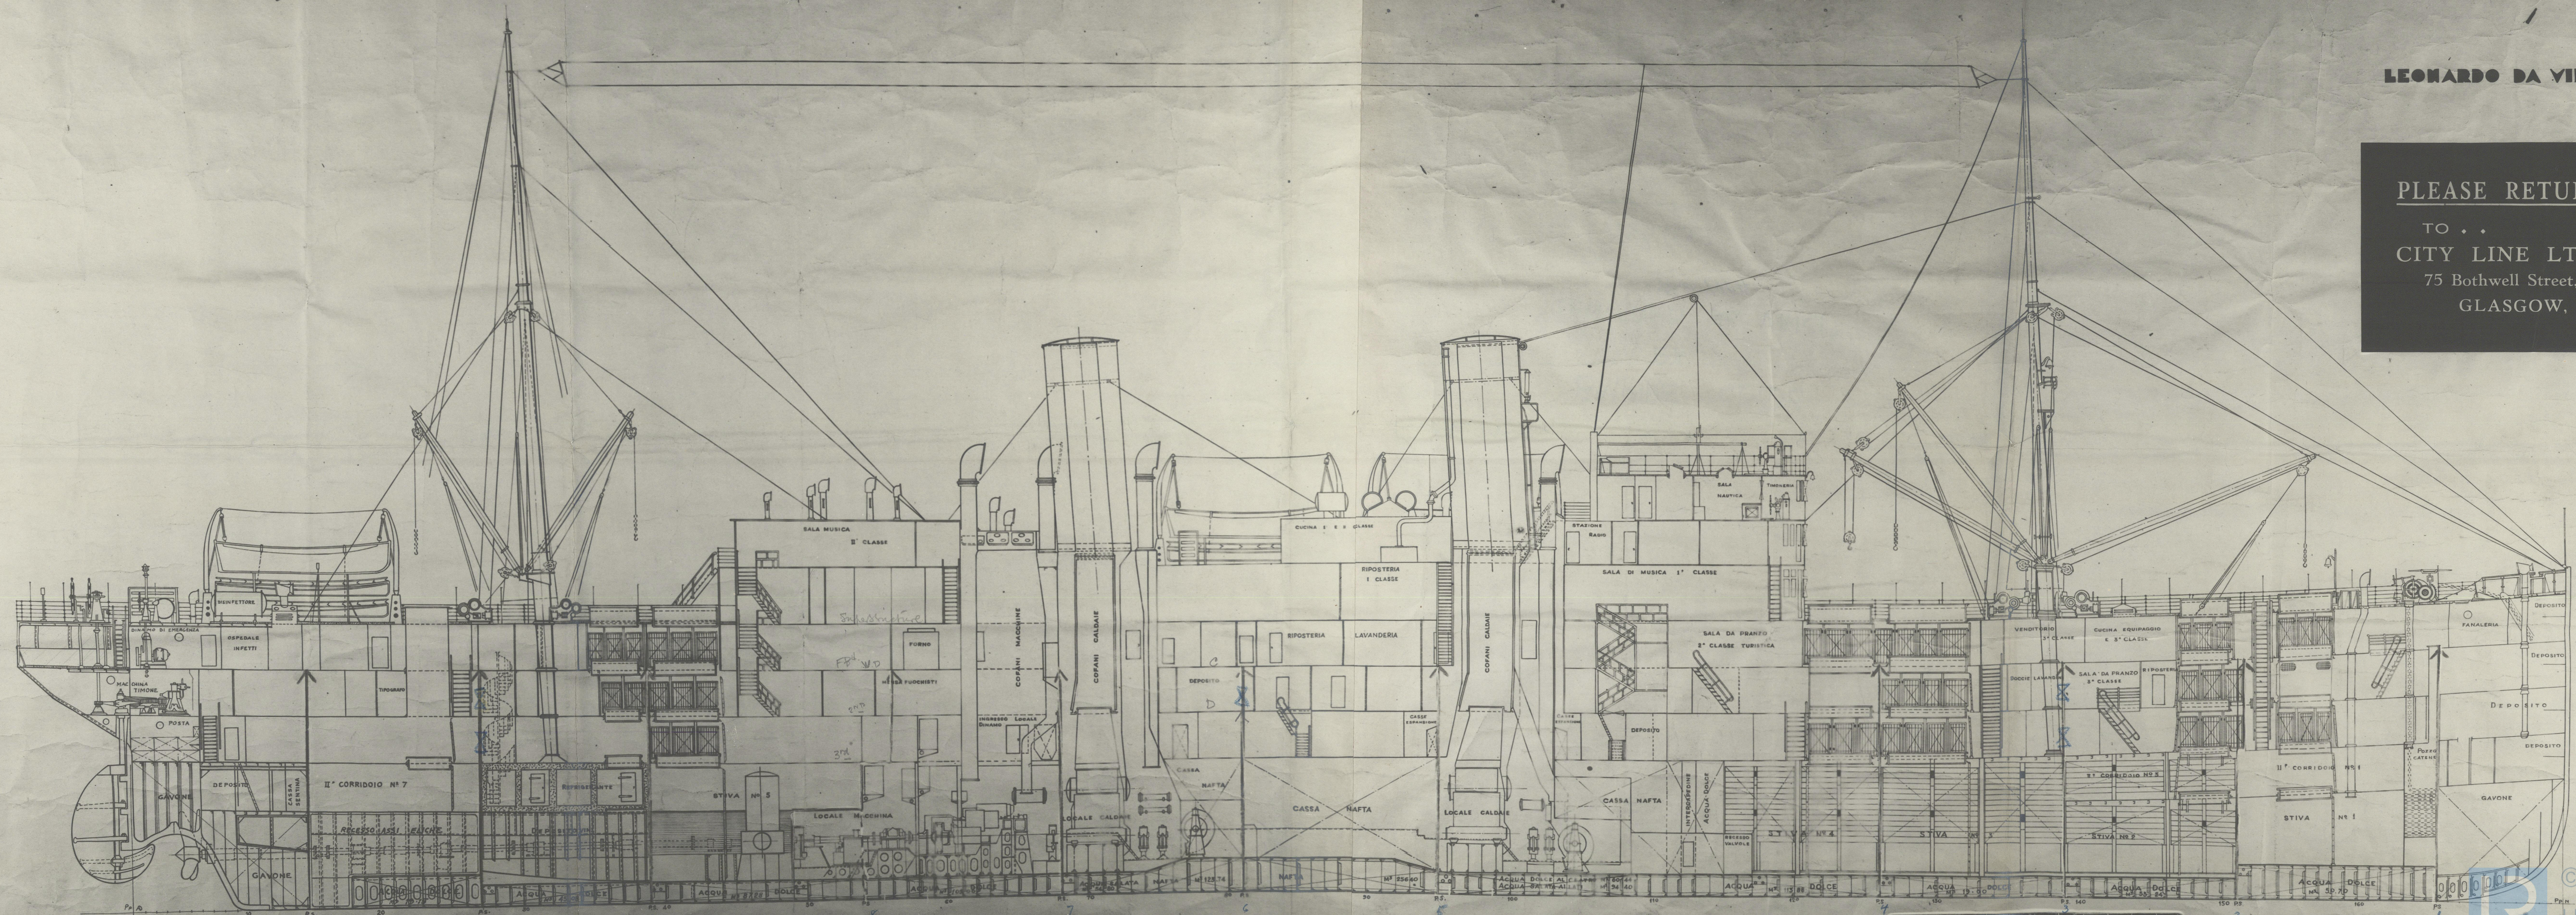

LLOYD TRIESTINO - UFF. TECNICO - GENOVA - AGGIORNATO AL 10-1938



"EMPIRE CLYDE"

EX

"LEONARDO da VINCI"

Bal 7904

Profile.

002184-002193-0002



© 2020

Lloyd's Register  
Foundation