

DEPTH MOULDED ————— 13'-10



 © 2005
 Lloyd's Register
 Foundation
 002194-002205-0111

RECEIVED
LLOYD'S REGISTER OF SHIPS
9 APR 1906
LONDON

RECEIVED
LLOYD'S REGISTER OF SHIPS
9 APR 1906
LONDON

Termia

RECEIVED
LLOYD'S REGISTER OF SHIPS
9 APR 1906
LONDON

RECEIVED
LLOYD'S REGISTER OF SHIPS
28 AUG 1910
LONDON

081610 1906
Lloyd's Register of Shipping
LONDON

RECEIVED
LLOYD'S REGISTER OF SHIPS
5 JUL 1905
LONDON

RECEIVED
LLOYD'S REGISTER OF SHIPS
28 AUG 1910
LONDON

011010
0880
244
011010


Hamelstrom IV

Bo. S. S. Fernie's

Erikshergs huch. Marks

Got. ofl. 1283.

midship Section

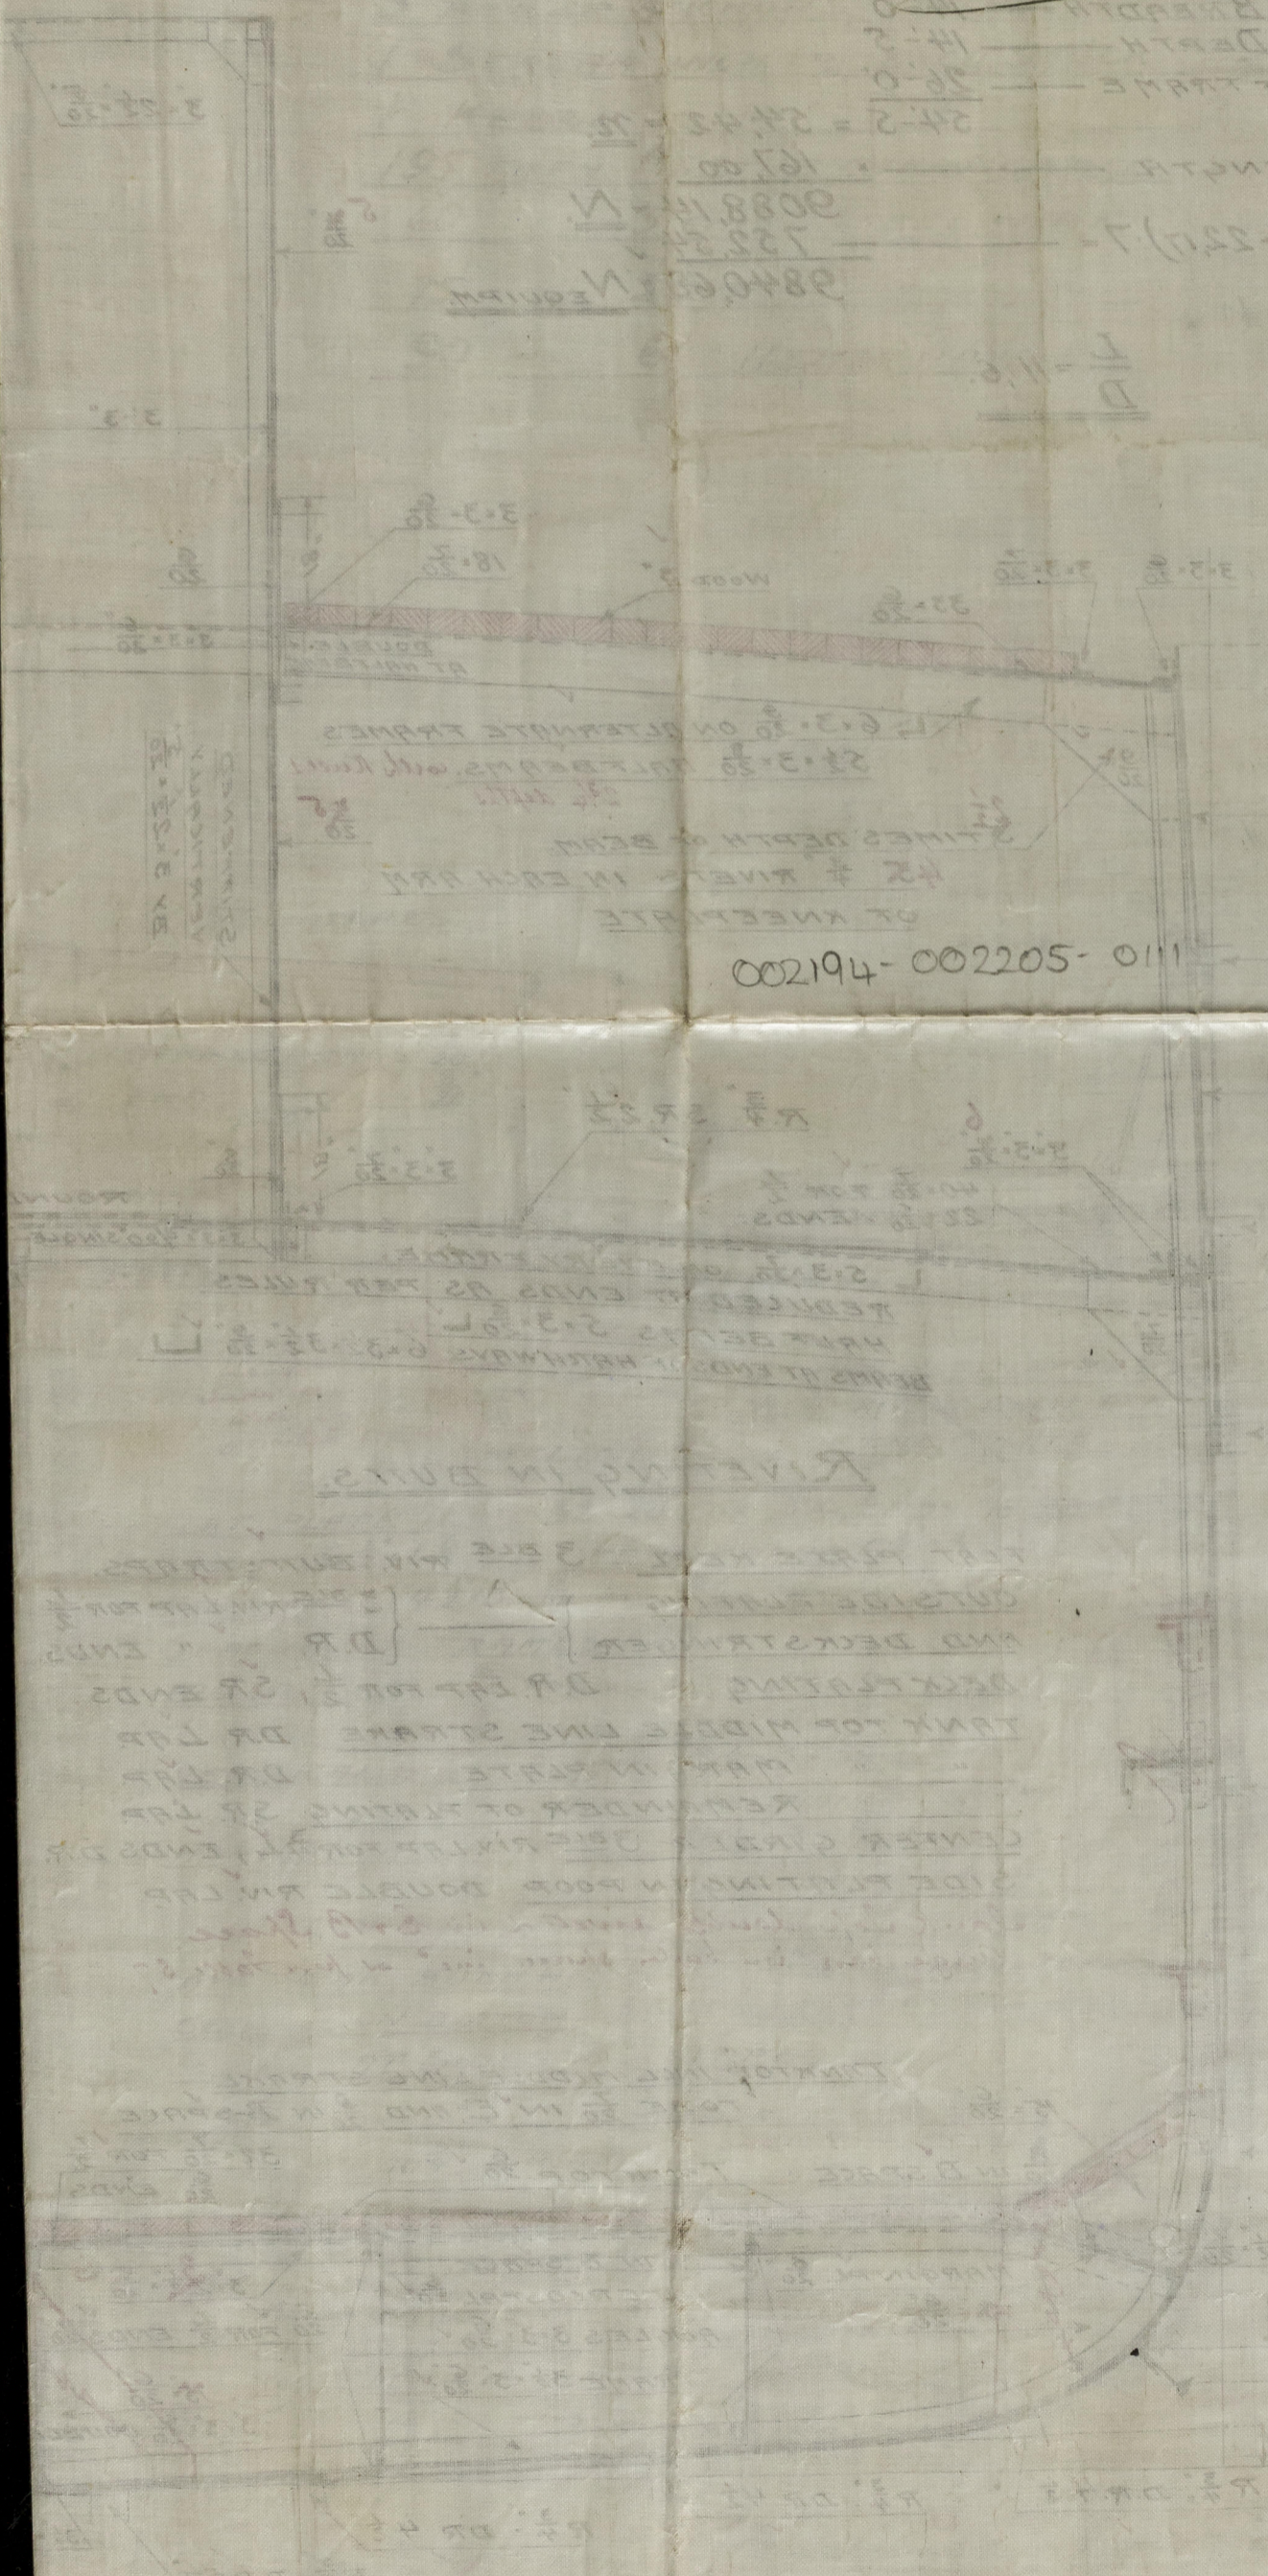

002194-002205-0111

LLOYD'S REGISTER OF SHIPPING
Received
GOTHENBURG
5. 7. 05

LLOYD'S REGISTER OF SHIPPING
Received
GOTHENBURG
31-3-05

LLOYD'S REGISTER OF SHIPPING
Received
GOTHENBURG
30-3-05



Lloyd's Register
Foundation

002194-002205-0111