

LONGITUDINAL SECTION AND PLAN OF CARGO STEAMER.

TO CLASS BRITISH LLOYDS 100 A, STEEL.



SCALE $\frac{1}{8}$ " = 1 FOOT ENGL.

DIMENSIONS.

LENGTH LLOYDS	167-0"
BREADTH	28-0"
DEPTH	14-5"
DEPTH MOULDED	13-10"

Yard No 130
Eriksbergs Mekan. Werkstad
Göteborg

1-3-05
20-3-05

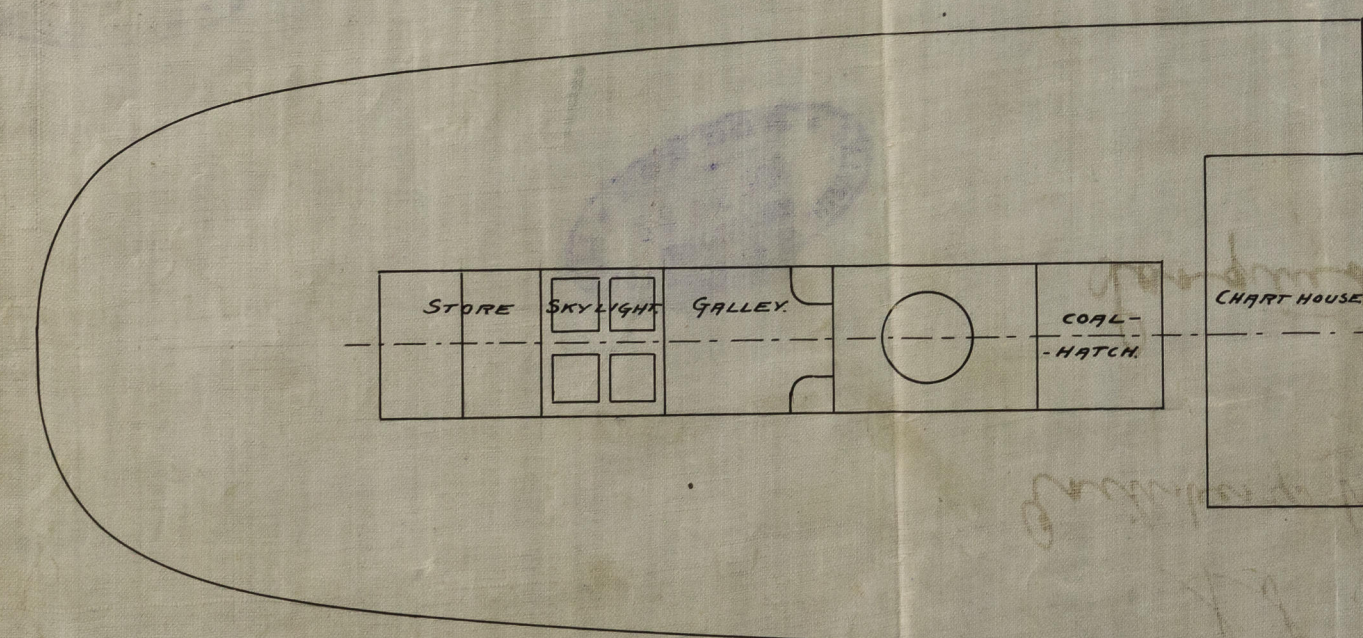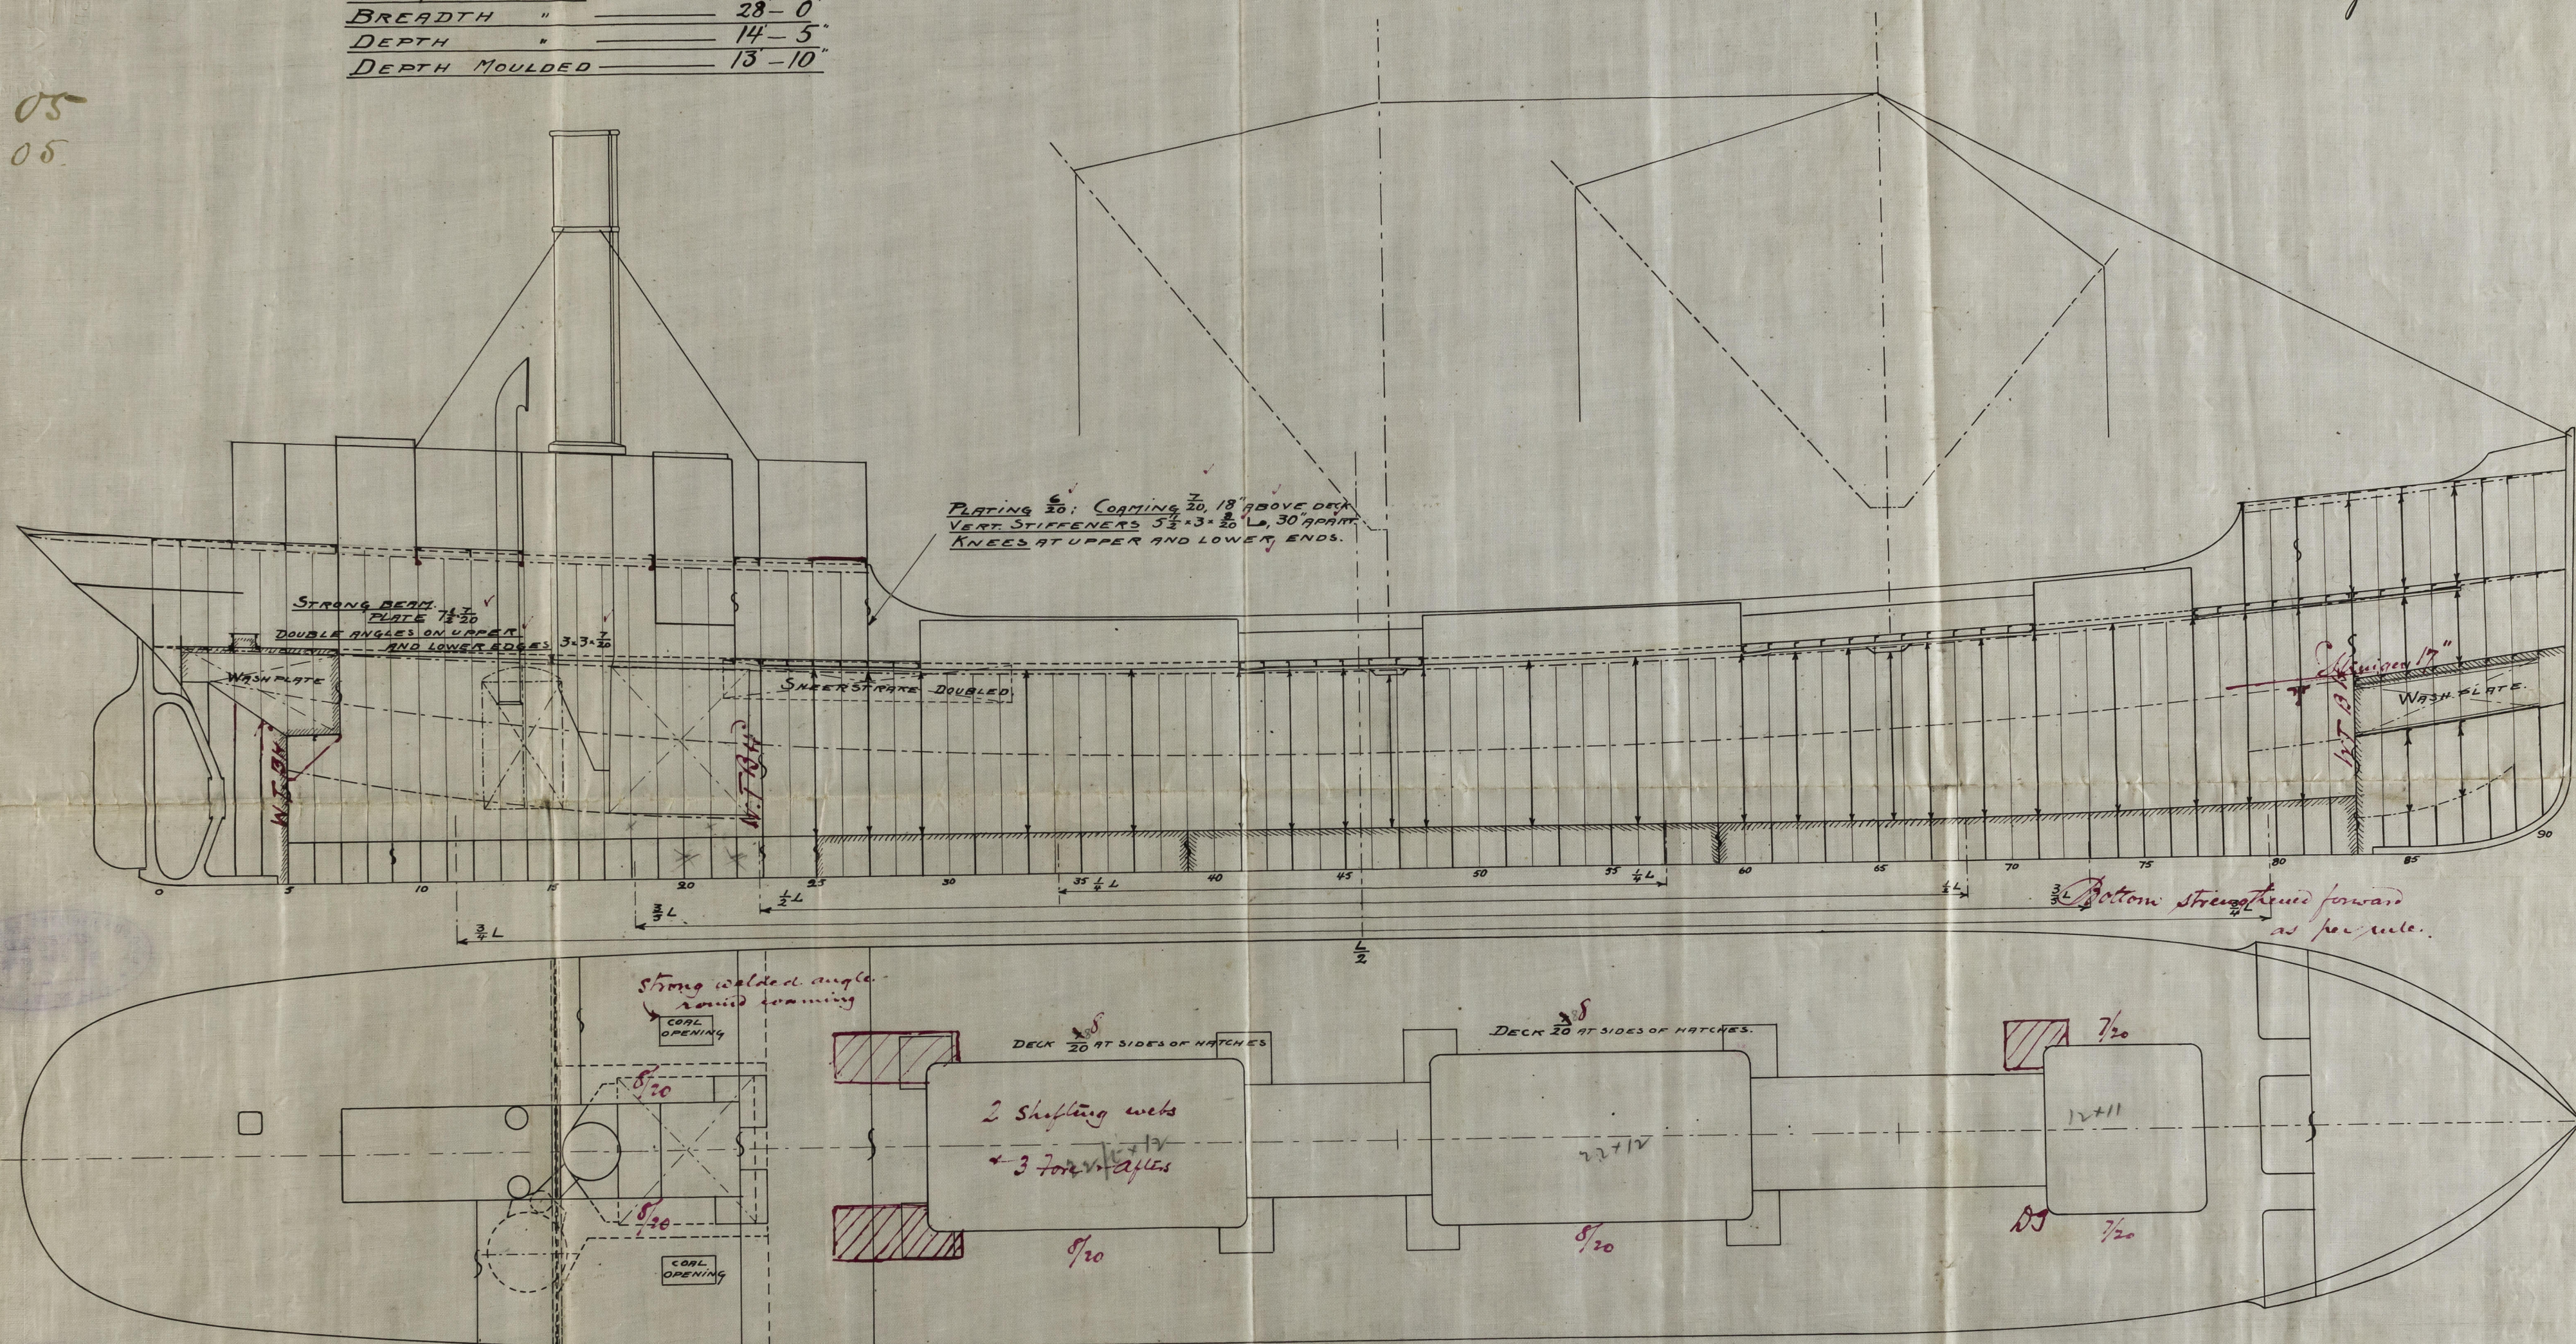

14.1
1/3/05

Hamelton VT



Ex

S. S. Fernia

Enckenberg Mech Verks. 130.

Feb. 1283.

Longitudinal Section

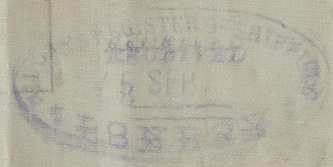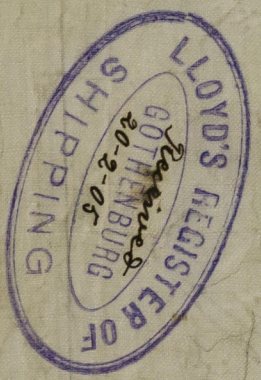

© 2020

Lloyd's Register Foundation

002194-002205-0112