


2-5-16
8-5-16
23-5-16

PROFILE AND DECK
DIM^s 135' 0" B.P. 23' 0" M.D. 106' M.L.D.
N^{os} 723-4
SCALE 1/4" = 1'
TO CLASS 100A.1 AT LLOYD'S.


PLAN No. 116
FOR ENCLOSURE TO
Messrs Lloyd's Surveyors
FROM
COCHRANE & SONS
SHIPBUILDERS SE
27th April 1916

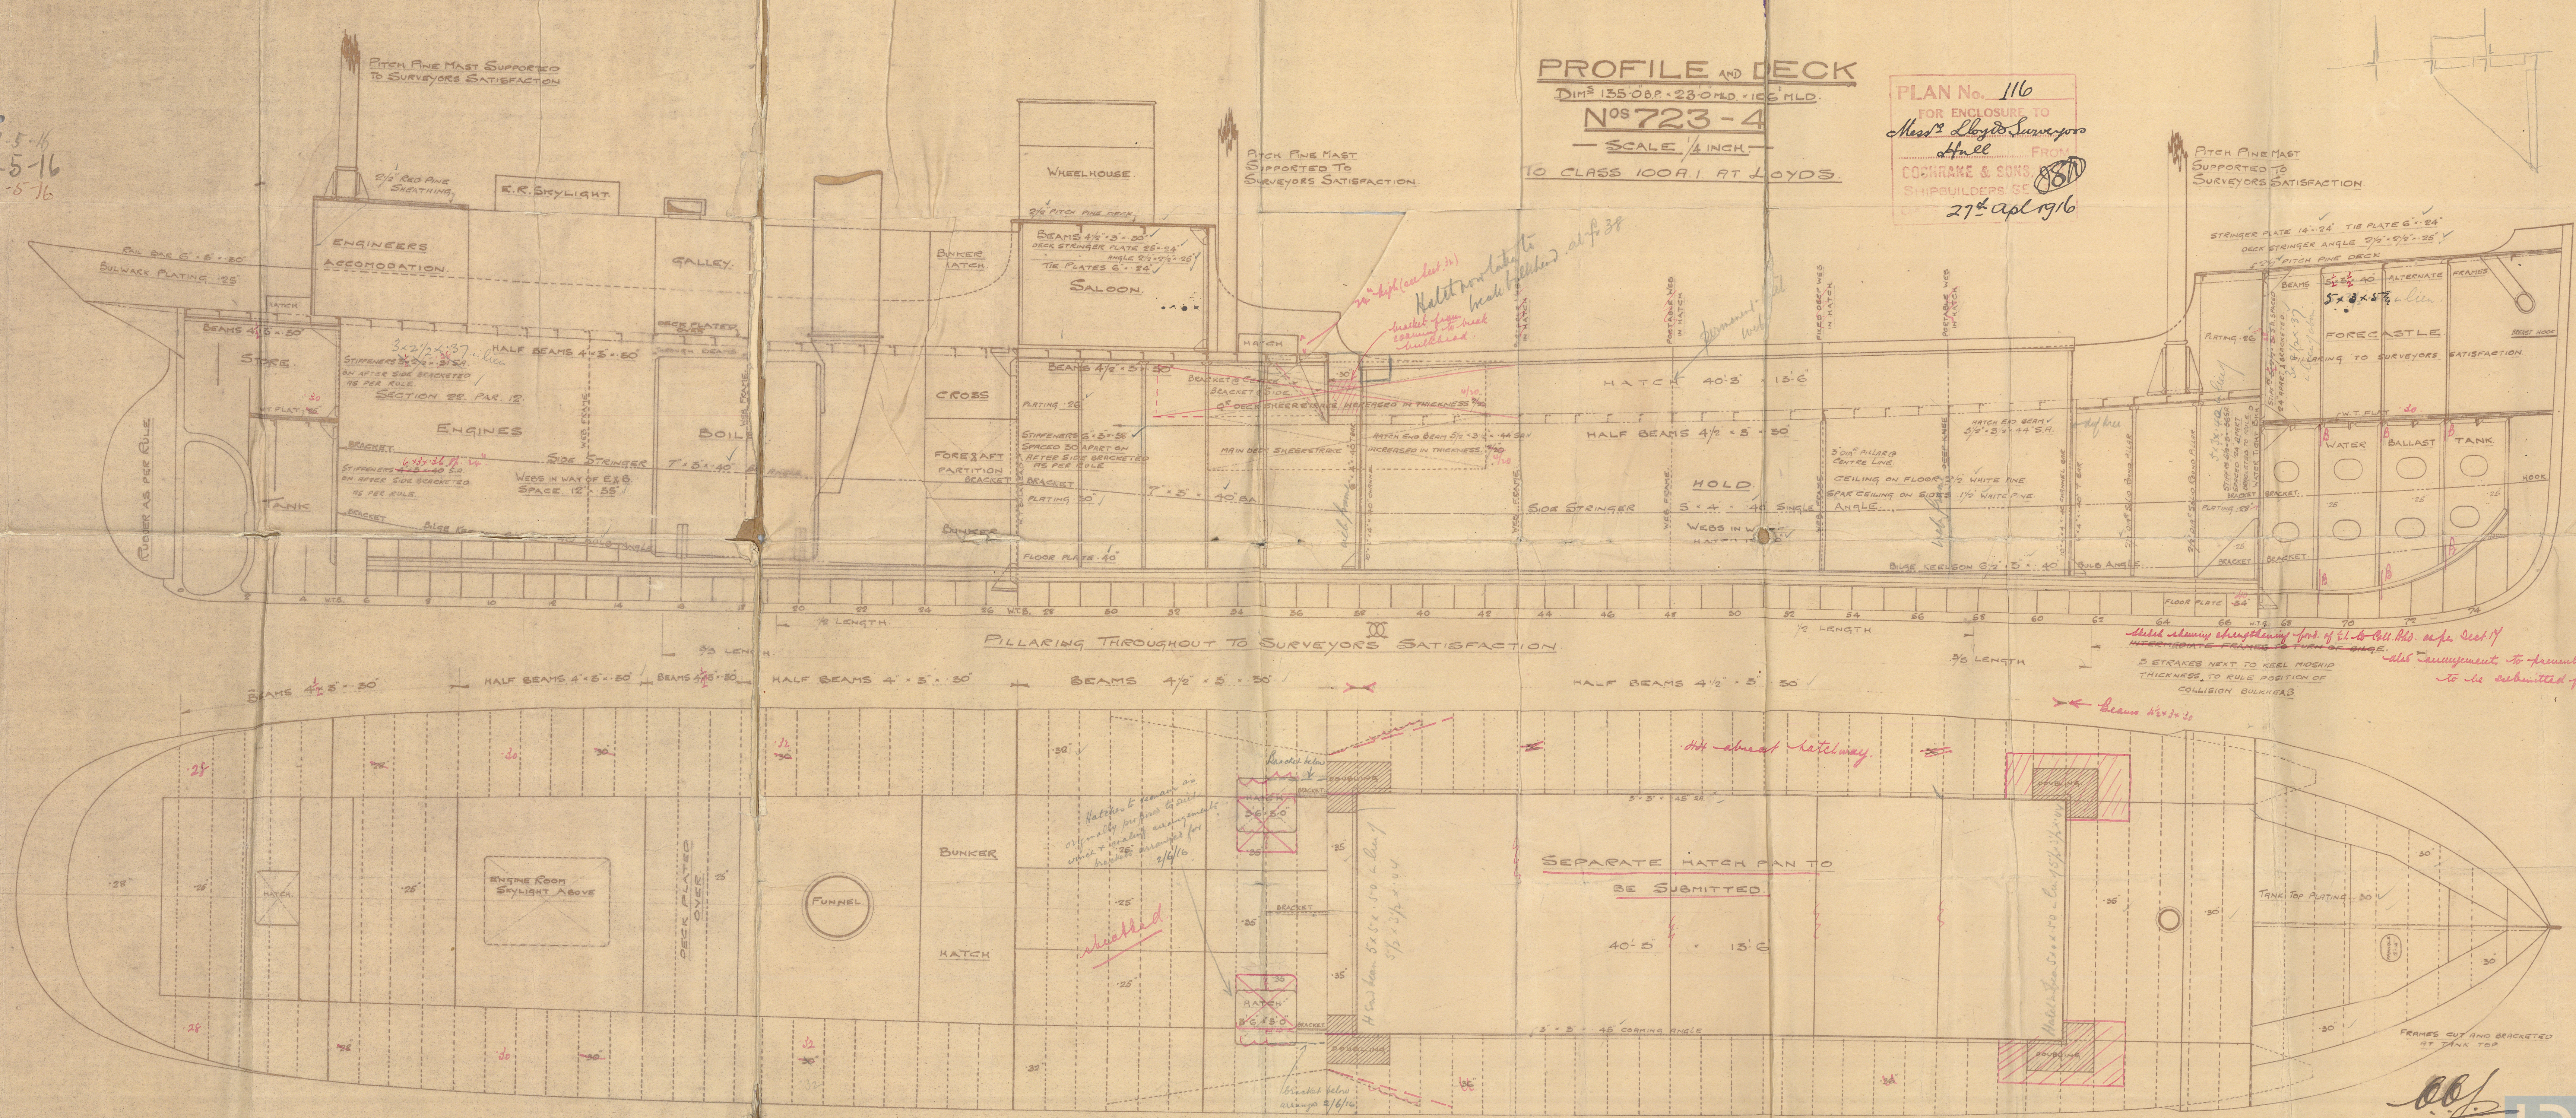

2-5-16

Cochranes' 7234724



Profile and deck plan

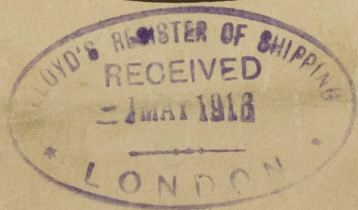

(723) L.S. Magrix "Hull Rpt
no 29710.

724 Robric
Hull 29753

002206-002214-0001

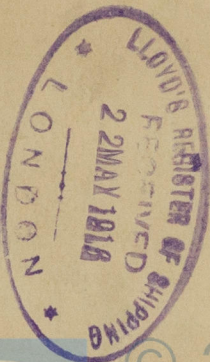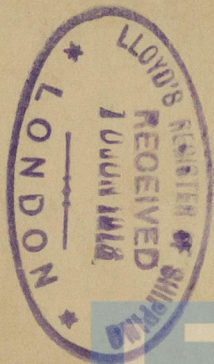

St Robert
Hull 29753



© 2020

Lloyd's Register
Foundation