
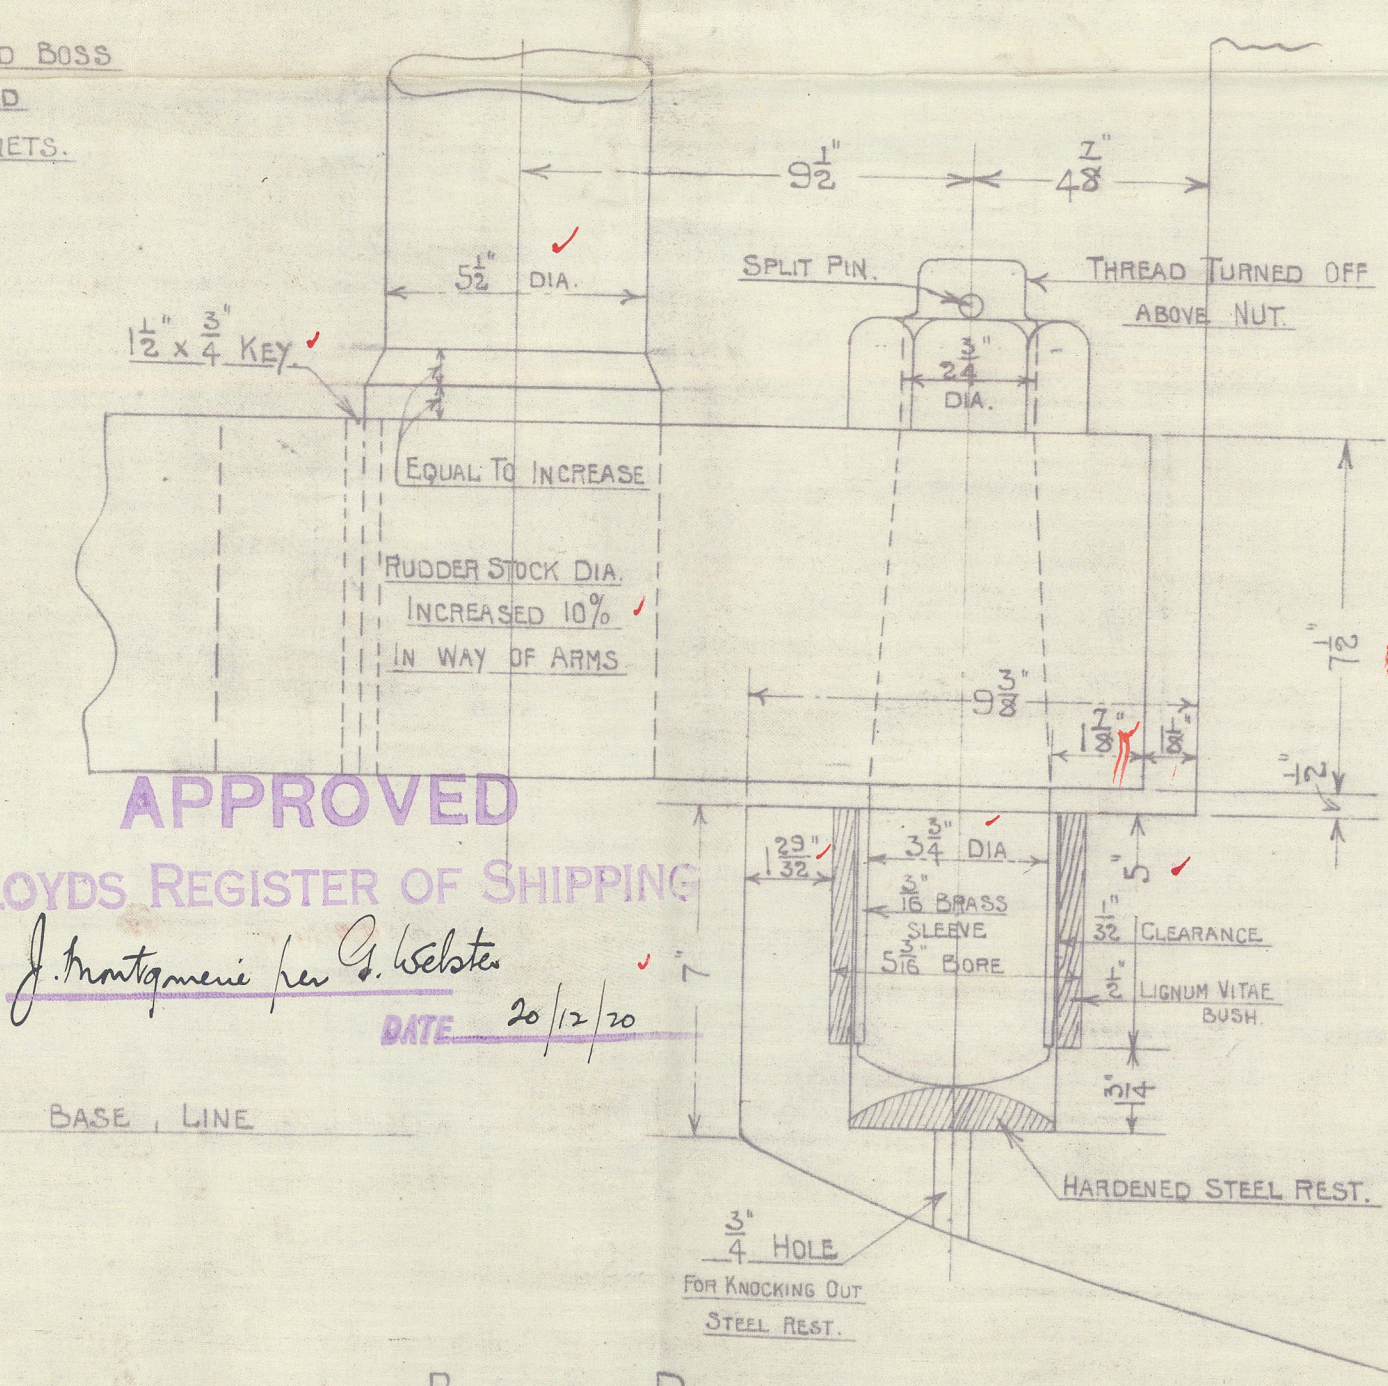


Sternframe & Rudder.

Details as Marked.

LONGITUDINAL N<sup>o</sup> 15592.

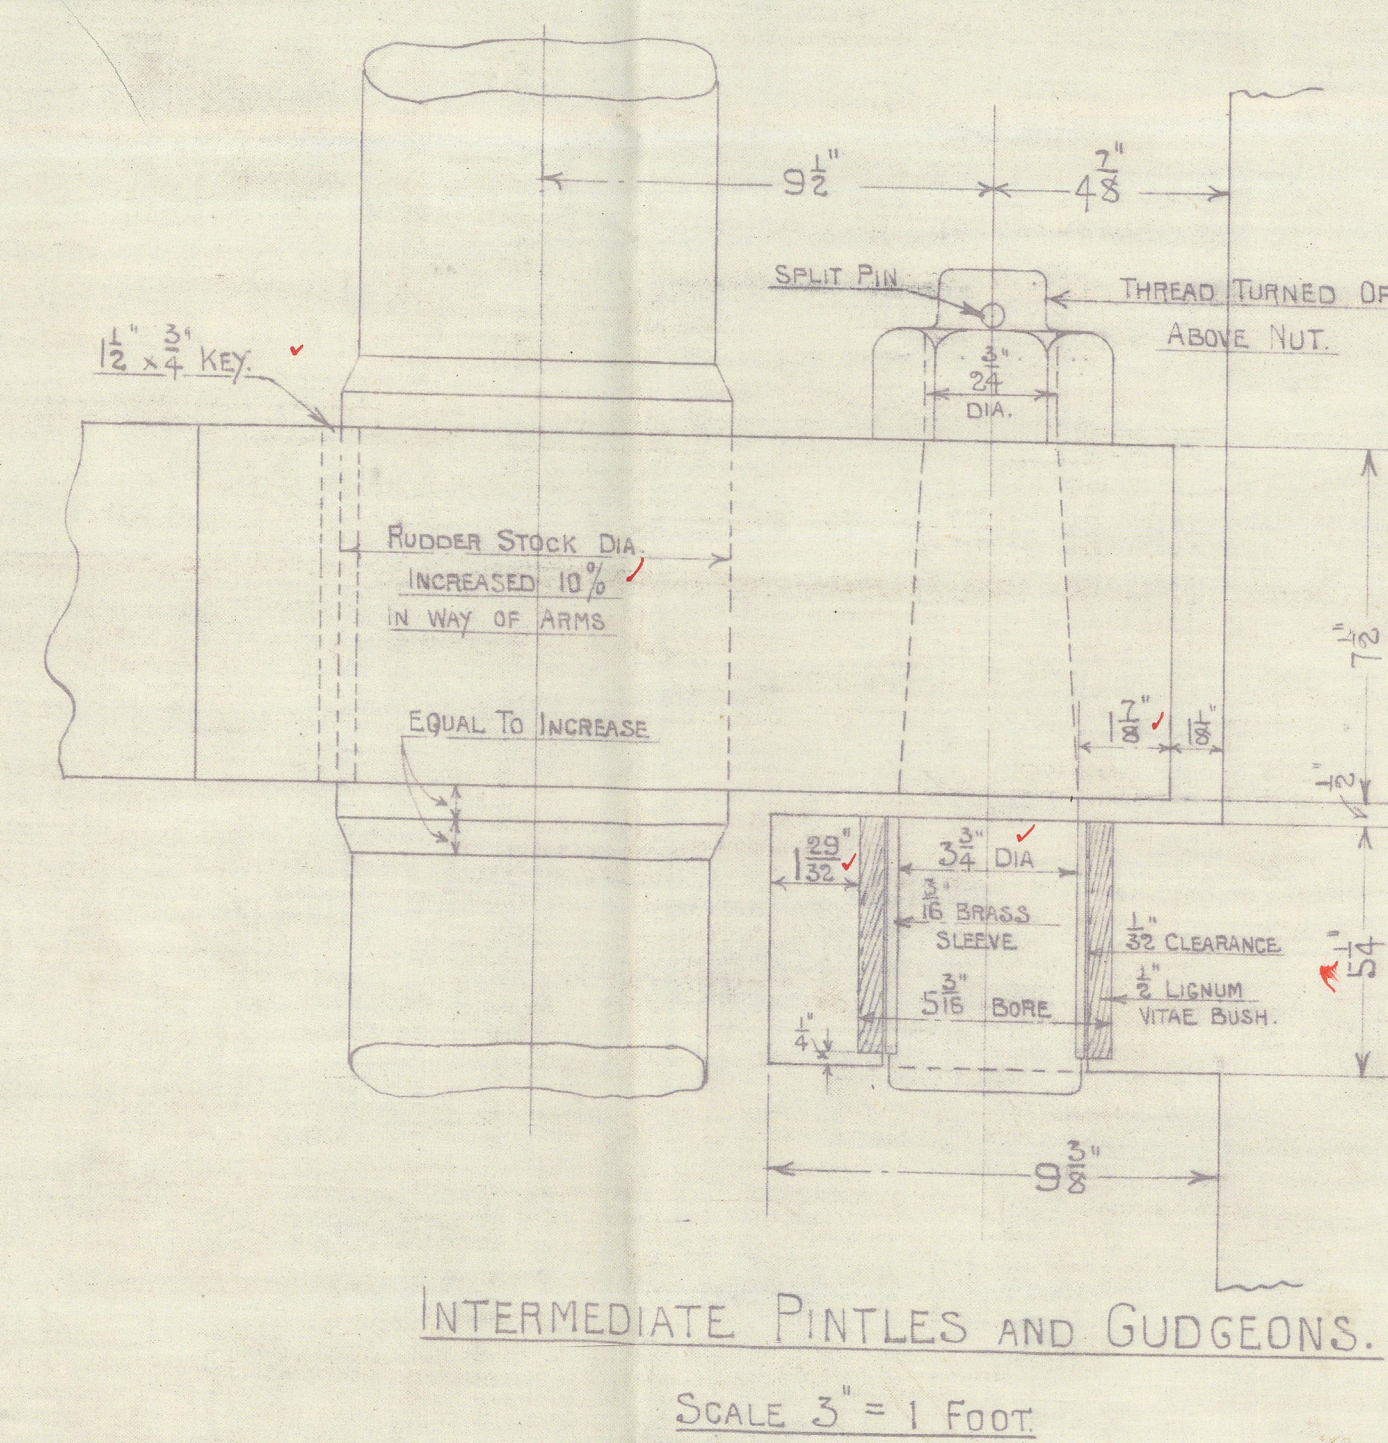

APPROVED  
LLOYDS REGISTER OF SHIPPING  
*J. Montgomery per G. Webster*  
DATE 20/12/20

BOTTOM PINTLE AND GUDGEON.

SCALE 3" = 1 FOOT.

$$A \times D = 93.44 \times 2.62 = 244.8$$

SPEED OF SHIP  $11\frac{1}{4}$  KNOTS. ✓

FERGUSON BROTHERS  
(PORT-GLASGOW) LIMITED  
SHIPBUILDERS  
AND  
ENGINEERS  
PORT GLASGOW  
SHIP-NO. 252

PLAN No. 7

J.W.M.B. © 2020

7<sup>TH</sup> DEC. 1920.

02214-0070



Ferguson Bros Ltd

No 262.

Sternpost & Rudder.

of Ousel

Greenock Report No 17953

---



© 2020

Lloyd's Register  
Foundation

00206-002214-0010