


22.6.99

S.S. N° 600.

# MIDSHIP SECTION.

SCALE  $\frac{1}{2}$  IN. = 1 FOOT

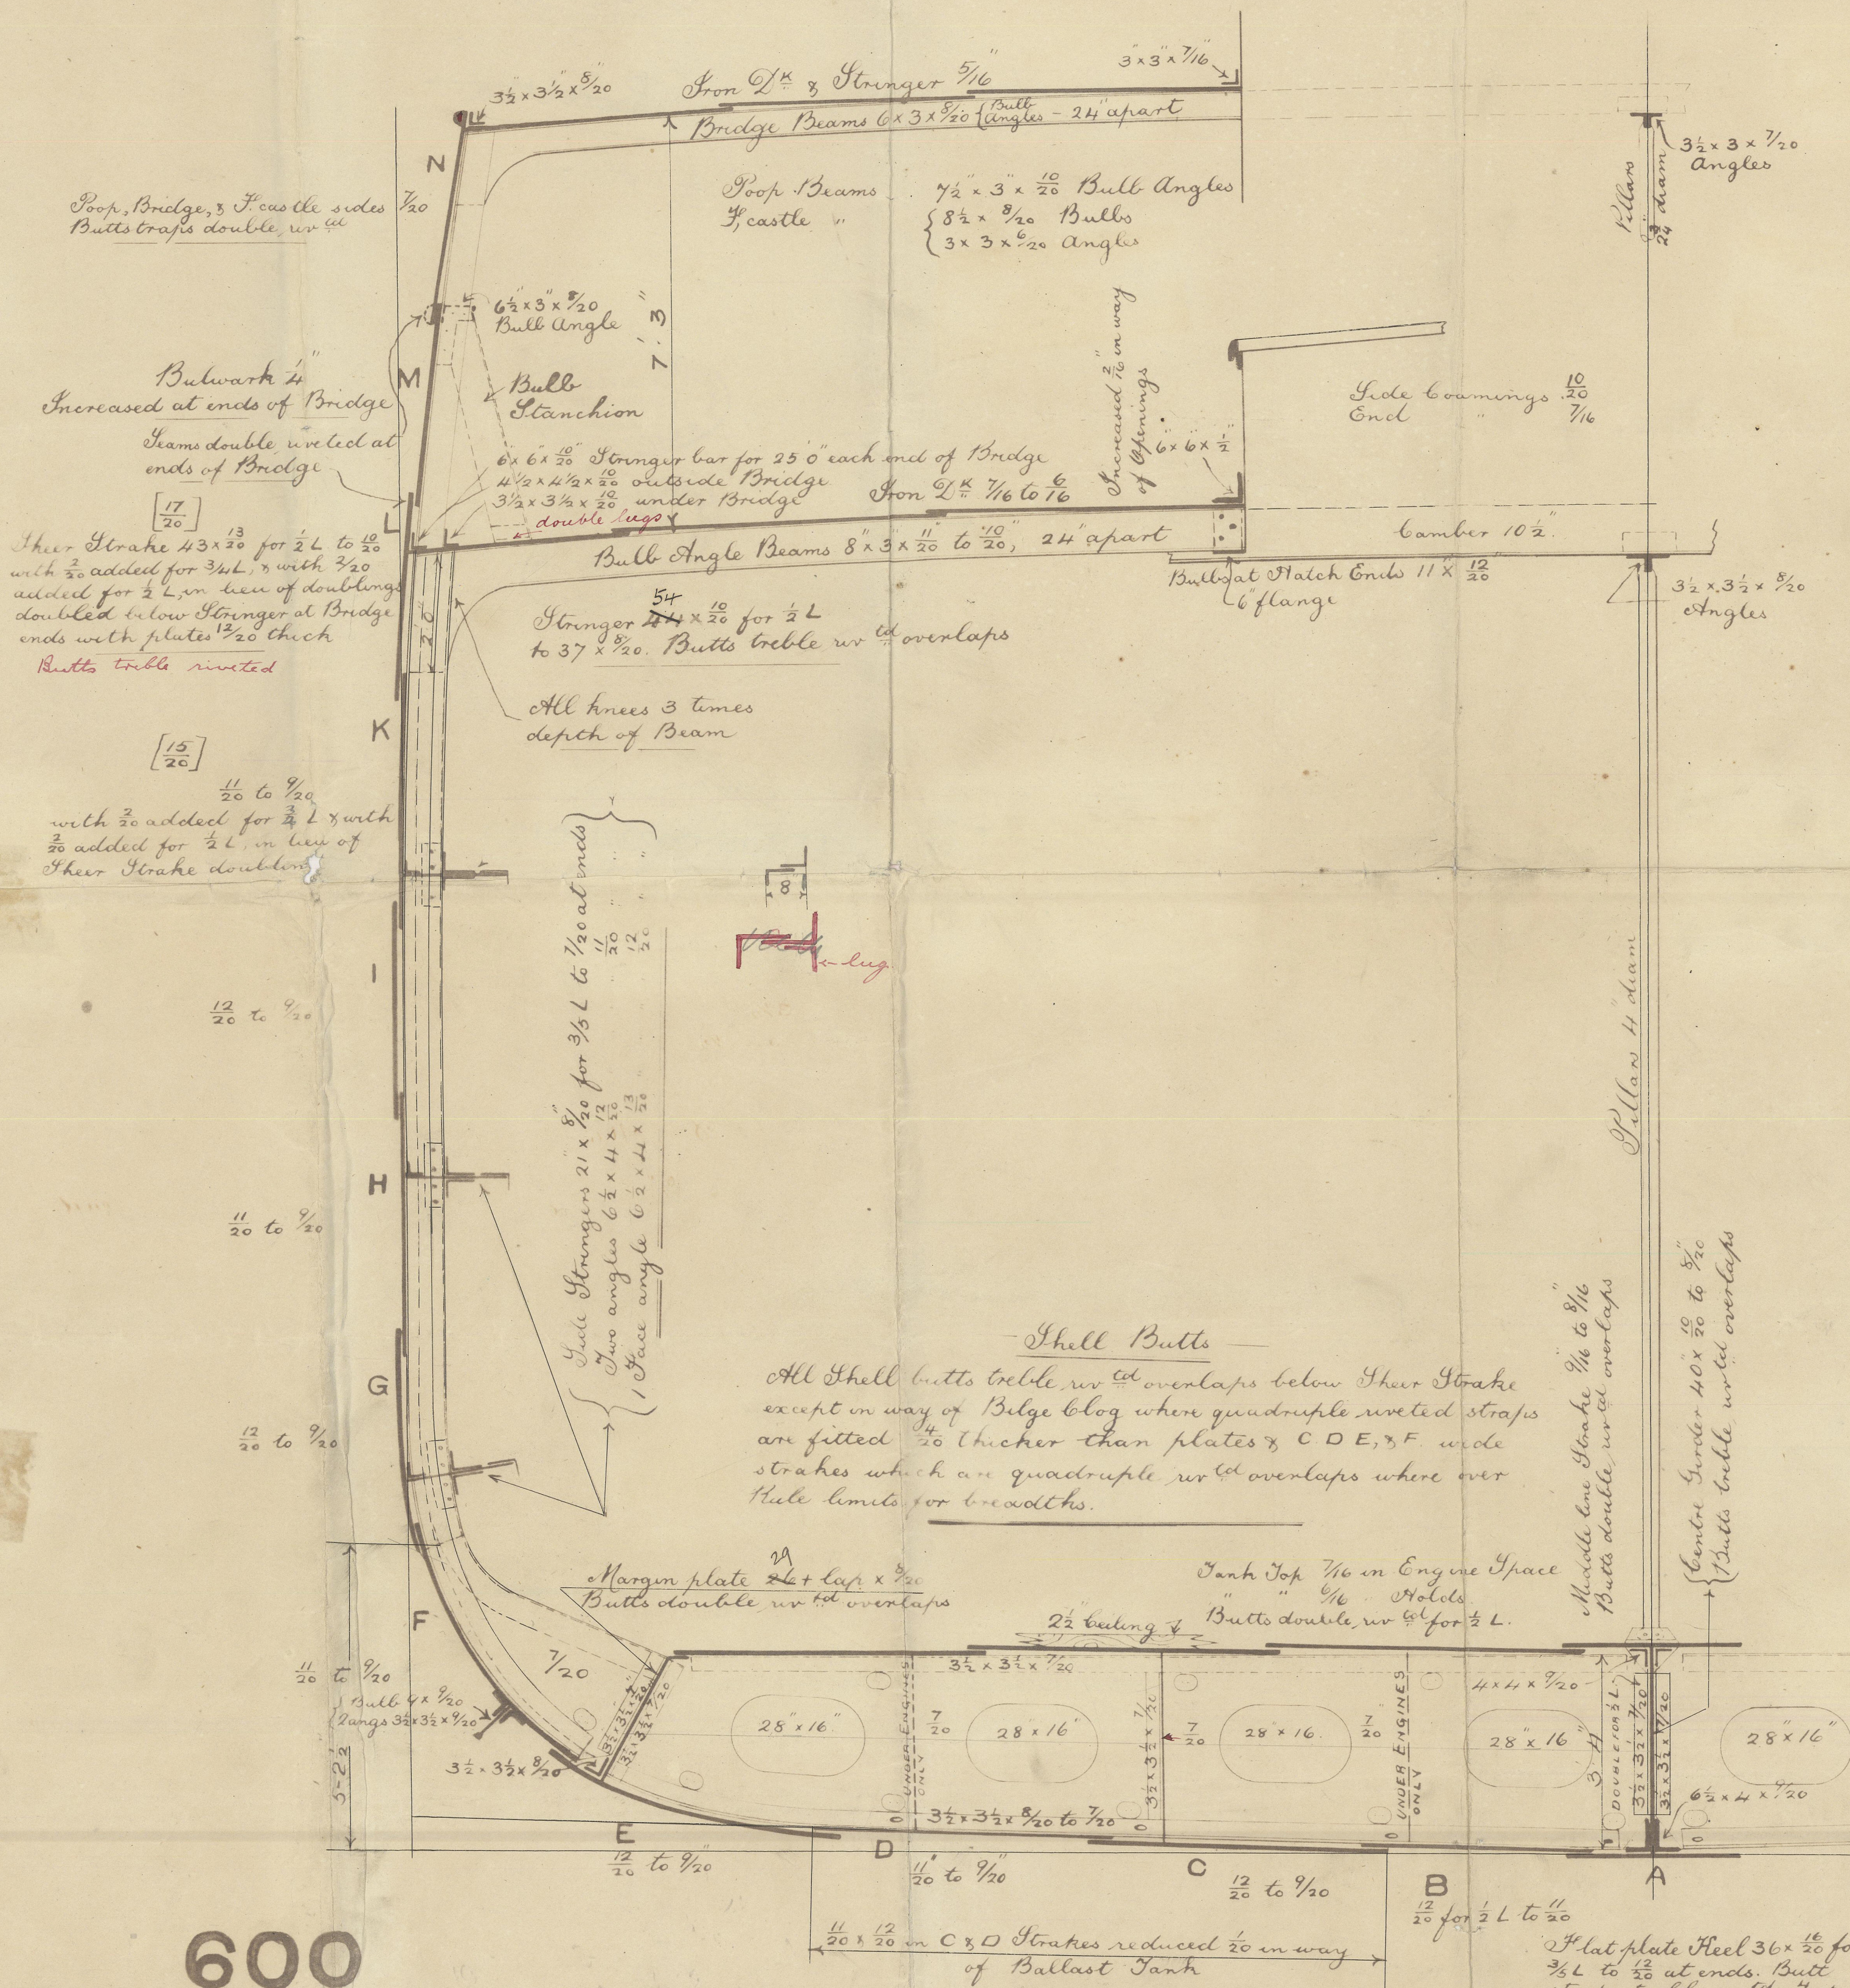

Dimensions	Builders	Lloyds
Length between Piers	302 0	300 34
Breadth Extreme	43 0	42 83
Depth of Hold to top of Girders	19 10	23 16
" " Moulded	22 3 1/2	1/2 Breadth 21 1/4
" " for Frames	84 94	1/2 Girth 40 37
" " Plating	25510 87	Depth 23 16
" " Equipment	26863 51	84 94
Depth to Length	12 96	
Breadths to Length	7 01	Class 100 A.1.

## EQUIPMENT N°

Length of Erection  $\frac{127.34}{300.34} \times \frac{1}{8} = 18.86$   
 $\frac{25510.87}{18.86} = 1352.64 + 25510.87 = 26863.51 = \text{EQUIPMENT N°}$

## EQUIPMENT

2 Bower Anchors Stockless 40 cwt  
 1 Stream " ex stock 34 "  
 1 Hedge " 5 1/2 "  
 240 fathoms steel chain cable 1 1/2 "  
 75 " Stream 1 1/2 " or 4 1/2 Steel Wire  
 90 " 12 Stamp Towline or 4 Steel Wire  
 40 " Warps 7 (2 off)  
 90 " 6 " "

Frames in Holds  $5 \frac{1}{2} \times 3 \frac{1}{2} \times \frac{1}{20}$  for  $\frac{1}{3}$  L. to  $5 \frac{1}{2} \times 3 \frac{1}{2} \times \frac{1}{20}$  at ends spaced 24' apart  
 " " Peaks  $5 \times 3 \frac{1}{2} \times \frac{1}{20}$  with  $3 \frac{1}{2} \times 3 \frac{1}{2} \times \frac{1}{20}$  Reverse Bars  
 Tank Frames  $3 \frac{1}{2} \times 3 \frac{1}{2} \times \frac{1}{20}$  to  $\frac{1}{20}$   
 Reverse "  $5 \frac{1}{2} \times 3 \frac{1}{2} \times \frac{1}{20}$  for  $\frac{1}{3}$  L. to  $5 \frac{1}{2} \times 3 \frac{1}{2} \times \frac{1}{20}$  at ends.  
 All reverse bars to chain D. Alternate Reverse Bars to Upper Long L. Forecastle D. in Fore Peak  
 Stem frame  $10 \times 6$  to  $10 \times 2 \frac{1}{2}$  at Head Stem  $10 \times 2 \frac{1}{2}$  to  $9 \times 2 \frac{1}{2}$  at Head  
 Rudder Head 8 diam. Steel & Pintles 4 diam.  
 Bulkheads  $\frac{1}{20}$  at bottom,  $\frac{1}{20}$  at top. Stiffeners vertical and horizontal  
 $7 \times 3 \times \frac{1}{20}$  Bull Angles 4'0" apart. Vertical Stiffs fixed to Tank Top  
 Horizontal Stiffeners fixed to Shell  
 All Bulbs & Stringer angles above  $\frac{1}{20}$ , reduced  $\frac{1}{20}$  for  $\frac{1}{3}$  L. at ends

W. GRAY & CO. LIMITED,  
 WEST HARTLEPOOL.


600

600



Wray & Co.  
No. 100.

Friendship Section  
"Helsingborg"  
Hpl. Report no. 11084

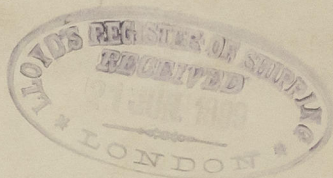

~~Baltia~~

Hedera



© 2020

Lloyd's Register  
Foundation

002215-002221-0129