

# Lloyd's Register of Shipping.

## SURVEYS FOR FREEBOARD.—STEAM SHIPS.

Index No. 317  
(For London Office only.)

16 JUN 1925

PARTICULARS RELATING TO ALL STEAM SHIPS EITHER FLUSH DECKED, OR WITH TOP GALLANT FORECASTLES, SHORT POOPS, AND BRIDGE HOUSES DISCONNECTED, OR TOP GALLANT FORECASTLES HAVING LONG POOPS, OR RAISED QUARTER DECKS CONNECTED WITH BRIDGE HOUSES, OR OTHERWISE.

GLASGOW REPORT No. 446Port of Survey Glasgow.Date of Survey 15th June, 1925.Name of Surveyor E. Brimblecombe.

Ship's Name. <b>M.V. "NAIRNBANK"</b>	Port of Registry and Nationality. <u>Glasgow</u>	Official Number. <u>148867</u>	Gross Tonnage. <u>1924</u>	Date of Build. <u>1924</u>	Particulars of Classification. <b>+100 A1 with freeboard</b> <i>Revised Rules contemplated.</i>
Number in Register Book <u>90086 Sup</u>					

Registered dimensions from Ship's Register.	LENGTH.	BREADTH.	DEPTH.	UNDER DECK TONNAGE.
	<u>420.10</u>	<u>53.90</u>	<u>26.50</u>	<u>470.25</u>
Length on LOADLINE.	<u>419.5</u>	Frame Depth <u>13 1/2</u> Rule " <u>6</u> <u>7 1/2</u>	Ceiling <u>+2.0</u> Sheer <u>+0.98</u>	Peak Tanks
CORRECTED DIMENSIONS.	<u>419.5</u>	<u>52.65</u>	<u>27.68</u>	<u>4768.25</u>

Co-efficient of fineness..... .78  
Any modification necessary [Para. 4 (a) to (e)]\* B.S.B.  
Co-efficient as corrected ..... .76

Sheer { Stem..... 120.0  
at { Sternpost ... 48.0 }  $168 \div 2 = 84$  ... Mean 87.27  
51.95  
36.35  
.98

Sheer at  $\frac{1}{8}$  of the length from { Stem 71  
Sternpost 25 }  $96 \div 2 = 48$  ... Mean 85.63  
 $\div .55 = 87.27$

Gradual mean Sheer ..... 85.63  
Standard mean Sheer [Table, Para. 18] ..... 51.95  
Difference..... 33.68  $\div 4 = 8.42$   
§ If limited as Para. 18 (f) ..... -8 1/2

Rise in Sheer { At front of bridge house.....  
from amidships { At after end of forecastle ..... ✓

Fall in Sheer { 13 1/4  $\div 2 =$   
Para. 18 (d) {  
Length uncovered ..... ✓

Correction

## ALLOWANCE FOR DECK ERECTIONS:—

Freeboard, Table C..... 4-0 1/4  
Correction for Length, if required (Para. 12, 13, and 14) ..... ✓

Freeboard by Table A, corrected for sheer, and for length, if required (Para. 12, 13, and 14) ..... 6-5 3/4  
Difference ..... 2-5 1/2  
Percentage as below..... 94.36  
27.68

Correction for R. Q. Dk. if engine and boiler openings not covered by bridge house (Para. 11) ..... 2 1/2

Allowance for Deck Erections ..... - 2 1/2

	Length.	Length allowed.	Height.
Forecastle.....	<u>390.71</u>	<u>390.71</u>	<u>8.0</u>
Bridge House.....	<u>5.25</u>		
Raised Qr. Dk.....			
Poop.....	<u>23.54</u>	<u>23.54</u>	<u>8.0</u>
Total .....	<u>419.50</u>	<u>414.25</u>	
		<u>2.62</u>	
Length of Ship .....		<u>416.87</u>	
Corresponding percentage (Para. 11, 12, 13, or 14) <u>94.36</u>		<u>419.50 = .9936</u>	

FREEBOARD recommended amidships from centre of Disc to top of Statutory Deck Line, Wood (Steel) Deck:—

Fresh Water Line	above centre of Disc	...
Indian Summer Line	" "	...
Winter Line	below " "	...
Winter North Atlantic Line	" "	...

† If the frames, skin planking, or ceiling are of unusual thickness the breadth of vessel to inside of ceiling should be reported if possible.  
† In vessels obtaining an allowance for deck erections under Para. 11 where the sheer drops abaft amidships the height of the R.Q.D. is to be taken from the level of the top of the amidship beam.  
† In flush-decked vessels the total standard mean sheer means the sheer measured at the stem and sternpost. In vessels having poops and forecastles, it means the sheer measured at points distant one-eighth of the vessel's length from stem and sternpost.

Moulded Depth as measured..... 29 1/2"

Addition for Keel below base line for draught record..... inches.

NOTE.— If the depth is measured when vessel is afloat, the details of measurement should be reported.

## CORRECTION FOR LENGTH.

Length of Ship on Loadline..... 419.5  
Length in Table ..... 350.0  
Difference ..... 69.5  
Correction for 10ft., Table A. .... 1.5 Table C.  
× Difference divided by 10 ..... 10.42 (if required.)  
If  $\frac{1}{10}$  this length covered divide by 2 5.21 +5 1/4"

## CORRECTION FOR IRON DECK.

Proportion covered, if less than  $\frac{7}{10}$  this length covered .....  
Thickness of iron deck, less stringer ..... -3 1/2"

## CORRECTION FOR ROUND OF BEAM.

Breadth at Gunwale amidships..... 53.08  
Round of Beam ..... 133  
Normal round..... 13.27  
Difference ..... 27  $\div 2 = 13.5  
Proportion of Deck uncovered (Para. 19) ..... Corrected$

NOTE.— The round of beam should be reported on the full breadth of vessel at the gunwale.

Freeboard, Table A .....  
Correction for Sheer .....  
Correction for Length ..... + 6  
Allowance for Deck Erections ..... - 2  
Correction for Round of Beam..... ✓  
Correction for fall in Sheer (if any)..... ✓  
Correction for Steel Deck (if required) ..... - 3 1/2  
Additions for non-compliance with provisions of Para. 11 (d) and (e) † .....  
Other Corrections (if any) .....

Winter Freeboard ..... 4-4 3/4  
Summer Freeboard ..... 3-10 9/16  
Indian Summer Freeboard ..... 3-4 3/4  
N. A. Winter Freeboard ..... ✓

Correction necessary because clearsides amidships, measured in accordance with the Statute is not taken at the intersection of the wood or steel deck with side. + 1 3/4

Winter Freeboard from deck line ..... 4-5 1/2  
Summer " " " " ..... 3-11 1/2  
Indian Summer " " " " ..... 3-  
N. A. Winter " " " " ..... ✓

Winter Freeboard from deck line ..... 3-11 1/2

Summer " " " " ..... 6 1/2

Indian Summer " " " " ..... 6

N. A. Winter " " " " ..... 6

† State dimensions of freeing port area on back of this form.

† The Surveyor should state whether the fall in sheer as reported is measured relatively to the strake line of keel or to the water line. If measured relatively to water line the vessel's draft at time of survey, and also the usual load draft forward and aft should be reported.

RECEIVED

17 JUN 1925

© 2021

Lloyd's Register  
MARKING FOR  
FOLIO 10  
FOUNDATION



All the Frames extend to the top height in the Poop? ☒ *Yes* Raised Quarter Deck ☒ Bridge House? ☒ *Yes* Forecastle? ☒ *Yes*  
 To what height do the Reverse Frames extend? *2nd deck*  
 Has the Poop or Raised Quarter Deck an efficient Iron Bulkhead at the fore end? ☒ *Yes*  
 Give particulars of the means for closing the openings in Bulkhead ☒ *Shifting Boards in riveted channels full height*  
 Is the Poop or Raised Quarter Deck connected with the Bridge House? ☒ Has the Bridge House an efficient Bulkhead at the fore end? ☒  
 Give particulars of the means for closing the openings in Bulkhead ☒  
 What is the thickness of the Bridge Front plating? ☒ and Coaming plate? ☒  
 Give scantlings and spacing of the Stiffeners ☒  
 Are bracket plates fitted at each end of the Stiffeners? ☒ Are hor'l. brackets fitted connecting Bridge Bulk'd. with Bulwarks? ☒  
 Has the Bridge House an efficient Iron Bulkhead at the after end? ☒ *Yes*  
 How are the openings closed? ☒ *Shifting Board in riveted channels full height*  
 Is the Forecastle at least as high as the main or top-gallant rail? ☒ Has the Forecastle an efficient Iron or Wood Bulk'd. at after end? ☒  
 Are the Engine and Boiler openings covered by a Bridge, Poop, Raised Quarter Deck, or enclosed by a Strong Iron or Steel Deckhouse? ☒ *Steel deckhouse on upper decks.*  
 If the openings are not so protected are the exposed parts of the Casings efficiently constructed? ☒  
 Give thickness of plating; scantlings and spacing of Stiffeners ☒  
 What is the height of the exposed Casings? ☒ Are suitable means provided for closing all openings in them in bad weather? ☒  
 Are the Weather Deck Hatchways efficiently constructed and at least equal to the requirements of Section 28 of the Rules for 1904-5? Give particulars below:— ☒ *Yes*

Position and Size.		No. 1. 27'-0" x 22'-0"		No. 2. 31'-6" x 22'-0"		No. 3. 28'-10 1/2" x 22'-0"		No. 4. 5'6" x 22'-0"			
Item.		Ship.	Rule.	Ship.	Rule.	Ship.	Rule.	Ship.	Rule.	Ship.	Rule.
COAMING.	Height above top of DECK	30"	24"	30"	24"	30"	18"	30"	18"		
	Sides	above wood dk	.44	above wood dk	.44	above wood dk	.44	above wood dk	.44		
	Ends	.44	.44	.44	.44	.44	.44	.44	.44		
SHIFTING BEAMS OR WEB PLATES.	Number	5	5	5	5	5	5	4	4		
	Section and Scantlings	Plate 17 1/2 x .36	17 1/2 x .36	20 x .37	20 x .37	14 x .34	14 x .34	14 3/4 x .34	14 3/4 x .34		
	Material	Steel	Steel	Steel	Steel	Steel	Steel	Steel	Steel		
* FORE AND AFTERS.	Number										
	Section and Scantlings	none	none	none	none	none	none	none	none		
	Material										
HATCHES Thickness		2 1/2	2 1/2	2 1/2	2 1/2	2 1/2	2 1/2	2 1/2	2 1/2		
Remarks											

\* The depth of Fore and Afters should be stated from the underside of the hatches in all cases.

(If the sill of the lowest side scuttle will be less than 6 inches above the Indian Summer Load Line if assigned under the tables, state vertical distance from top of deck at side amidships to lower edge of lowest side scuttle.)

wing information is to be given in all cases of vessels dealt with under Paras. 11, 12 (under 15 feet Moulded depth) and under Shelter Deck Rules.  
 the thickness of the Bridge Sheerstrake? Strake between Main and Bridge Sheerstrakes?


Delete the words { The Crew are, are not, berthed in the bridge house.  
 that do not apply { The arrangements to enable them to get backwards and forwards from their quarters are, are not satisfactory.

Length of Bulwarks in well

Area of Freeing Ports required by Para. 11 (e) each side of vessel = Sq. ft.

Ft.	Tenths.	Ft.	Tenths.	No.	Freeing Ports (each side of vessel)	=	Sq. ft.
x		x					
x		x					

Total deficiency or excess = Sq. ft.

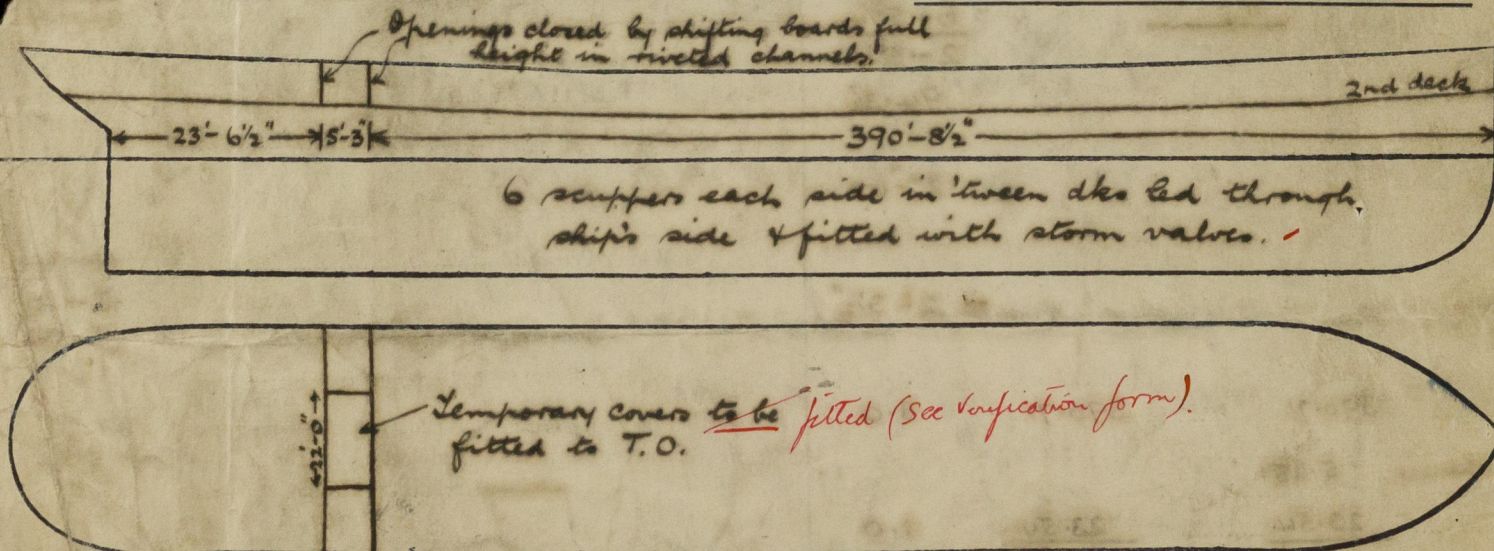

Show hereon line of Floors or Tank Top with position of any Breaks in same; also height of Peak Tank tops, &c., &c.

Special features in the construction of the Vessel *Request form attached.*


Name and yard number *Messrs Harland & Wolff, Ltd. Yard No 679 G.*

Register vessels *M.V's Inverbank, Glenbank, Birchbank, Cedarbank, Bonliebank, Clydebank,*  
*Alynbank, Elmbank, Forresbank.*  
 Messrs *Andrew Weir & Co.*

Address

Received by me

*See 76 Rpt.*

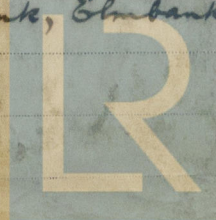

Lloyd's Register  
Foundation