


Beardmore's No 554

Mr. Craig
Mr. Fletcher

The arms could be
approved as made.

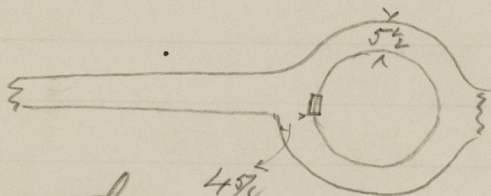

L.

as measured by Mr. Fletcher.

Mr
28/10/19



© 2021

Lloyd's Register
Foundation

002229-002231B-0134