

3. 6. 91
12/6/91.
19. 6. 91.
23. 6. 91
1. 7. 91.

DIMENSIONS

$\frac{1}{2}$ GIRTH-----43.323

$\frac{1}{2}$ BREADTH 21.5

DEPTH 26.125

$$\frac{90.958}{F.N} \times 258 = \frac{23,462}{P.N} \cdot 10 + \frac{15}{EQUIP.N} = 25029.44$$


PROPORTIONS

DEPTH S IN LENGTH 9.87

BREADTHS " " 6.0

TO CLASS 100 A.1 AT LLOYDS.

3	BOWERS	108 $\frac{7}{8}$	CWTS EX STOCK
1	STREAM	11 $\frac{1}{2}$	" " "
1	KEDGE	5 $\frac{3}{4}$	" " "
1	"	2 $\frac{3}{4}$	" " "
270	FATHOMS	2	STUD CHAIN CABLE
75	"	1 $\frac{1}{2}$	STREAM CHAIN
90	"	12	TOWLINE
90	"	11"	HAWSER
90	"	7	WARP.

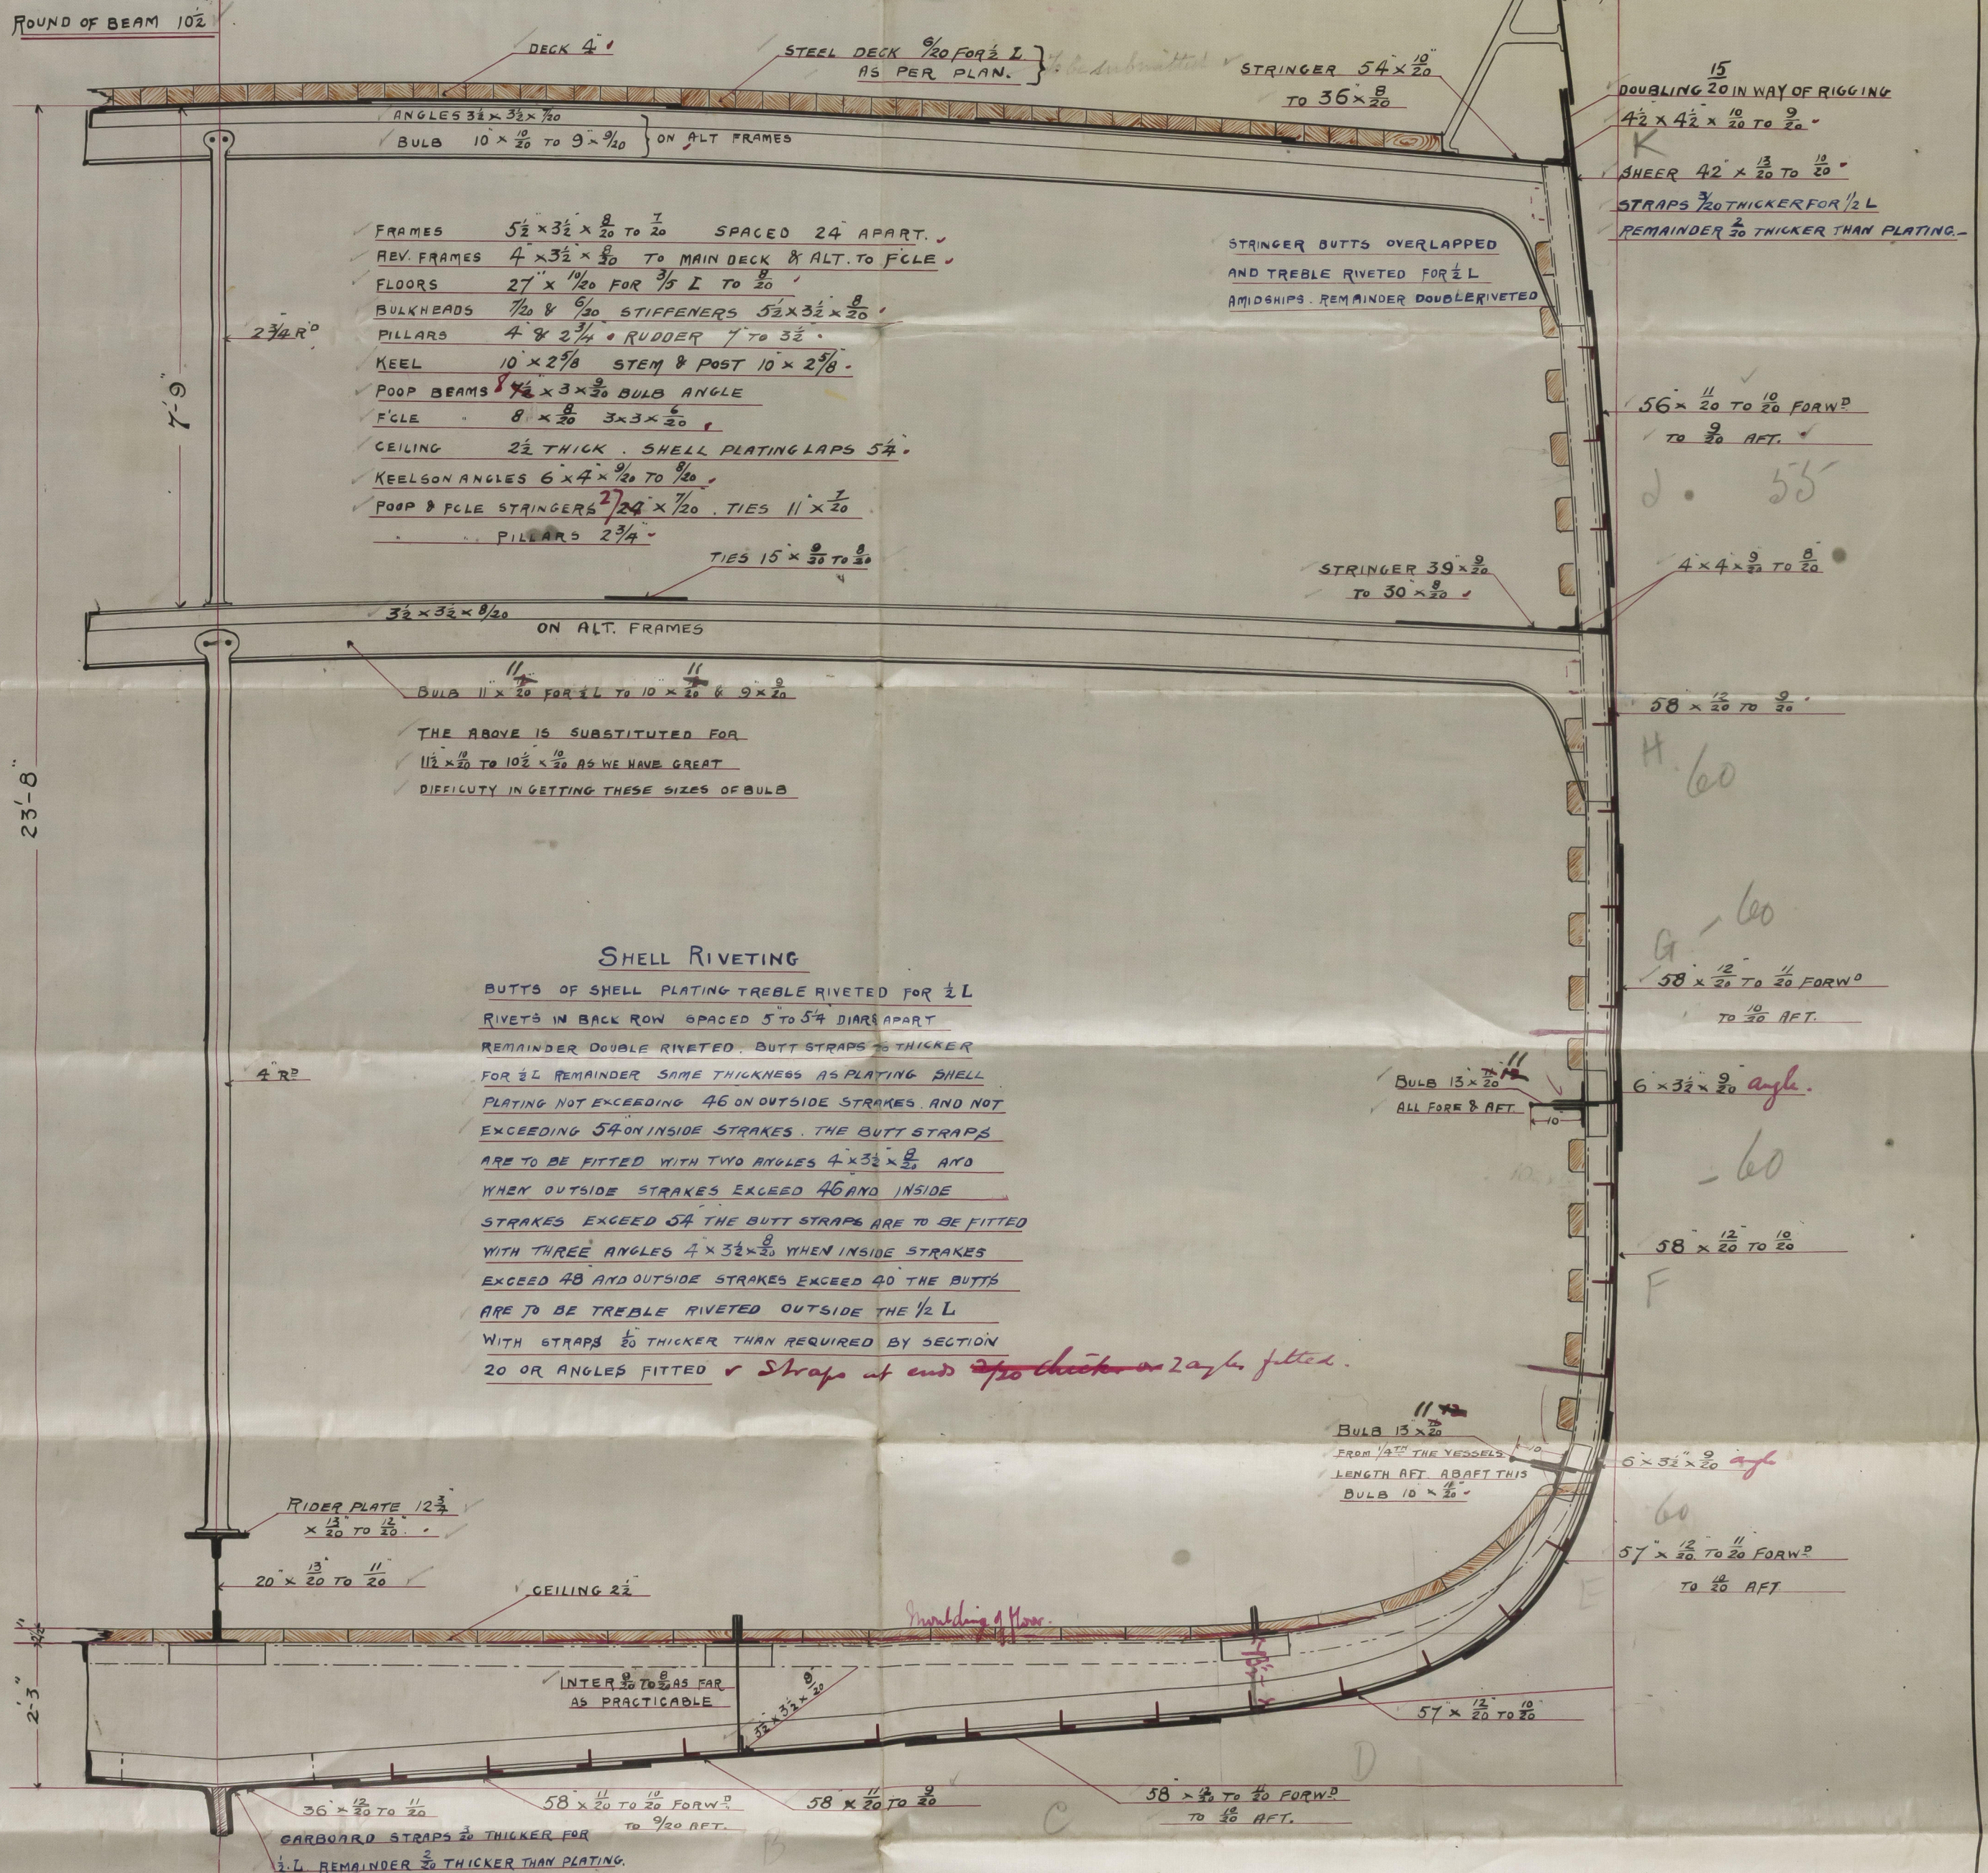


30/5/91.

J. L. Gls. 1.5.91

Lloyd's Register
Foundation

"Bk. Hawaiian Isles" Glasgow Report No. 11319.



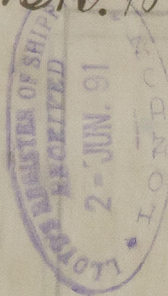



— 810 N 184 —

002232-002240-0186


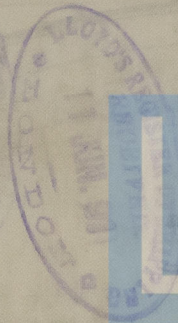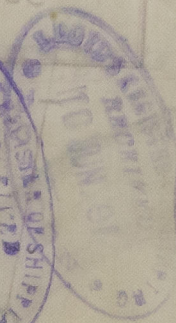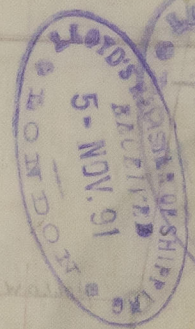

© 2020

Lloyd's Register
Foundation