



T. S. S. No 492.

600'-0" (ON L.W.L.) x 73'-6" x 45'-0" MOULDED TO SHELTER DECK.

PROFILE.

SCALE 1/8" = 1 FOOT.

*Stiffens between upper & shelter deck connected by struts to Boundary Bars where shown & main stiffens and lower main deck connected by large lip struts where shown & stiffens brackets of struts as per Rules Sec. 17, para 10. Transverse brackets at W.T. Bulkheads as per Rules Sec. 17, para 10. Plating is similar to that shown on page 9, Table 105.*

 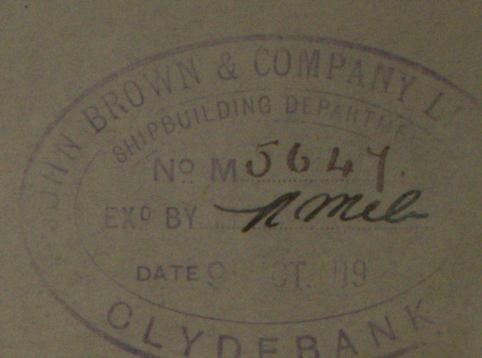

APPROVED  
LLOYD'S REGISTER OF SHIPPING  
18th 10 19



Profile

No. H-92

Known BB-L<sup>5</sup>

Sp - Iranconia

GLASGOW REPORT No. 42777

002241-002248-0002



© 2020

Lloyd's Register  
Foundation