








Midship Section

Builds Number 74.






N.N. Kylecraft

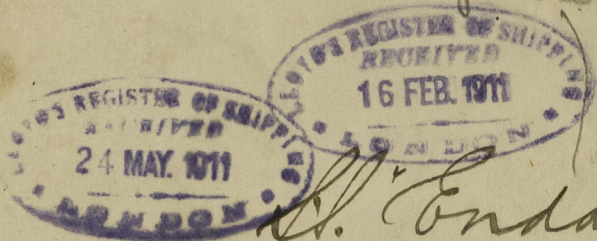

W. Enda

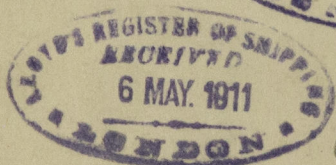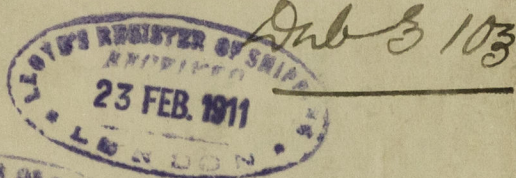

Kylecraft

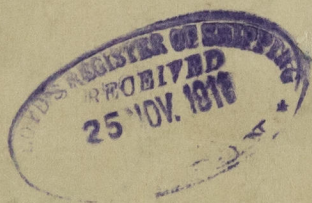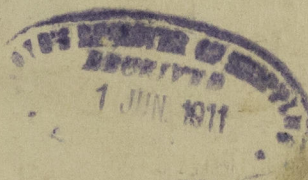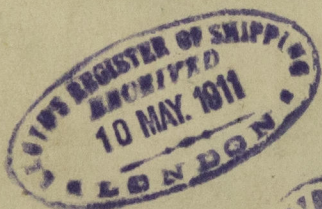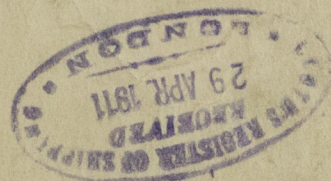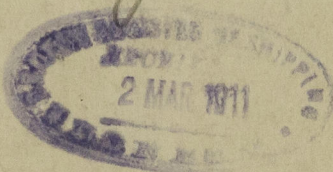

© 2021

Lloyd's Register  
Foundation

002269 002278-0004