


27/11/29

STEEL MIZZEN MAST
SUPPORTED TO SURVEYORS
SATISFACTION.

P. PINE FORECAST
SUPPORTED TO SURVEYORS
SATISFACTION.


WHALEBACK { PLATING .31
STIFF^{ES} 4" x 3" x .38 SPACED 30" APART.
£ BRACKETED TO DECK

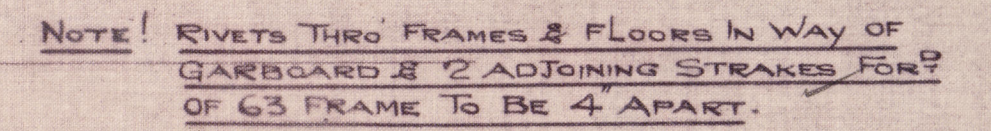

COOK WELTON & GEMMELL LTD.
SHIPBUILDERS.
BEVERLEY.

Cook, Welton & Gemmell
Beverley

Profile & Deck
Nos. 539-40-41

"Kingston Olivine" ⁵³⁹ 

S.S.

HULL REPORT NO. 40742.

"Kingston Coral" ⁵⁴⁰

S.S.

HULL REPORT NO. 40842.

~~Dis class Bay 205~~

~~Seet 1~~



© 2021

Lloyd's Register
Foundation

002269-002278-0101