

EQUIPMENT

HULL NUMBER 4522-50
 QUARTER DECK 495' 3" 5" 173' 25"
 FORECASTLE DECK 21' 6" 5" 75" 102' 37"
 BRIDGE DECK 8' 75" 7" 75" 45' 93"
 DECK HOUSE 43' 75" 65" 5" 142' 16"
 2 BOWER ANCHORS 8 1/4 CWTs EACH STOCKLESS
 1 STREAM ANCHOR 23 1/2 EX. STOCK
 1 KEDGE ANCHOR 1 EX. STOCK
 165 FMS. 1 1/2" STUD LINK CABLE
 45 FMS. 2 1/4" STEEL WIRE FOR STREAM CHAIN
 75 FMS. 7" HEMP TOWLINE
 90 FMS. 5" HEMP HAWSER OR 1 3/4" WIRE
 90 FMS. 5" HEMP WARP OR 1 1/2" WIRE

PLAN No. 350.

FOR ENCLOSURE TO

FROM
 COCHRANE & SONS, LTD.
 SHIPBUILDERS, SELBY
 DATE 6/1/16

MIDSHIP SECTION
 STEEL SCREW STEAMER

No 729 & 730

135' 0" BR * 23' 0" MLD * 10' 6" MLD TO MAIN DK



140' R. & D.

TO CLASS 100.A.1.

SCALE 2 IN. = 1 FT.

NUMERALS

TRANSVERSE = 23' 10" 5" 33' 50"
 LONGITUDINAL = 33' 5" 135' 45' 22' 50"
 DEPTHS IN LENGTH TO MAIN DECK = 12' 85"
 DEPTHS IN LENGTH TO Q.R. DECK = 9' 6"
 BREADTHS IN LENGTH = 5' 86"
 DEPTH "d" TO MAIN DECK = 9' 25"
 DEPTH "d" TO Q.R. DECK = 12' 84"

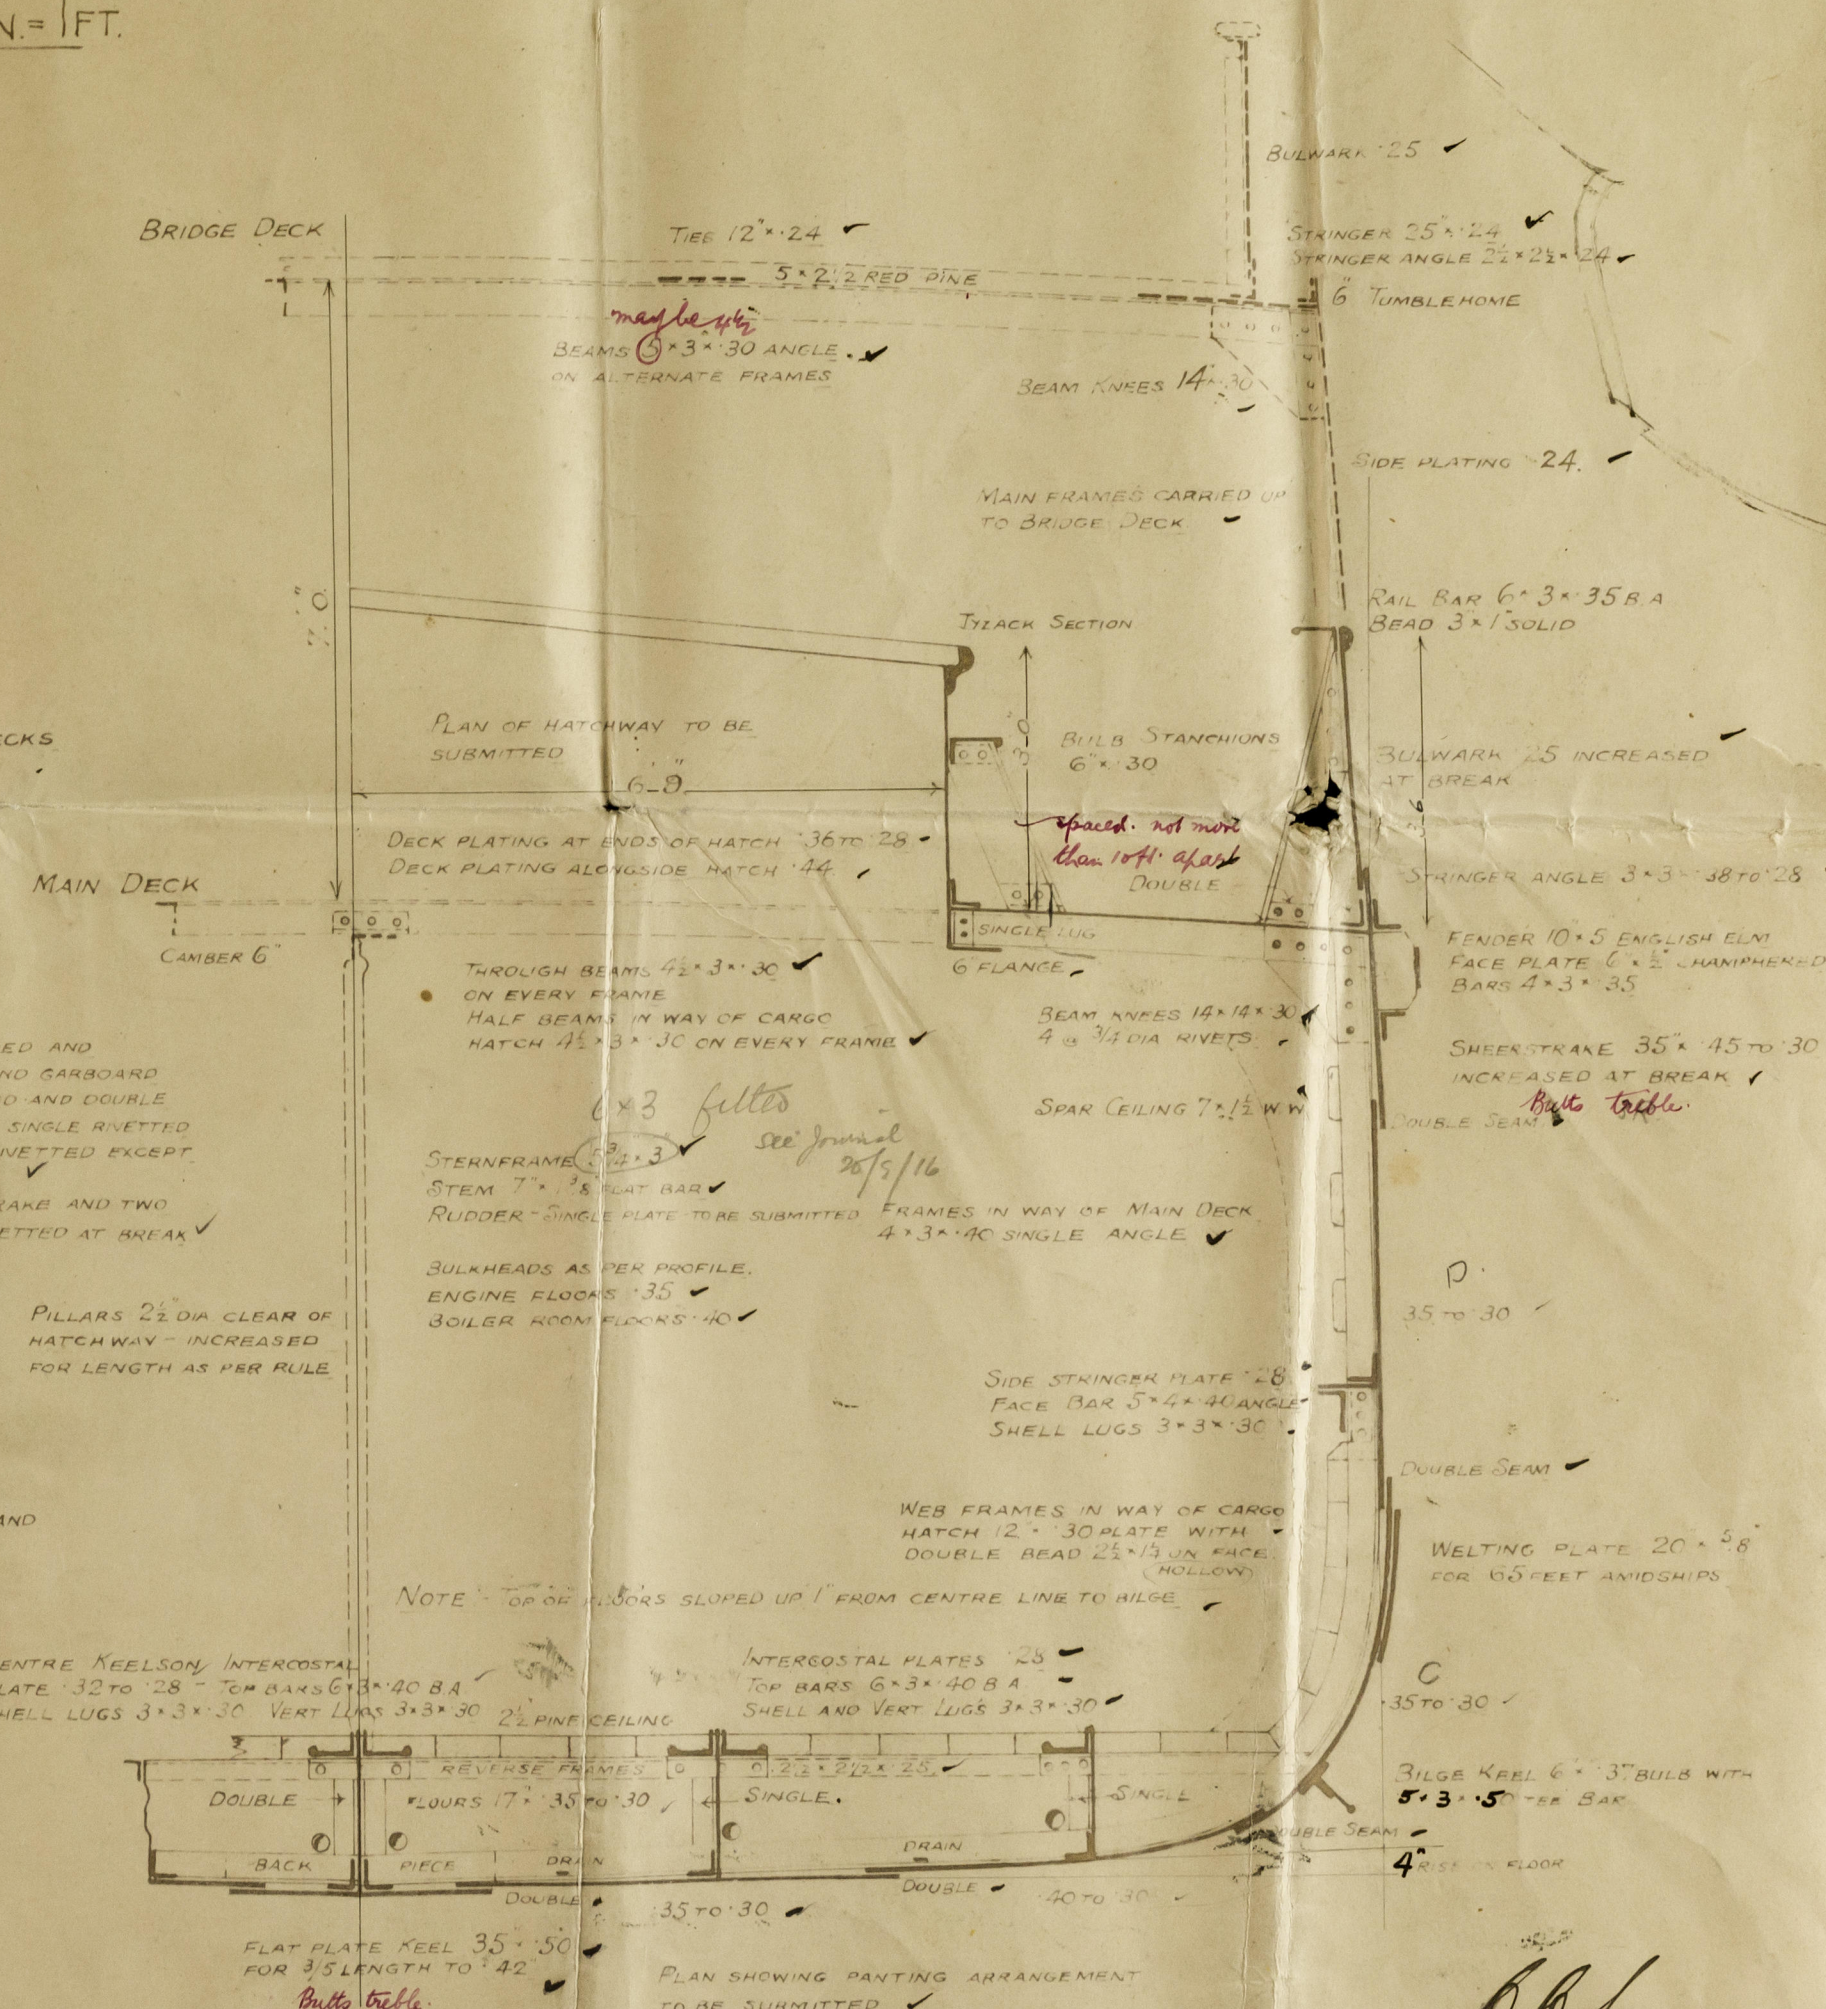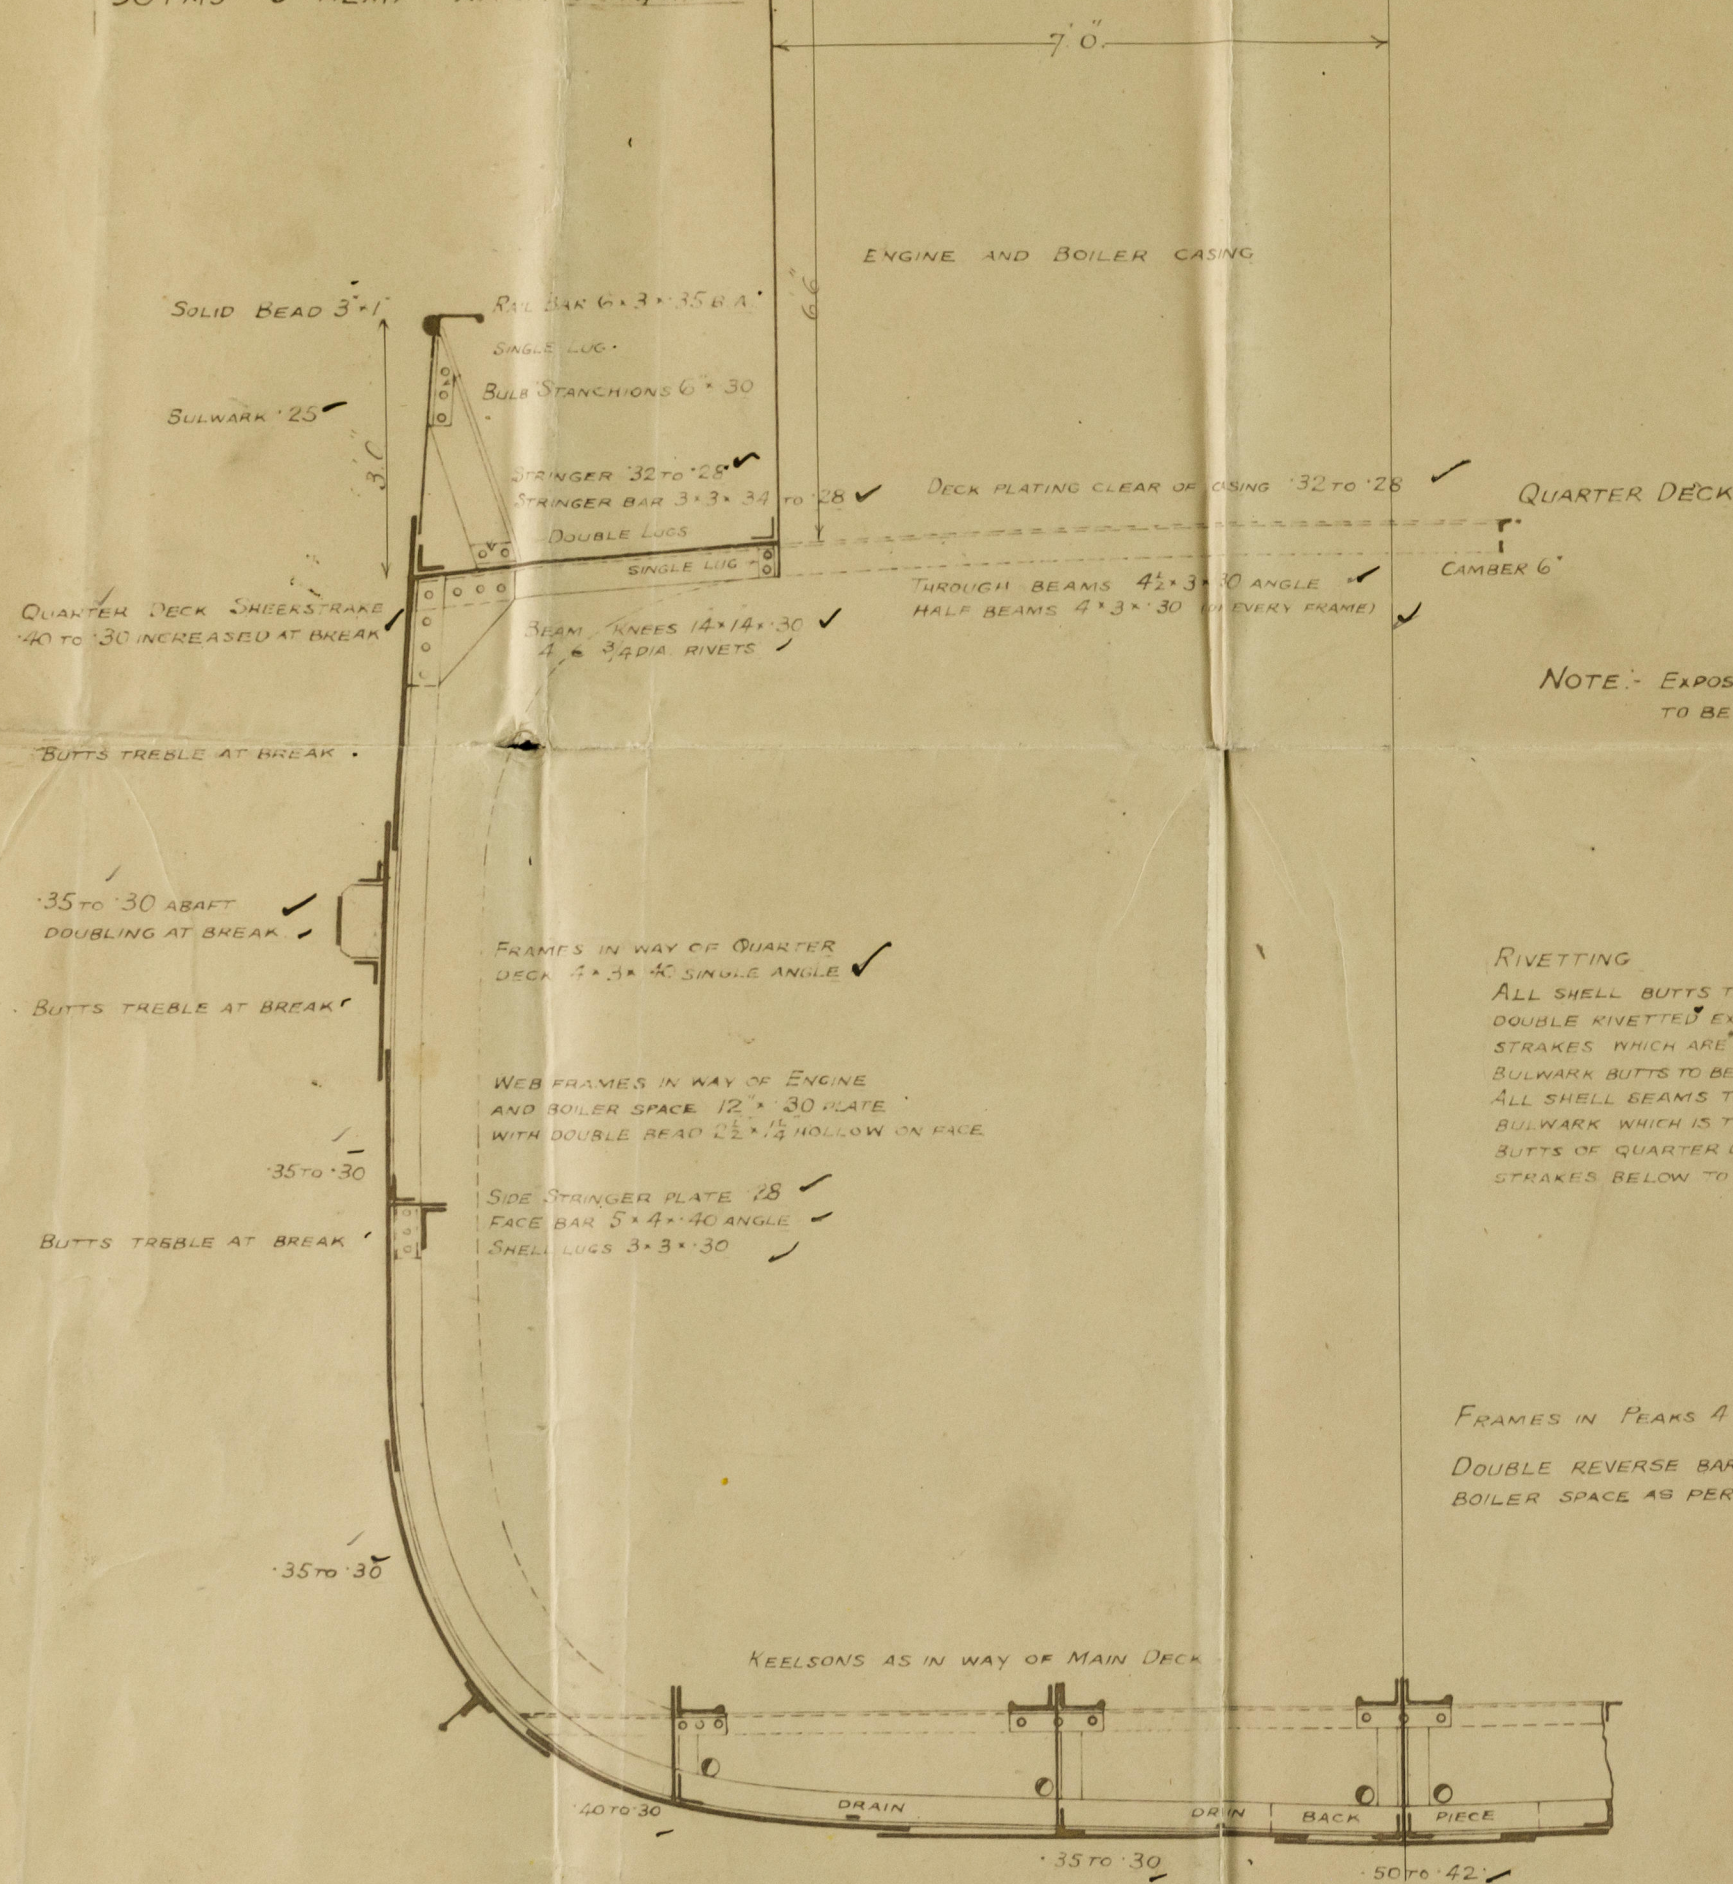

21. 7. 16.

© 2021

Lloyd's Register
Foundation

002269-002278-0182

S.S. Lithium Hull Feb Rpt No
29783.

S.S. Helium Hull Feb Rpt No 29848.


N.N

Mayden



Messrs Cochrane & Sons Ltd.

S/S. No 729.

Midship Section

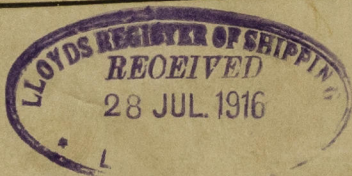


S/S Lithium Hull report No 29858

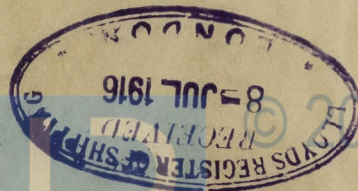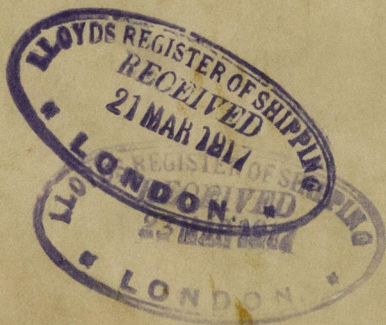

002269-002278-0182



Lloyd's Register
Foundation

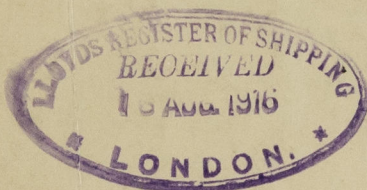

002269-002278-0182



© 2021

Lloyd's Register
Foundation