


S.S. NOS 7 & 8

124'-6" x 22'-0" x 10'-0" MLD.

PROFILE & DECK PLAN

SCALE 1/4" = 1 FOOT

TO CLASS ± 100 A.I. LLOYDS

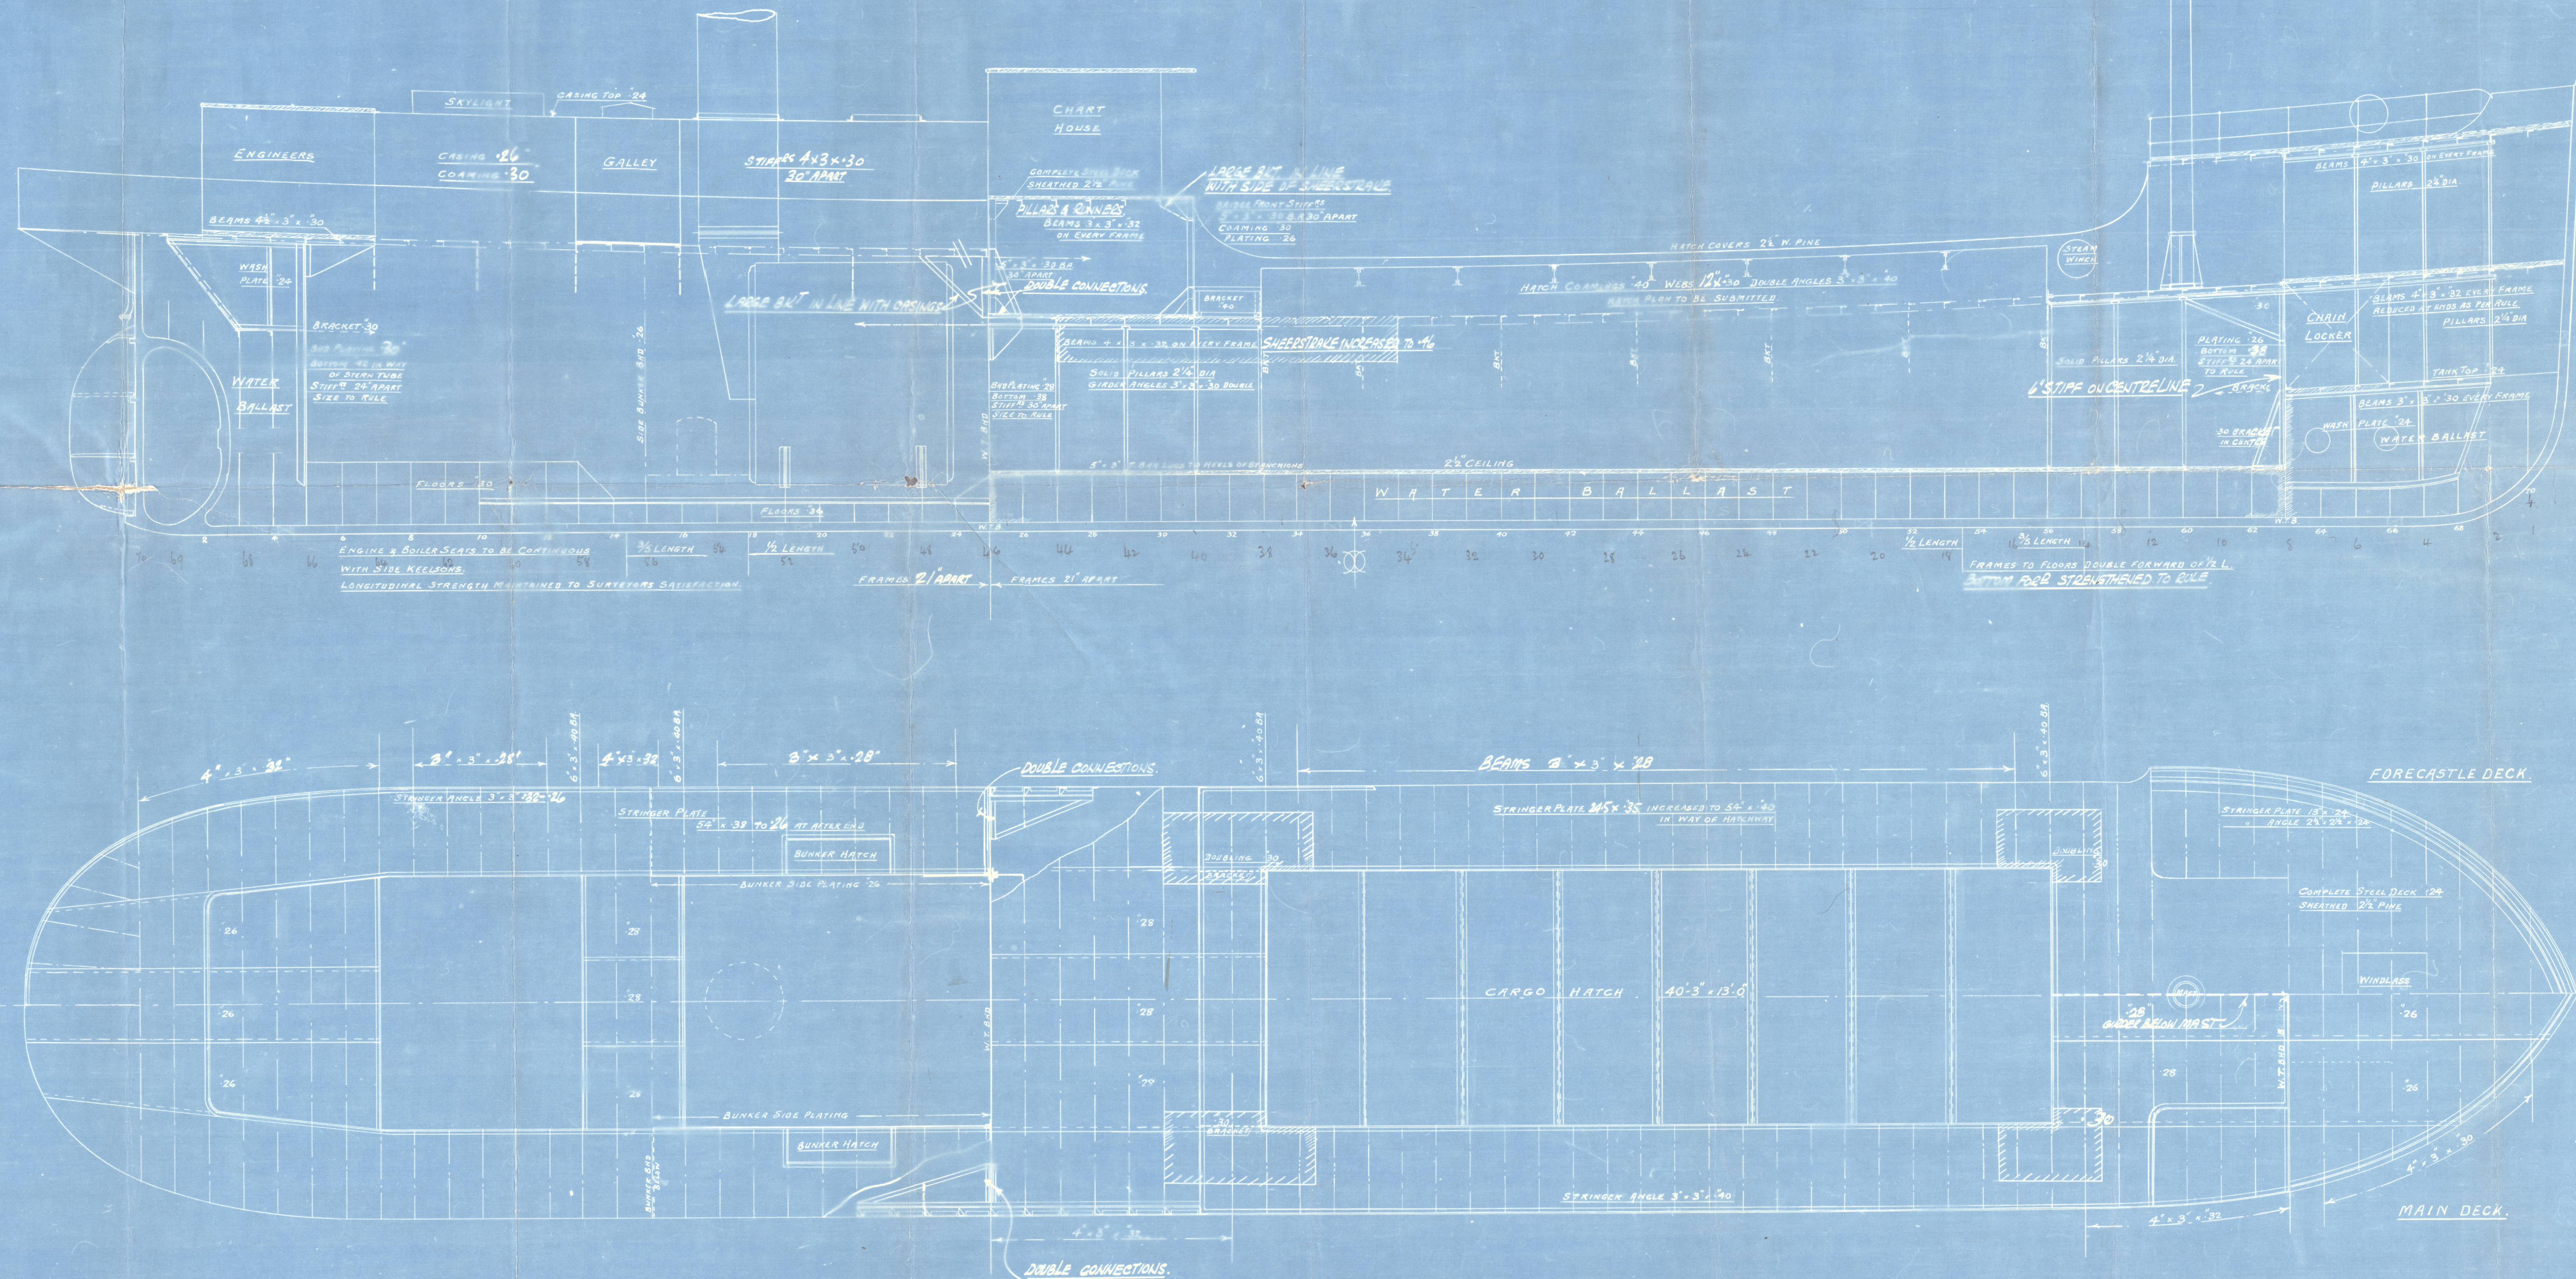



© 2020

Lloyd's Register
Foundation

002289-002297-0137

7/8.

~~Gen. Doc 3981.~~

Denwick Head

"
Wheatblade"

N / N' MOREFIELD'

Profile and Deck



© 2020

Lloyd's Register
Foundation

002289-002297-0137