

19.9.19

VICKERS No 573-4-5

BEARDMORES No 616-17.

TWIN SCREW STEAMERS FOR THE COMMONWEALTH GOVERNMENT.

DIMENSIONS 530'-0" BP x 68'-0" MLD x 43'-6" MLD to 'B' SHELTER DK.


## DECK PLANS

SCALE 1/8" = 1 FOOT.


CLASS 100A.1 LLOYD'S SHELTER DK SPECIAL SURVEY

SHEET No. 1.


### A DECK

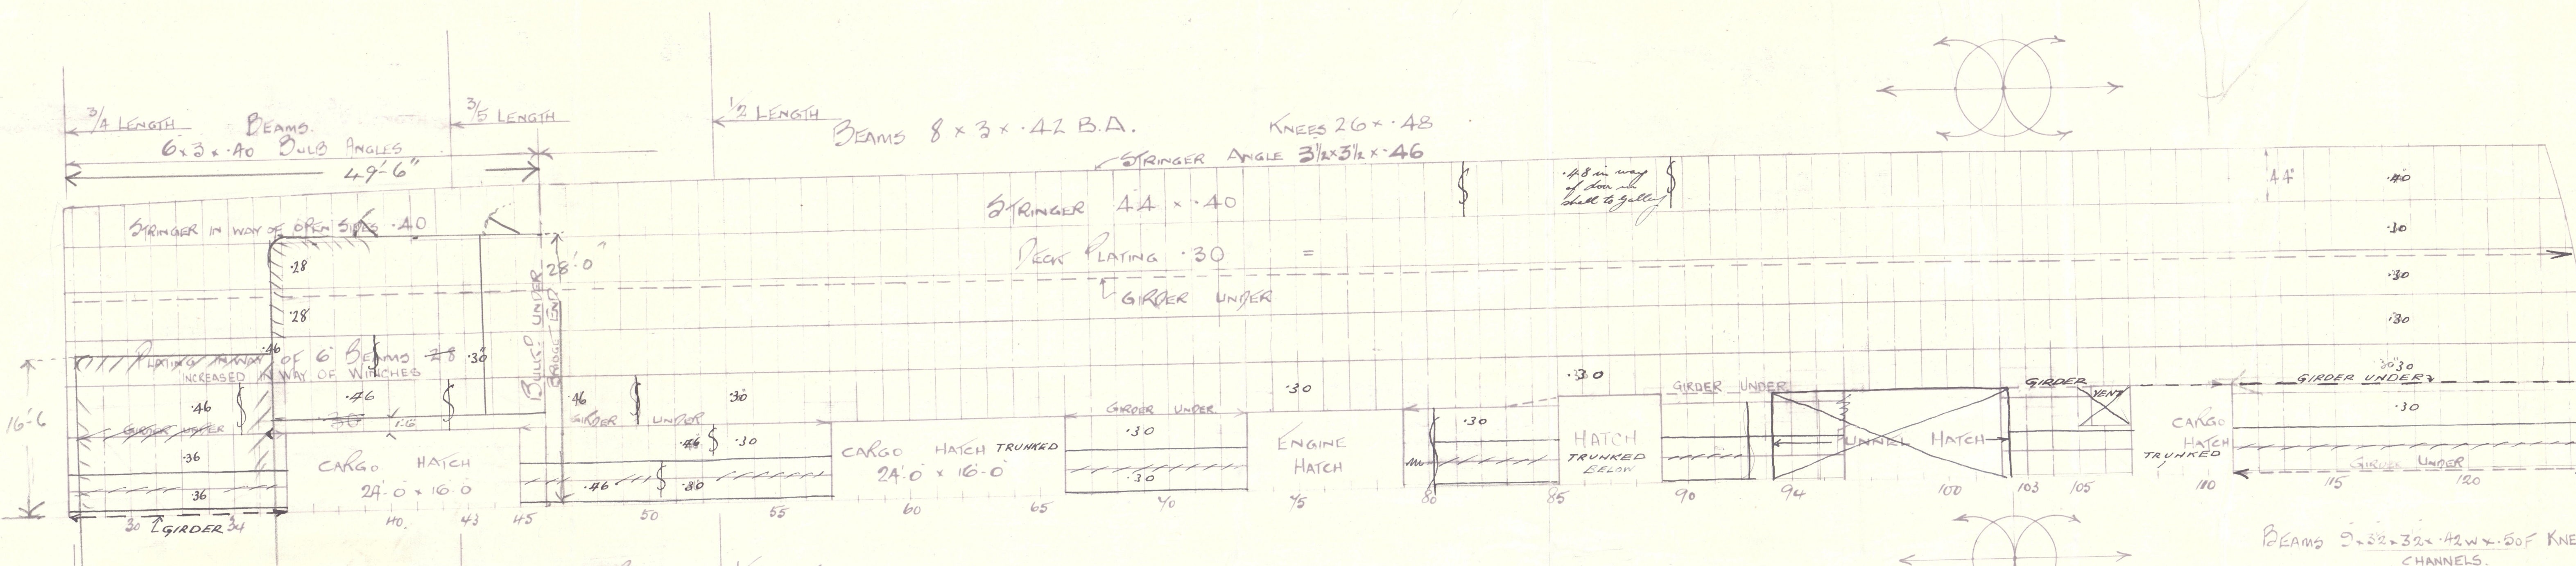


### A DECK

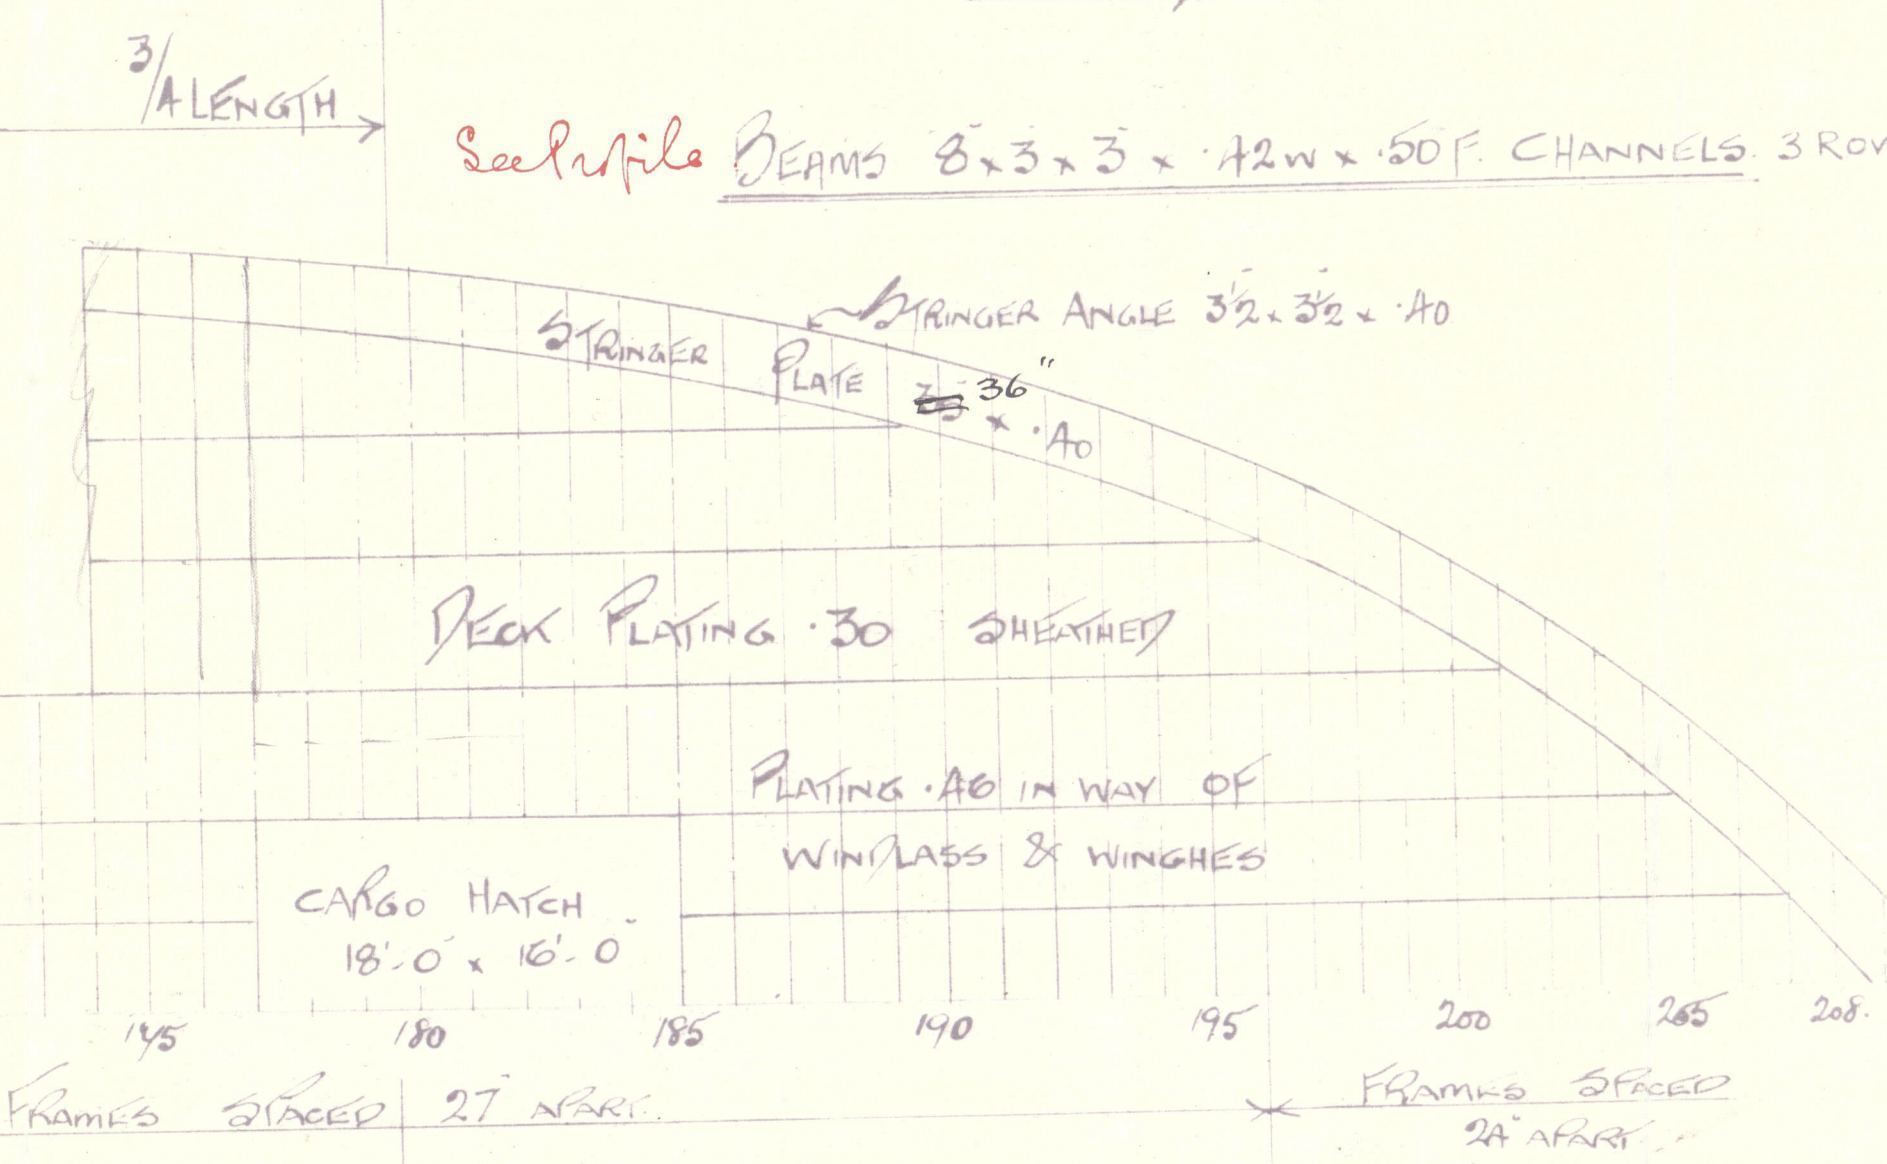


### B DECK

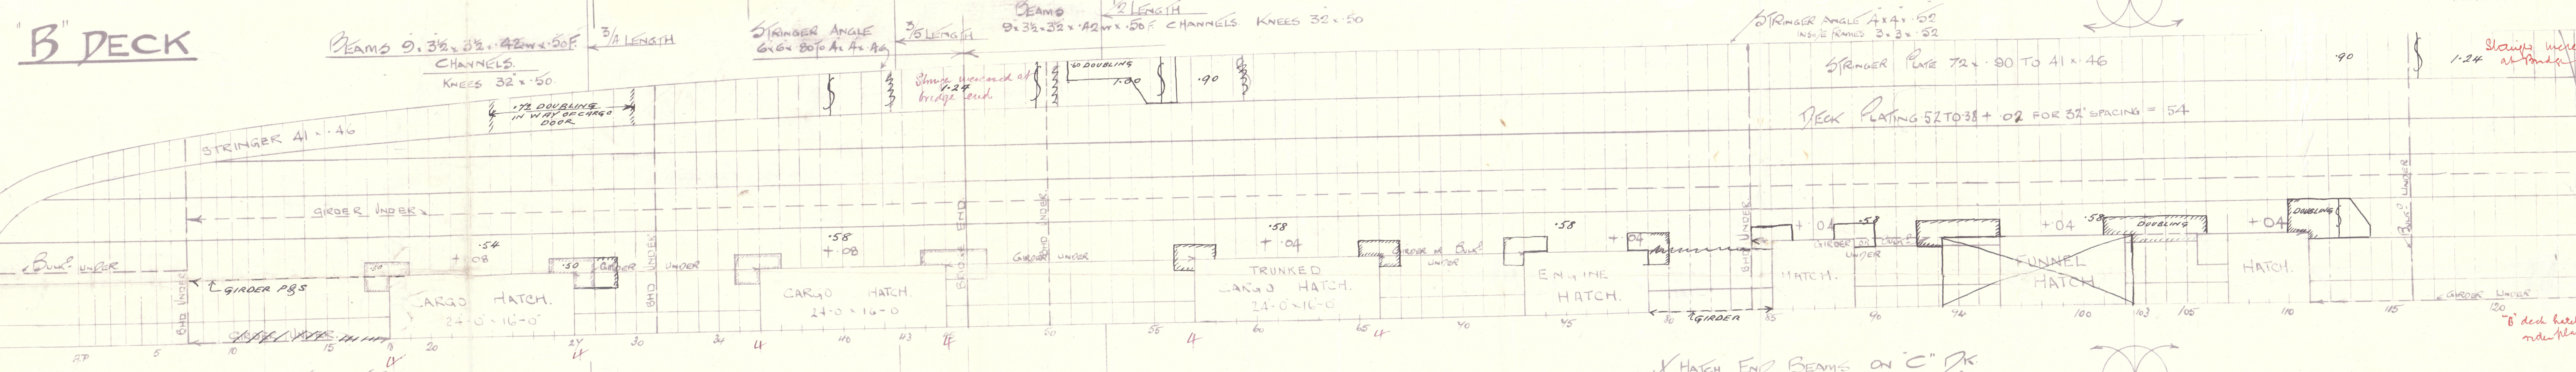


### B DECK

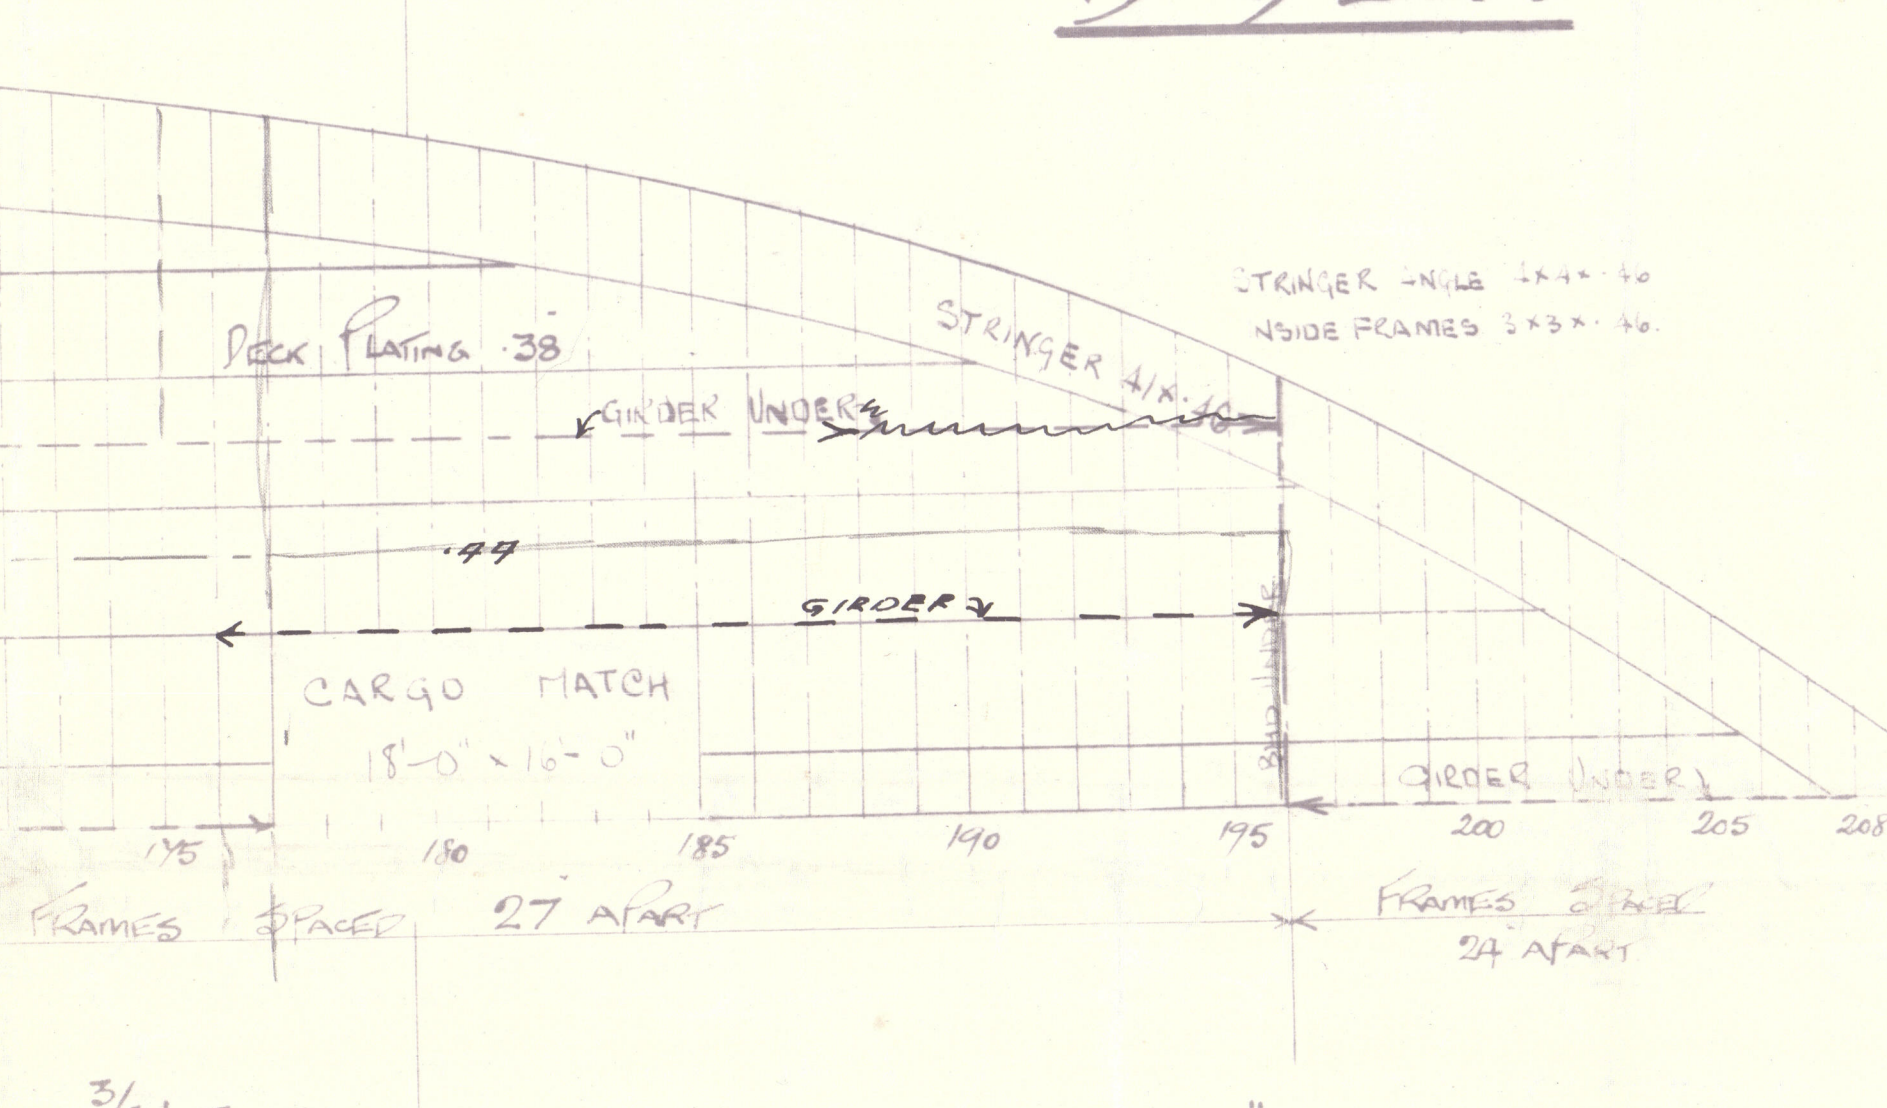


### C DECK

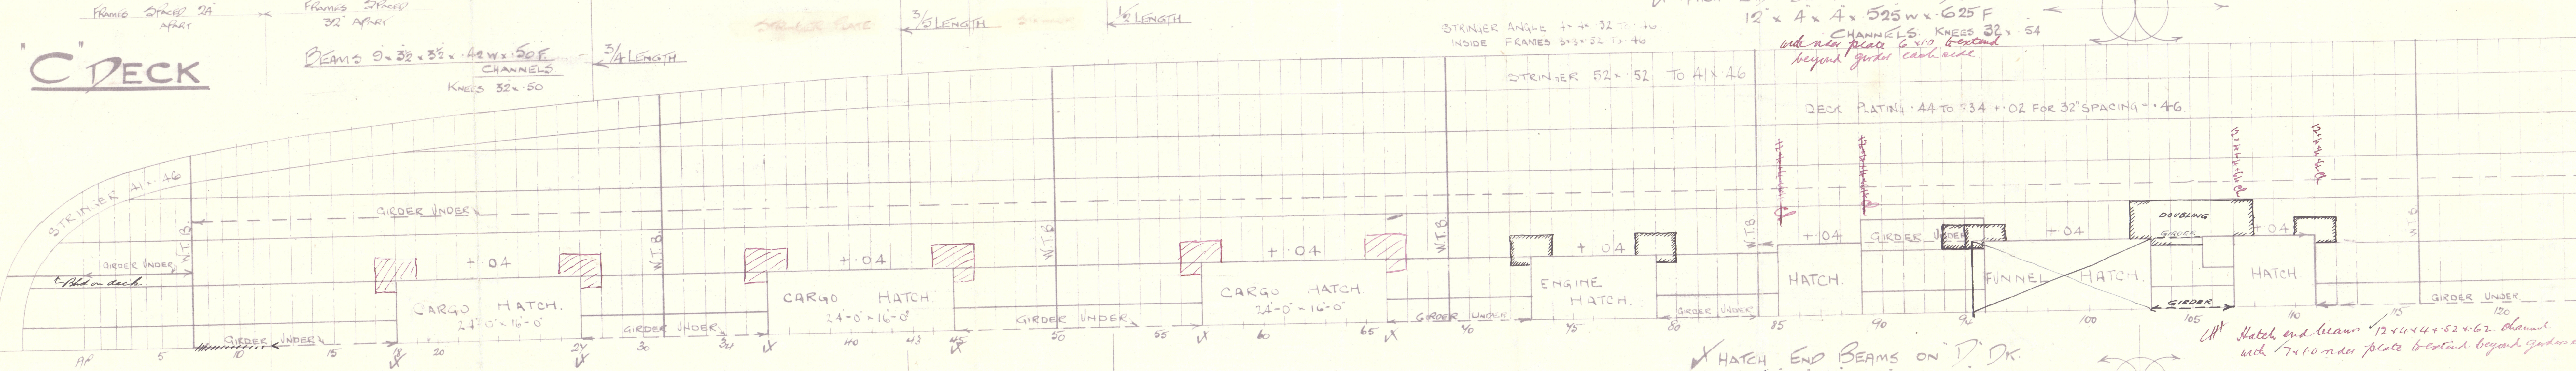


### C DECK

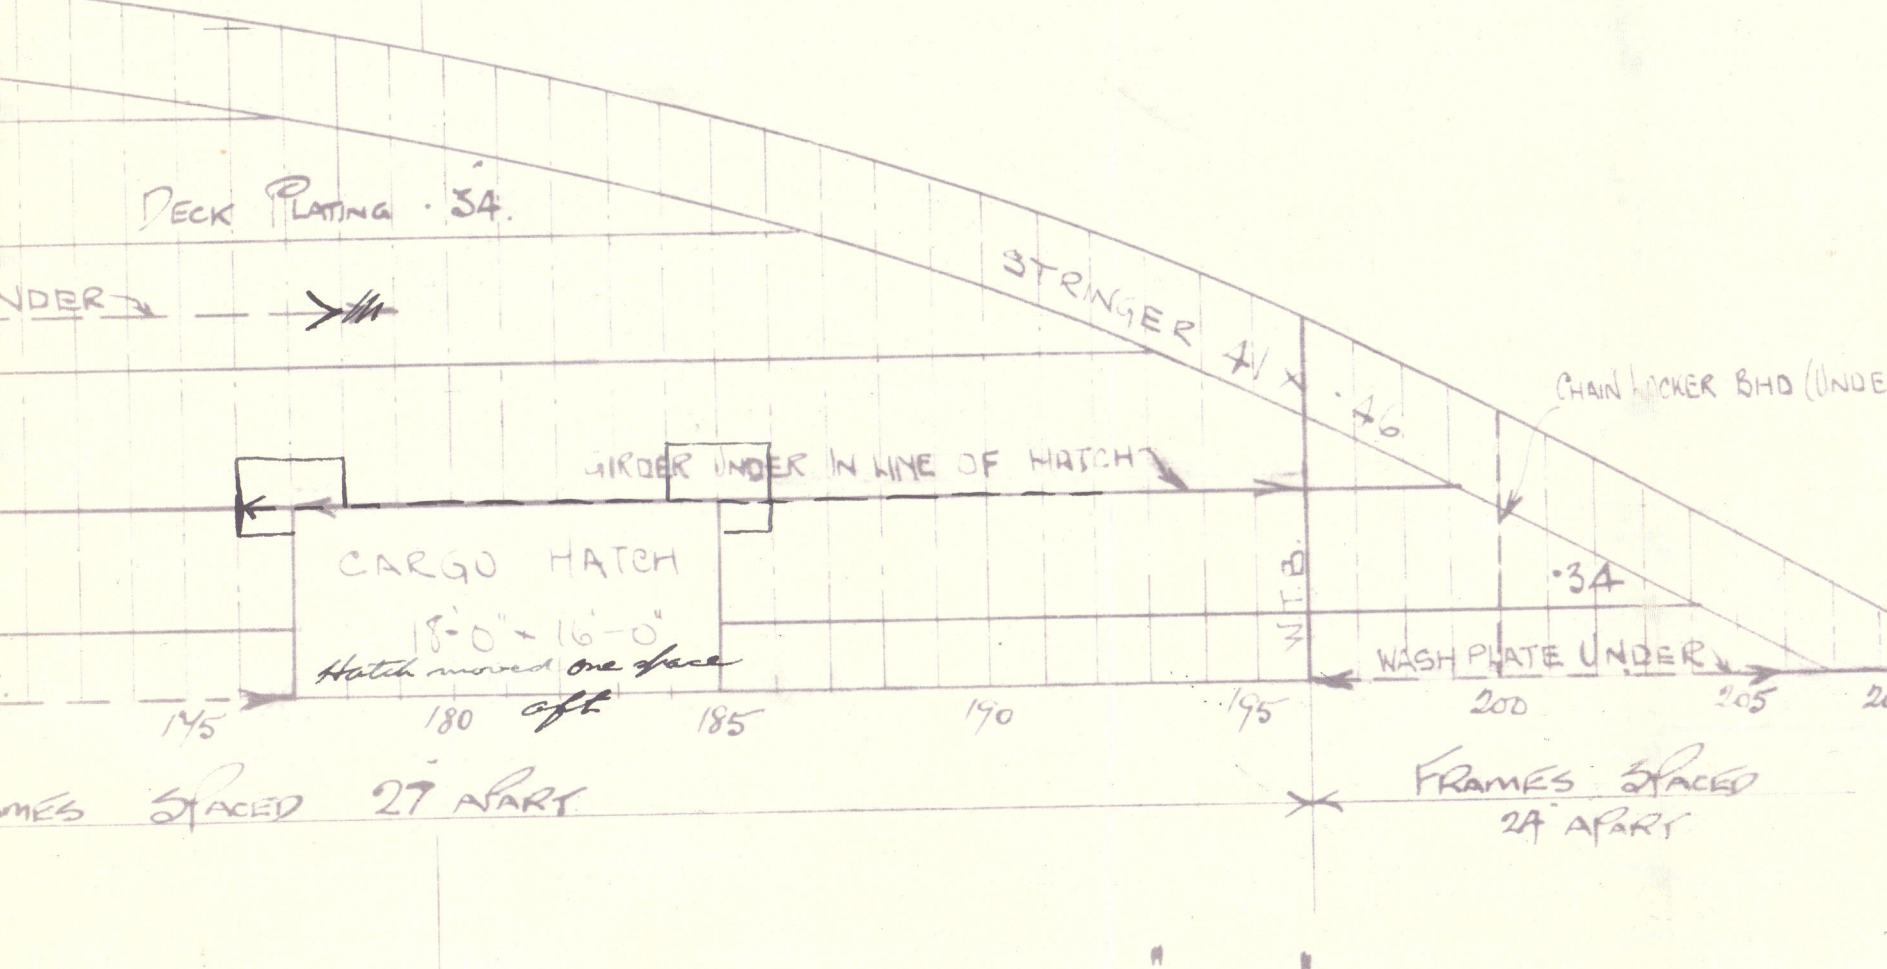

### D DECK

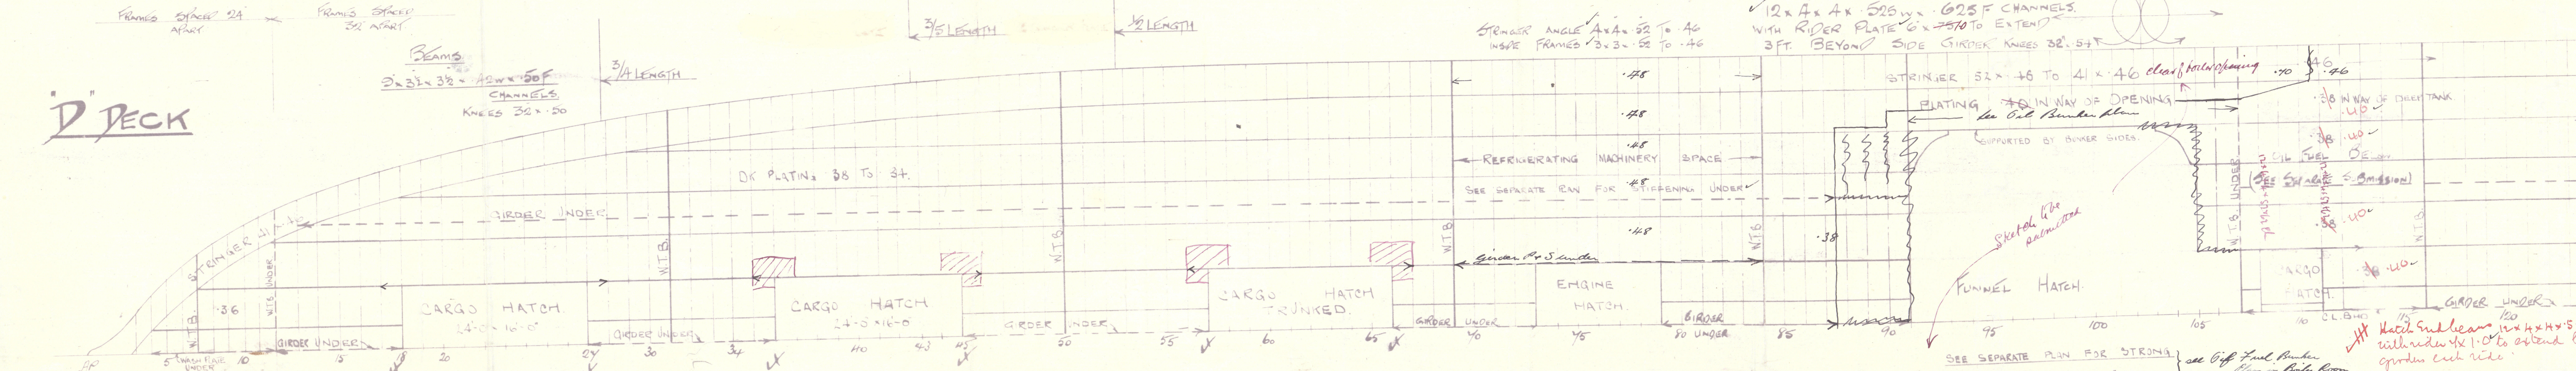

### D DECK

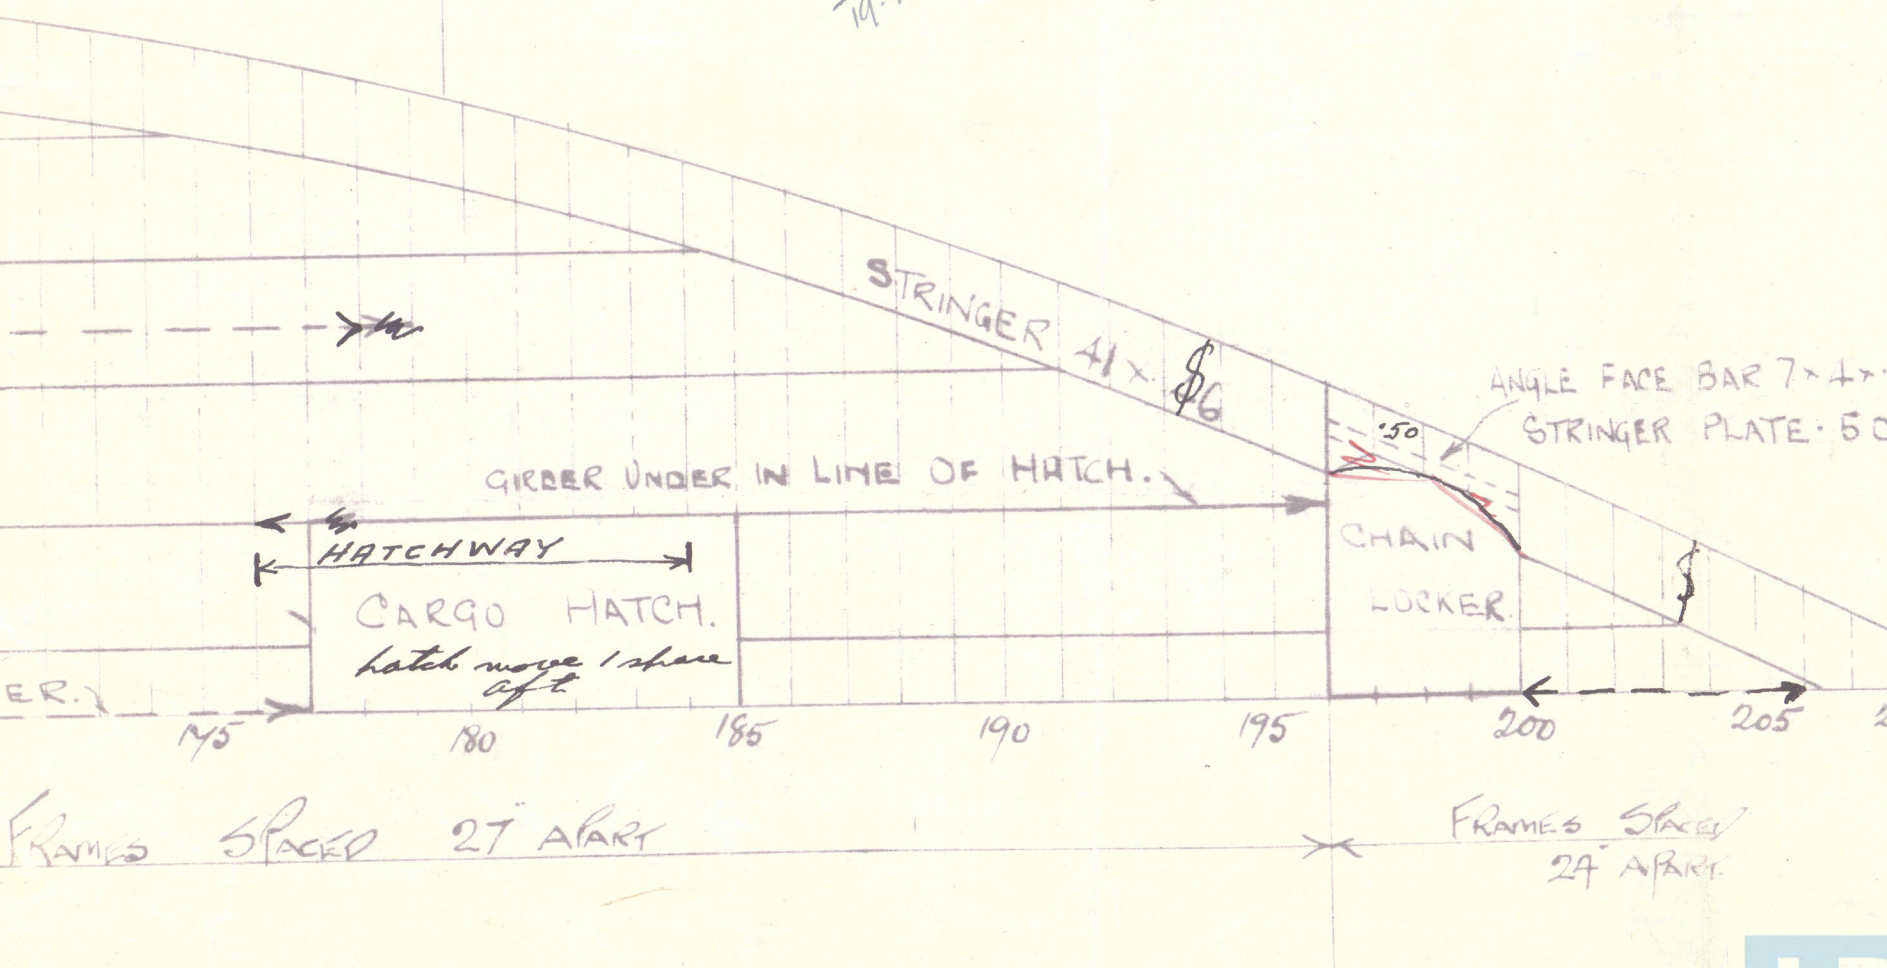

NOTE:-  
IN VIEW OF MULTIPLE PUNCHING IT IS  
PROPOSED TO FIT SINGLE KINETED COAMING ANGLES  
TO ALL WEATHER DECK HATCHES, IN LIEU OF  
DOUBLE KINETED ANGLES AS USUALLY FITTED

13

19.9.19



Vickers Ltd

nos. 573, 4, 75

Messrs Beardmores  
nos 616/17

616. Largs Bay.

617. Esperance Bay.  
(now Ottawa)

Deck plans. (A)(B)(C)(D)



573

574

575

"Moreton Bay"  
"Hobsons Bay"  
"Lewis Bay"

1st Entry for  
Do  
Do

1924

1939

1971

J.S.S. "Hobsons Bay"

Lie

NEWCASTLE ON TYNE,

Report No. 85150

re allusions

002289-002297-0161



© 2020

Lloyd's Register  
Foundation