





1-5-9  
10  
1-15-9  
2  
1-17-9



© 2020

Lloyd's Register  
Foundation



(5)

Vickers Ltd  
Nos 573, 495,

Beardmore & Co's


616/17


616. Largo Bay.

617. Esperance Bay.

Profile

(now Atawa).

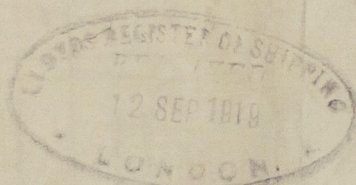

No 573 = "Mouton Bay"  1st E. Rpt 1924  
- 574 = "Hobson's Bay" Do 1937  
- 575 = "Lewis Bay" Do 1941

4. 5/5 "Hobson's Bay"

See

NWC Rpt. 85150. re altitudin

002289-002297-0162



© 2020

Lloyd's Register  
Foundation