

SECRET AND CONFIDENTIAL

PROFILE.

DIMENSIONS: 320'-0" B.P. x 41'-6" EX. x 25'-6" M^{LD}


SCALE 1/8" = 1 FT

SHERWOOD SYSTEM
(PATENT).

- Detailed plans to be submitted

J. W. ISHERWOOD,
4, LLOYD'S AVENUE,
LONDON, E.C.
ISHERWOOD SYSTEM OF
SHIP CONSTRUCTION
(PATENT)

© 2020
Lloyd's Register
Foundation

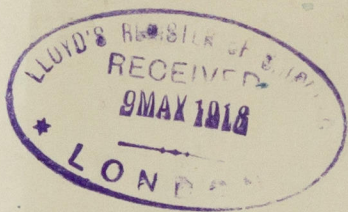

002289-002297-0230



© 2020

Lloyd's Register
Foundation

— Profile. —
(2000 Tons Tankers)

W. Gray & Co: Nos. 886 & 887

886:-

R. J. A. Rapidol

West Hartlepool Report No 15397.

Montenol
Vitol
Plavol
Kortol



887.

R. J. A. Montenol

West Hartlepool Report No 15426.

2



© 2020

Lloyd's Register
Foundation

002289-002297-0230