

NO 592 G.



POOP & FORECASTLE DECKS.

SCALE $\frac{1}{4}$ " = 1 FOOT.



DECK PLATING JOGGLED THROUGHOUT.




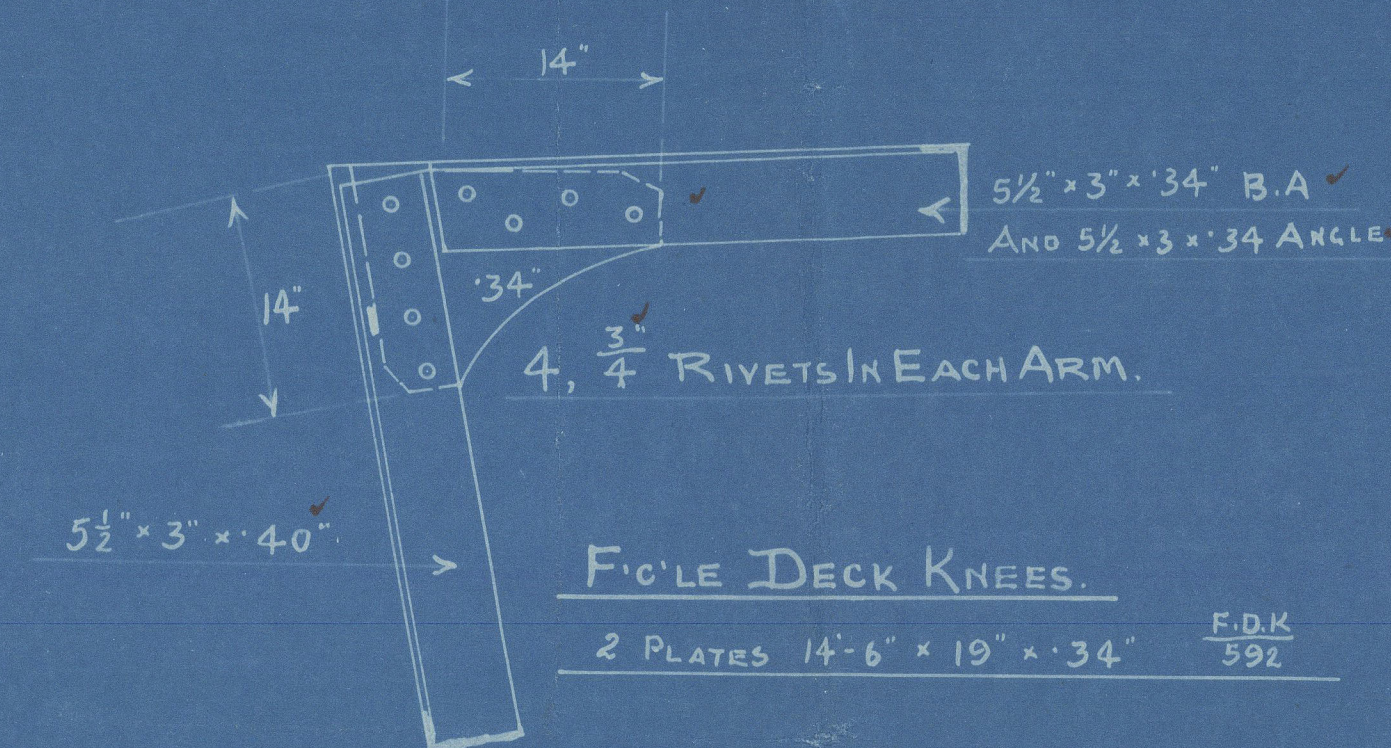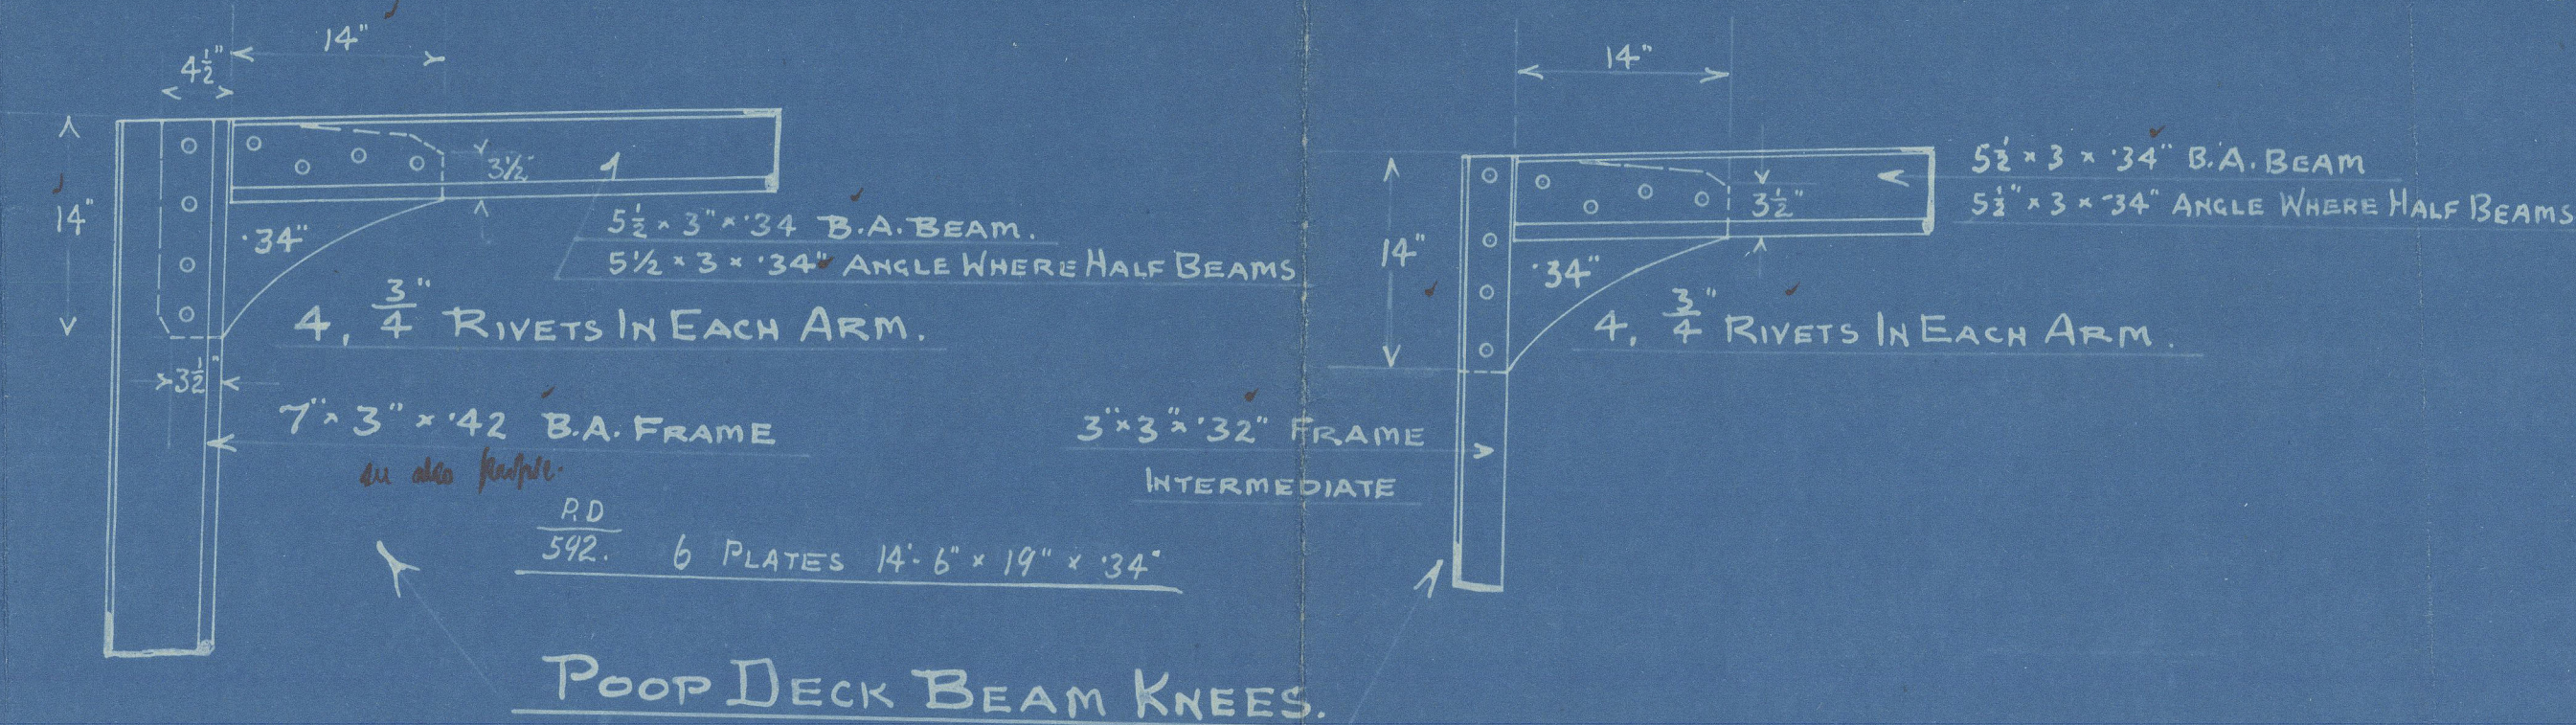


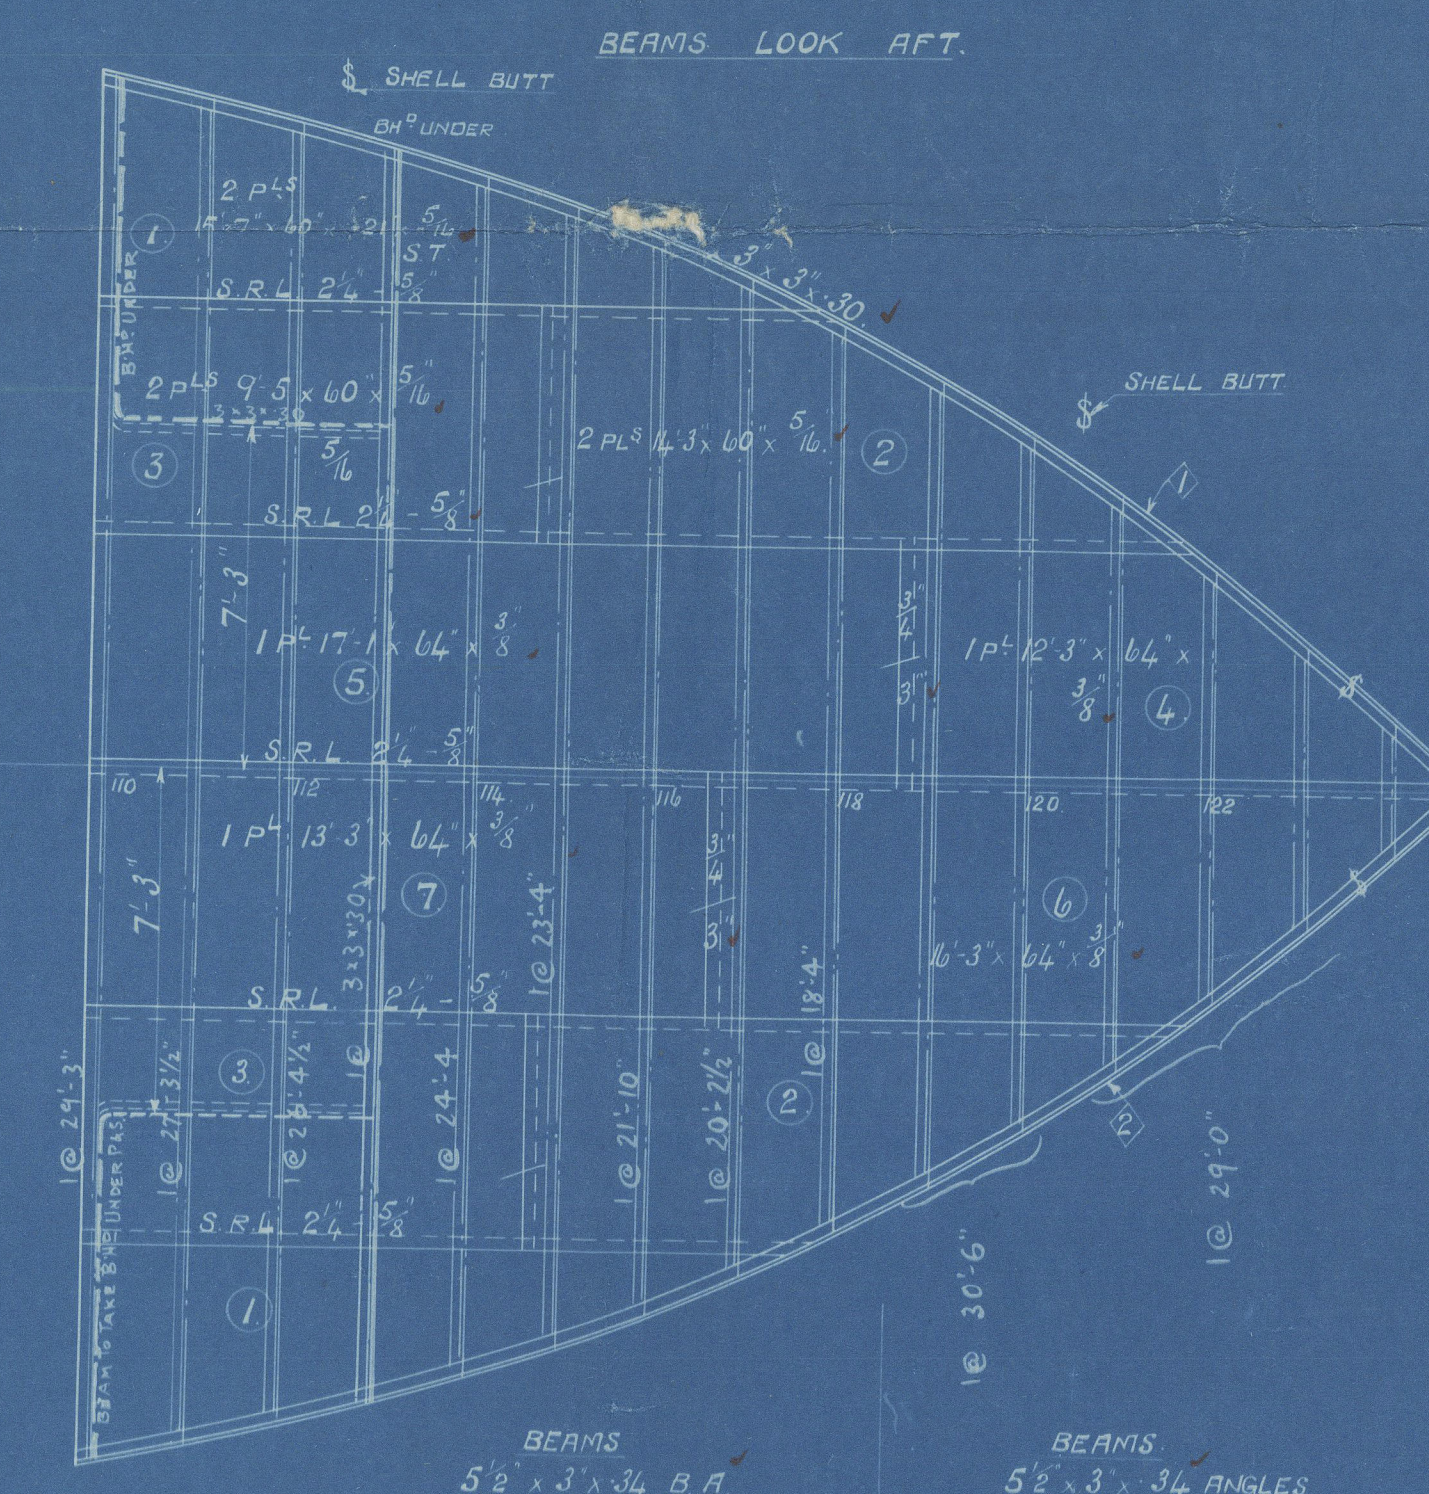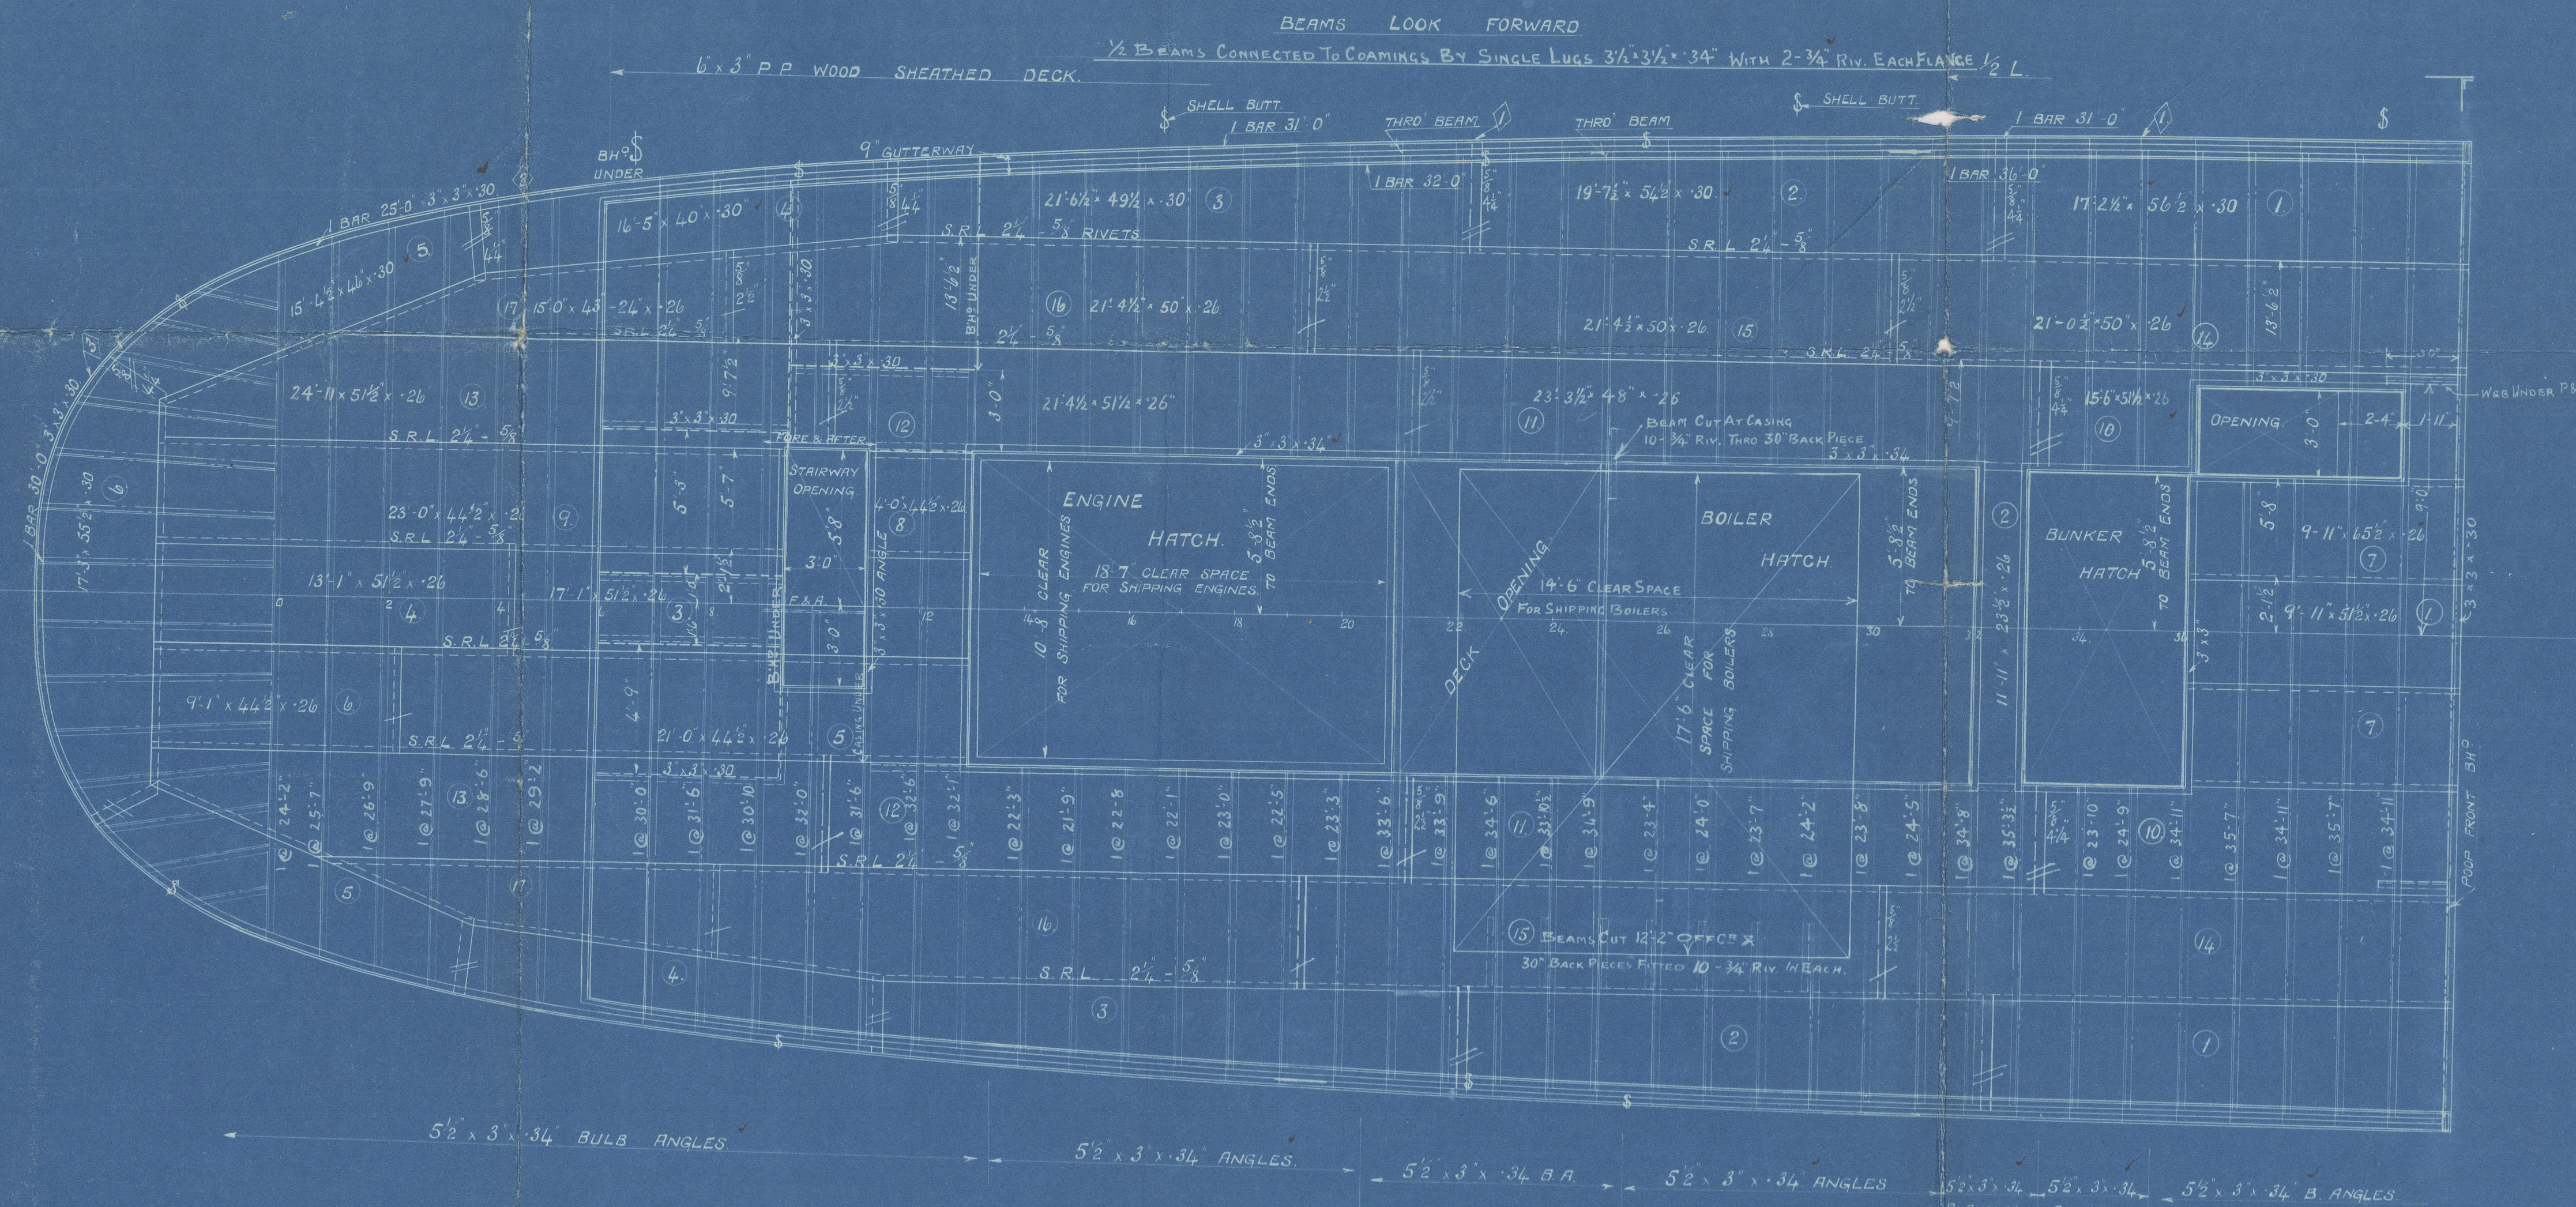

APPROVED
LLOYDS REGISTER OF SHIPPING
M. J. G. 1914

Derks (Poop &
7'de)

Mess Harland & Wolff, Le

No 592.

GLASGOW REPORT No. 39805

$\frac{3}{5}$ Somerset Coast



© 2021

Lloyd's Register
Foundation

002298-002304-0003