

8.1.13  
5.2.13  
15.8.13.


# PROFILE & DECK PLANS

S.S. N<sup>o</sup> 308-9

LENGTH BP 240'-0" 34'-0" BREADTH ML<sup>o</sup> 16'-4" DEPTH MB

SCALE 1/8" = 1 FOOT.

SHEER  
5'-0" FORWARD & 1'-6" AFT

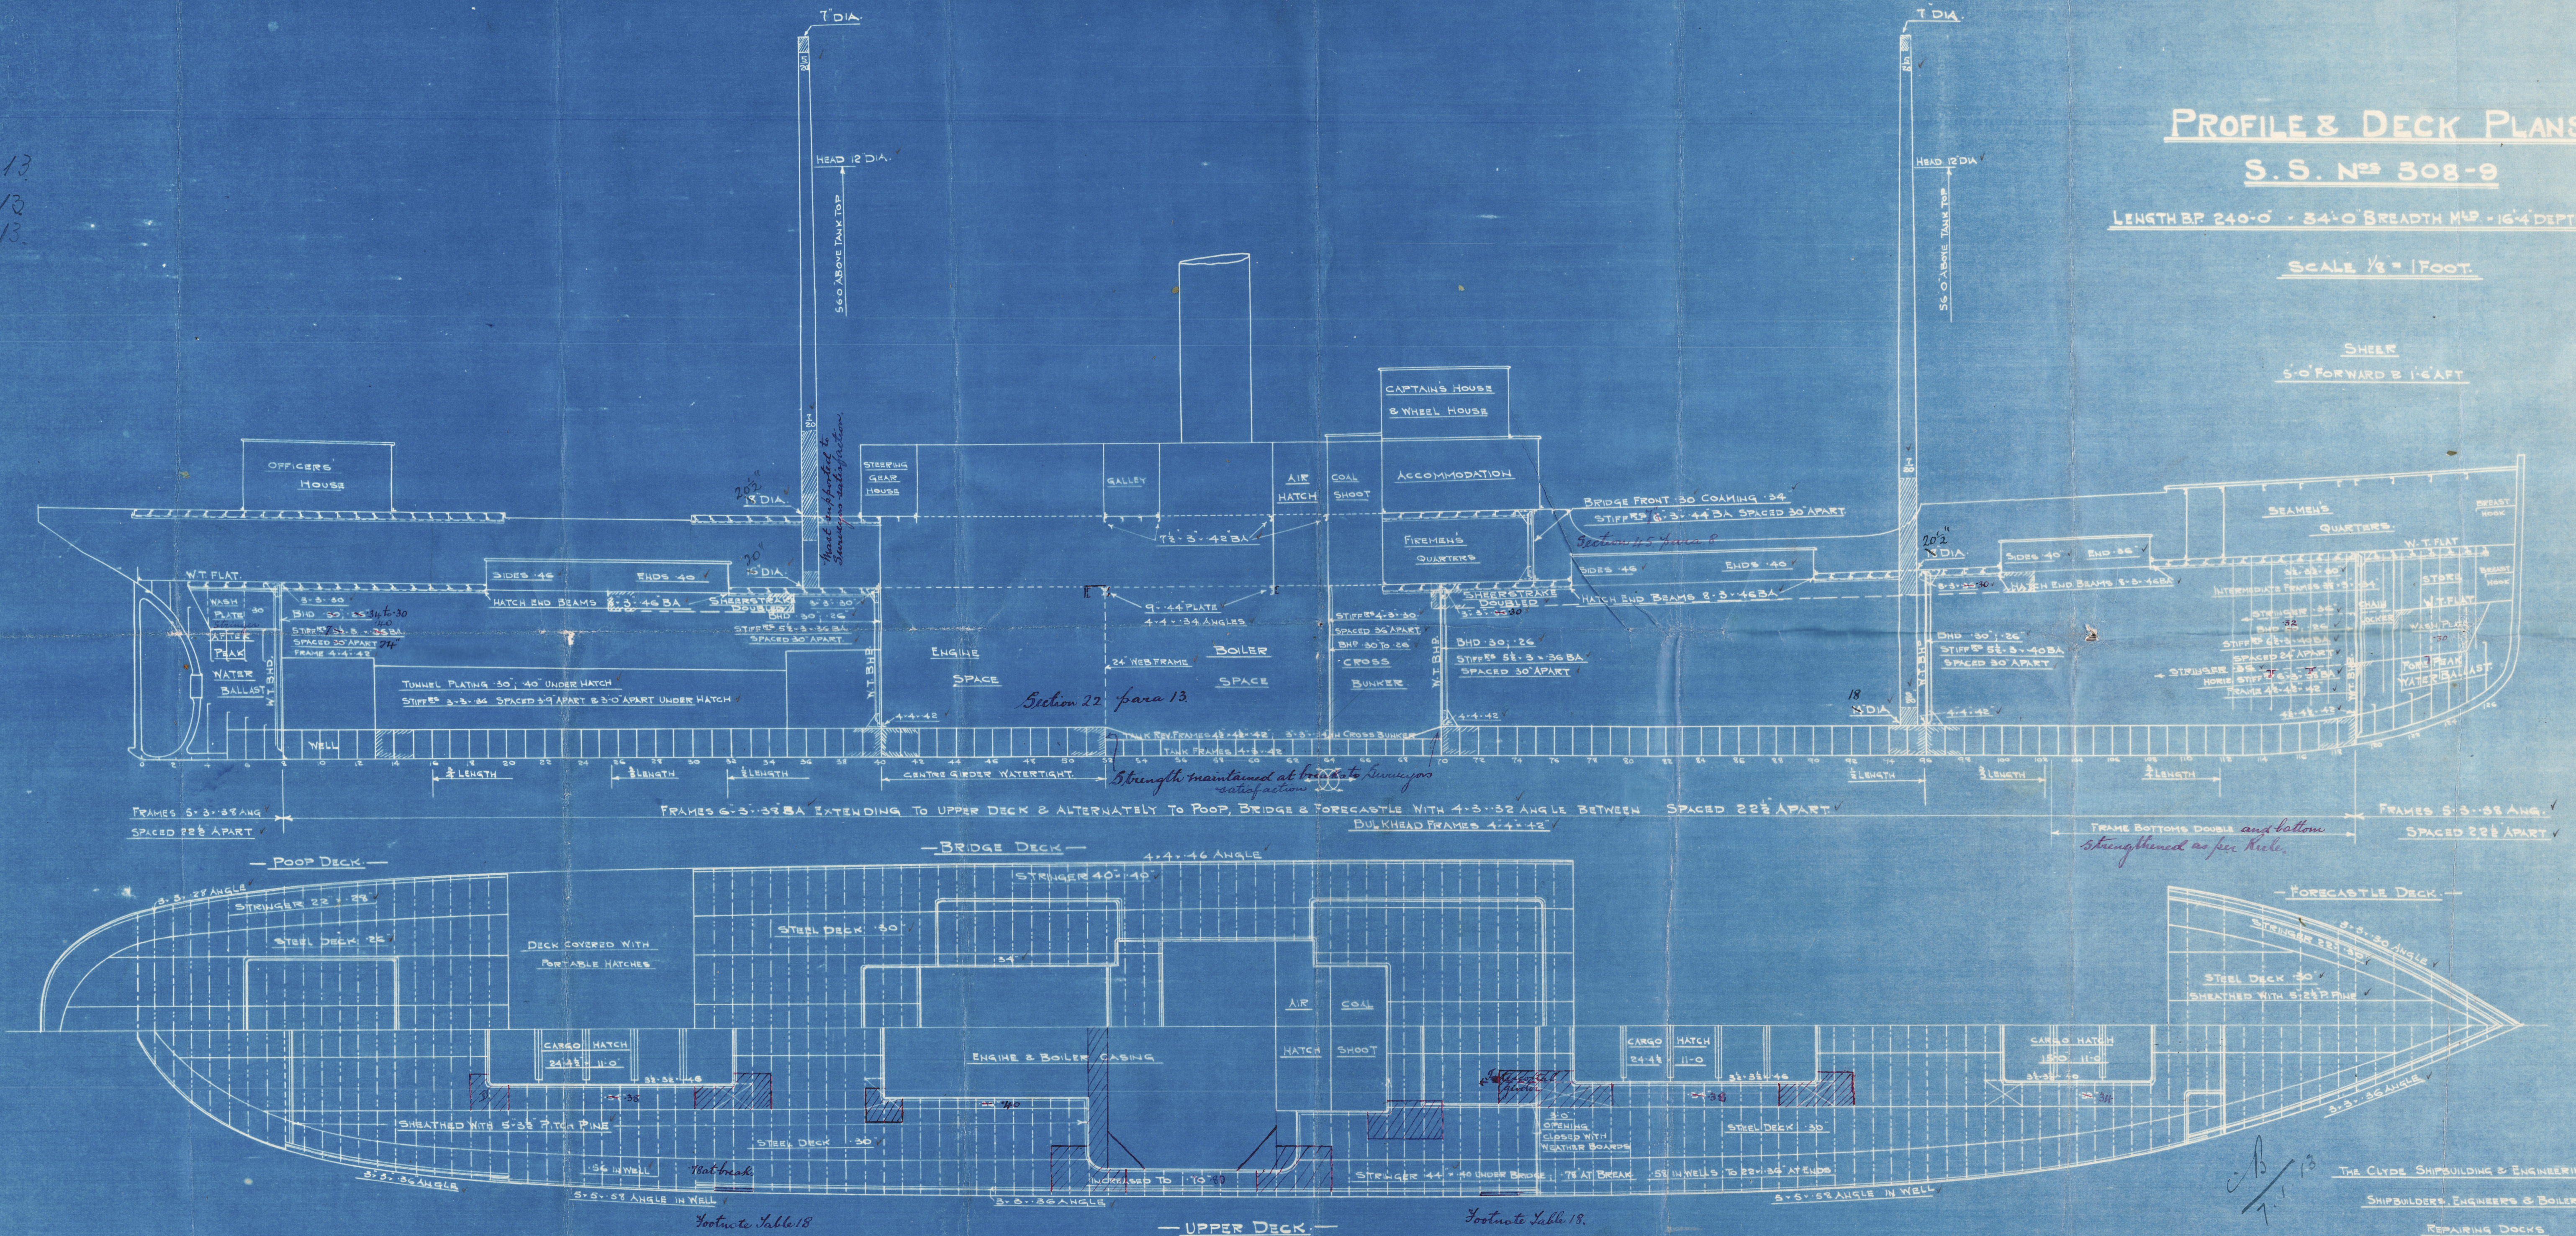



THE CLYDE SHIPBUILDING & ENGINEERING CO. LTD.  
SHIPBUILDERS, ENGINEERS & BOILERMAKERS  
REPAIRING DOCKS  
PORT - GLASGOW  
TRACING N<sup>o</sup> 865 DATE 28.12.12 © 2020



13  
0-01



© 2020

Lloyd's Register  
Foundation




1/2 No 308 and 309



Profile and Deck

in years

The Clyde W. Coy. Co.

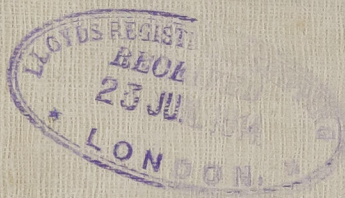

SAT. JAN 11 1913

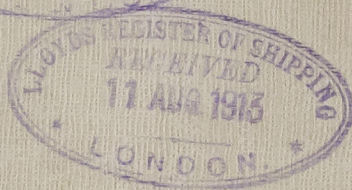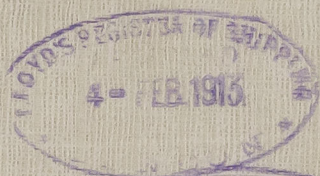

308.

7. Rother ★

GREENOCK

Report No 16681

309.

7. Rye

GREENOCK

Report No 16703



00130-02239-0003

© 2020

Lloyd's Register  
Foundation