

YARD NOS.384 & 385.
MIDSHIP SECTION.

DIMENSIONS:- 100'-0" LENGTH B.P. x 22'-0" BREADTH M^LD x 11'-0" DEPTH M^LD

SCALE 1" = 1 FOOT

LLOYDS NUMERALS L = 100·0. B = 22·0. D = 11·0.

$$\underline{L \times D = 1100} \quad \underline{L \times (B+D) = 3300}$$

EQUIPMENT NUMERAL 3300.

1 BOWER ANCHOR 5 1/2 CENTS (STOCKLESS)!

1 " " 5 " (STOCKLESS) ✓


1 KEDGE ANCHOR 2 1/2 CWTs EX. STOCK.

75 FATHOMS $\frac{15}{16}$ " STUD LINK CHAIN CABLE.

75 " 7 1/2" COIR TOW ROPE. V

75 " 3 1/2" WARPS . V

75 " 1/2" GALVANIZED MOORING CHAIN.

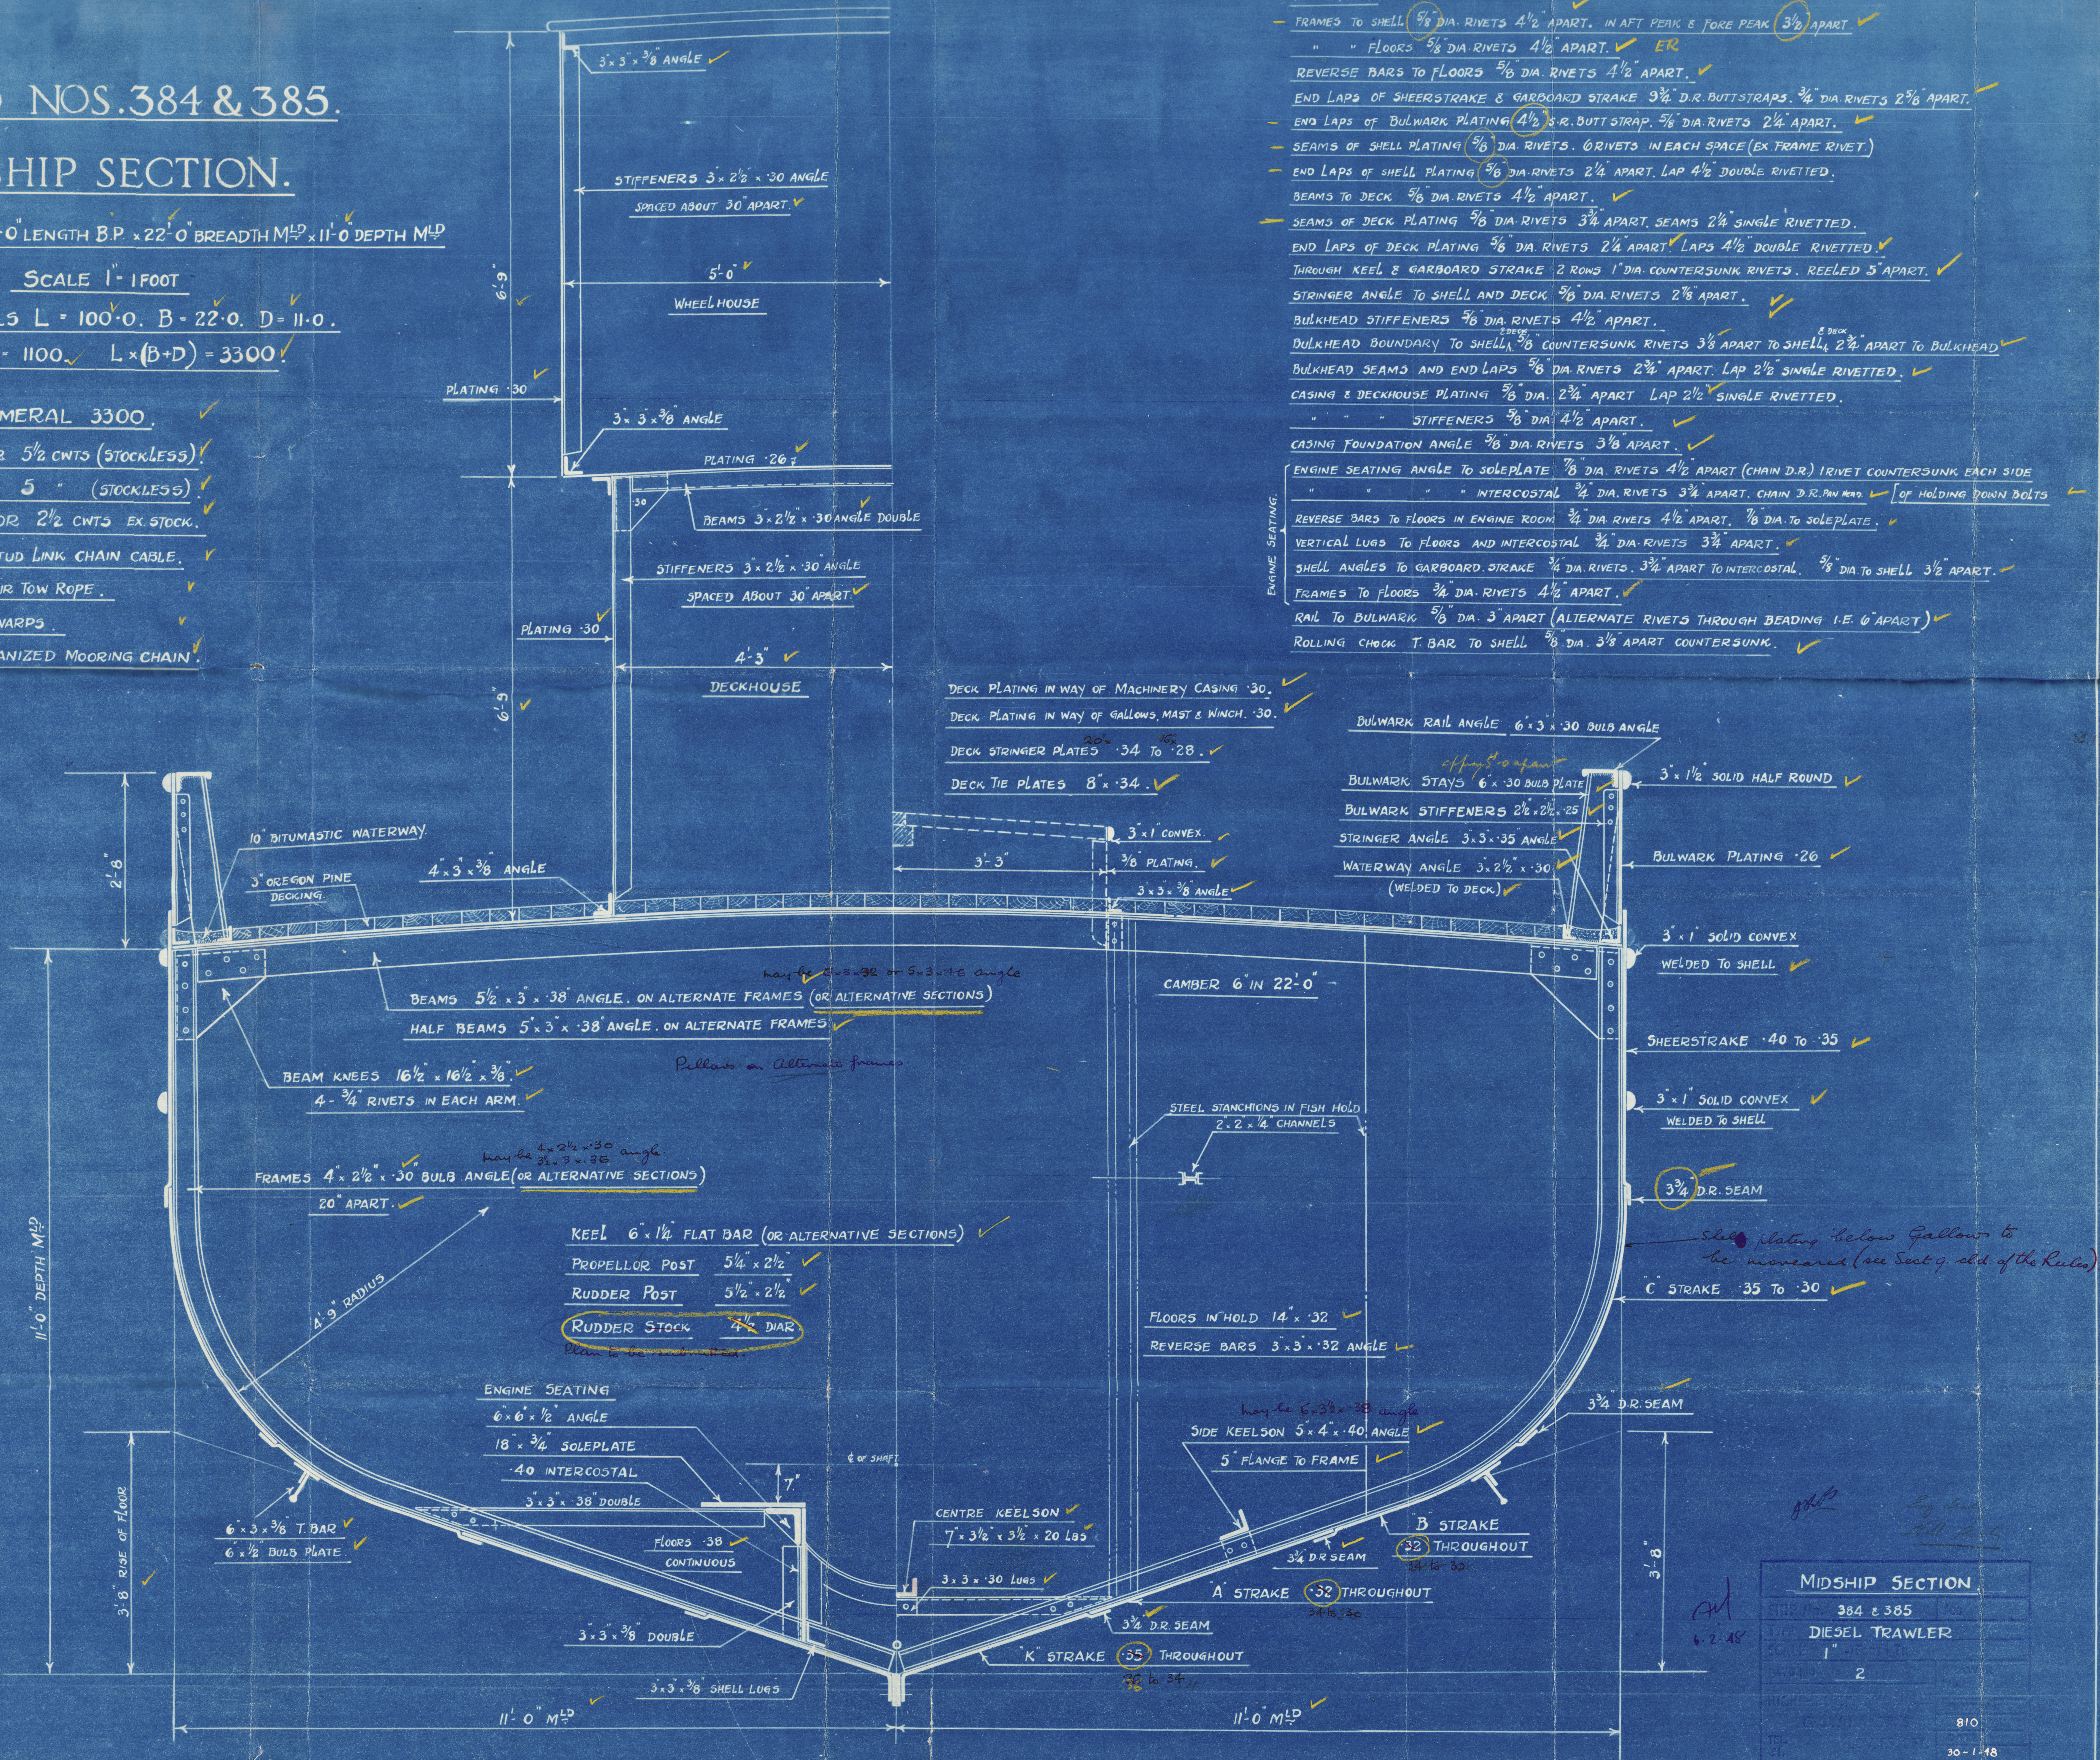

MIDSHIP SECTION

384 & 385

DIESEL TRAWLER

YARD NOS. 384 & 385

MIDSHIP SECTION

RICHARDS IRONWORKS LIMITED

SHIPBUILDERS & ENGINEERS

LOWESTOFT


SHIP NO:

Dwg. No.

Job No.

Print No.

Date

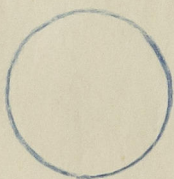


© 2020

Lloyd's Register
Foundation

RECORDS DEPT.
LONDON

"BOSTON SWALLOW" ★

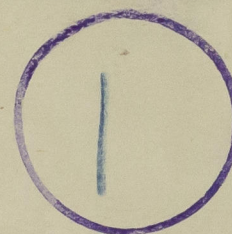

RICHARDS IRONWORKS
YARD NOS. 384-5
—

MIDSHIP SECTION

002330-002339-0092



© 2020

Lloyd's Register
Foundation