


SCALE $\frac{1}{8}$ " = 1 FOOT.

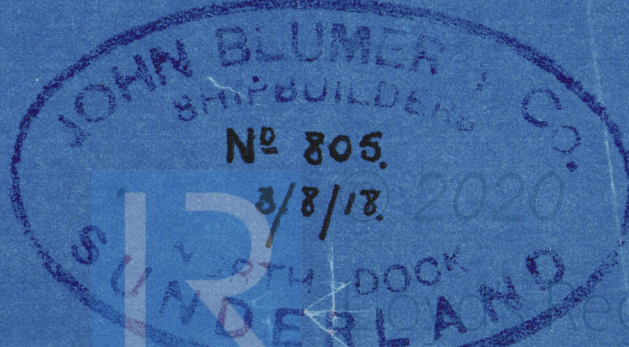

WAR COPPICE

J. BLUMER'S

No 247.

TYPE C

PROFILE & DECK

PLANS AS BUILT

SUNDERLAND RPT. No. 27304

Baltraffic



© 2020

Lloyd's Register
Foundation

002330-002339-0129