


# Lloyd's Register of Shipping.

Ship's Name s.s. "BALTRAFFIC"

Official No. 142597.

Memorandum of alterations reported since ship was surveyed for assignment of Load Lines in -

Alterations to Poop Accommodation.

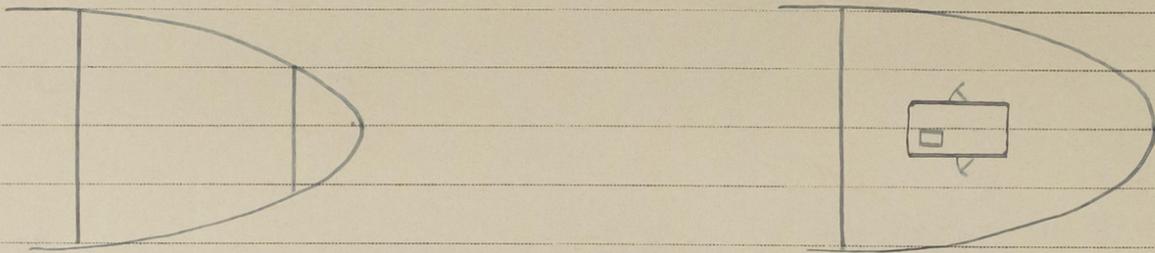

Freeboard Deck.

Steel bulkhead erected on transom frame No. 0.

Superstructure Deck.

Deckhouse fitted 18'0" x 11'0" x 7'6" in height, with door (p. & s) 4'6" x 2'0" x 18" sill. Doors manipulated both sides. ✓  
Companionway fitted inside house to accommodation below. Size of opening in deck 4'2" x 2'6". ✓

Skylight on deck aft removed and aperture plated over. ✓

Cowl vents removed and renewed as follows: ✓

9 in number 6" dia. (mushroom type). ✓

2 " " 9" dia. (mushroom type). ✓

1 " " 9" dia. (Cowl type.). ✓

*Copy of this Rpt placed on board ship 16.5.50*

*MacLeod*

*Grimsby 8<sup>th</sup> May 1950*

*115 MAY 1950*



© 2020

Lloyd's Register Foundation