
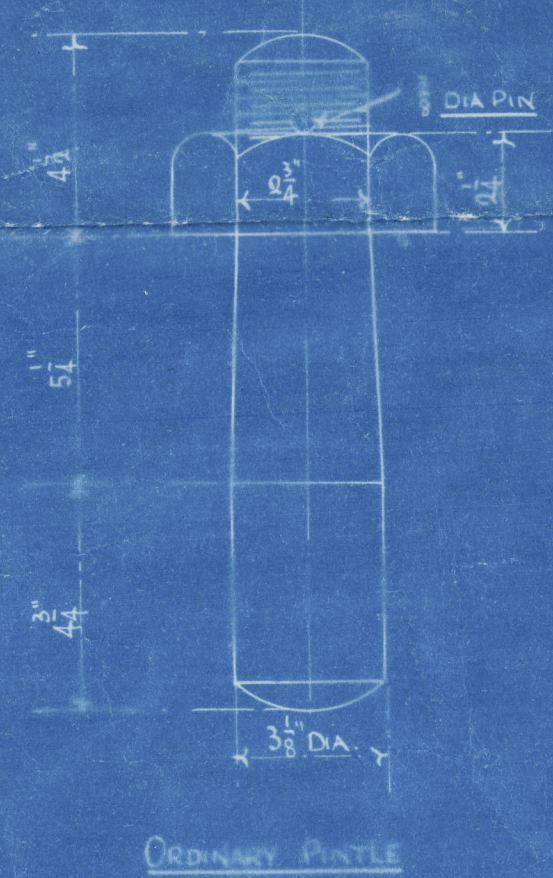
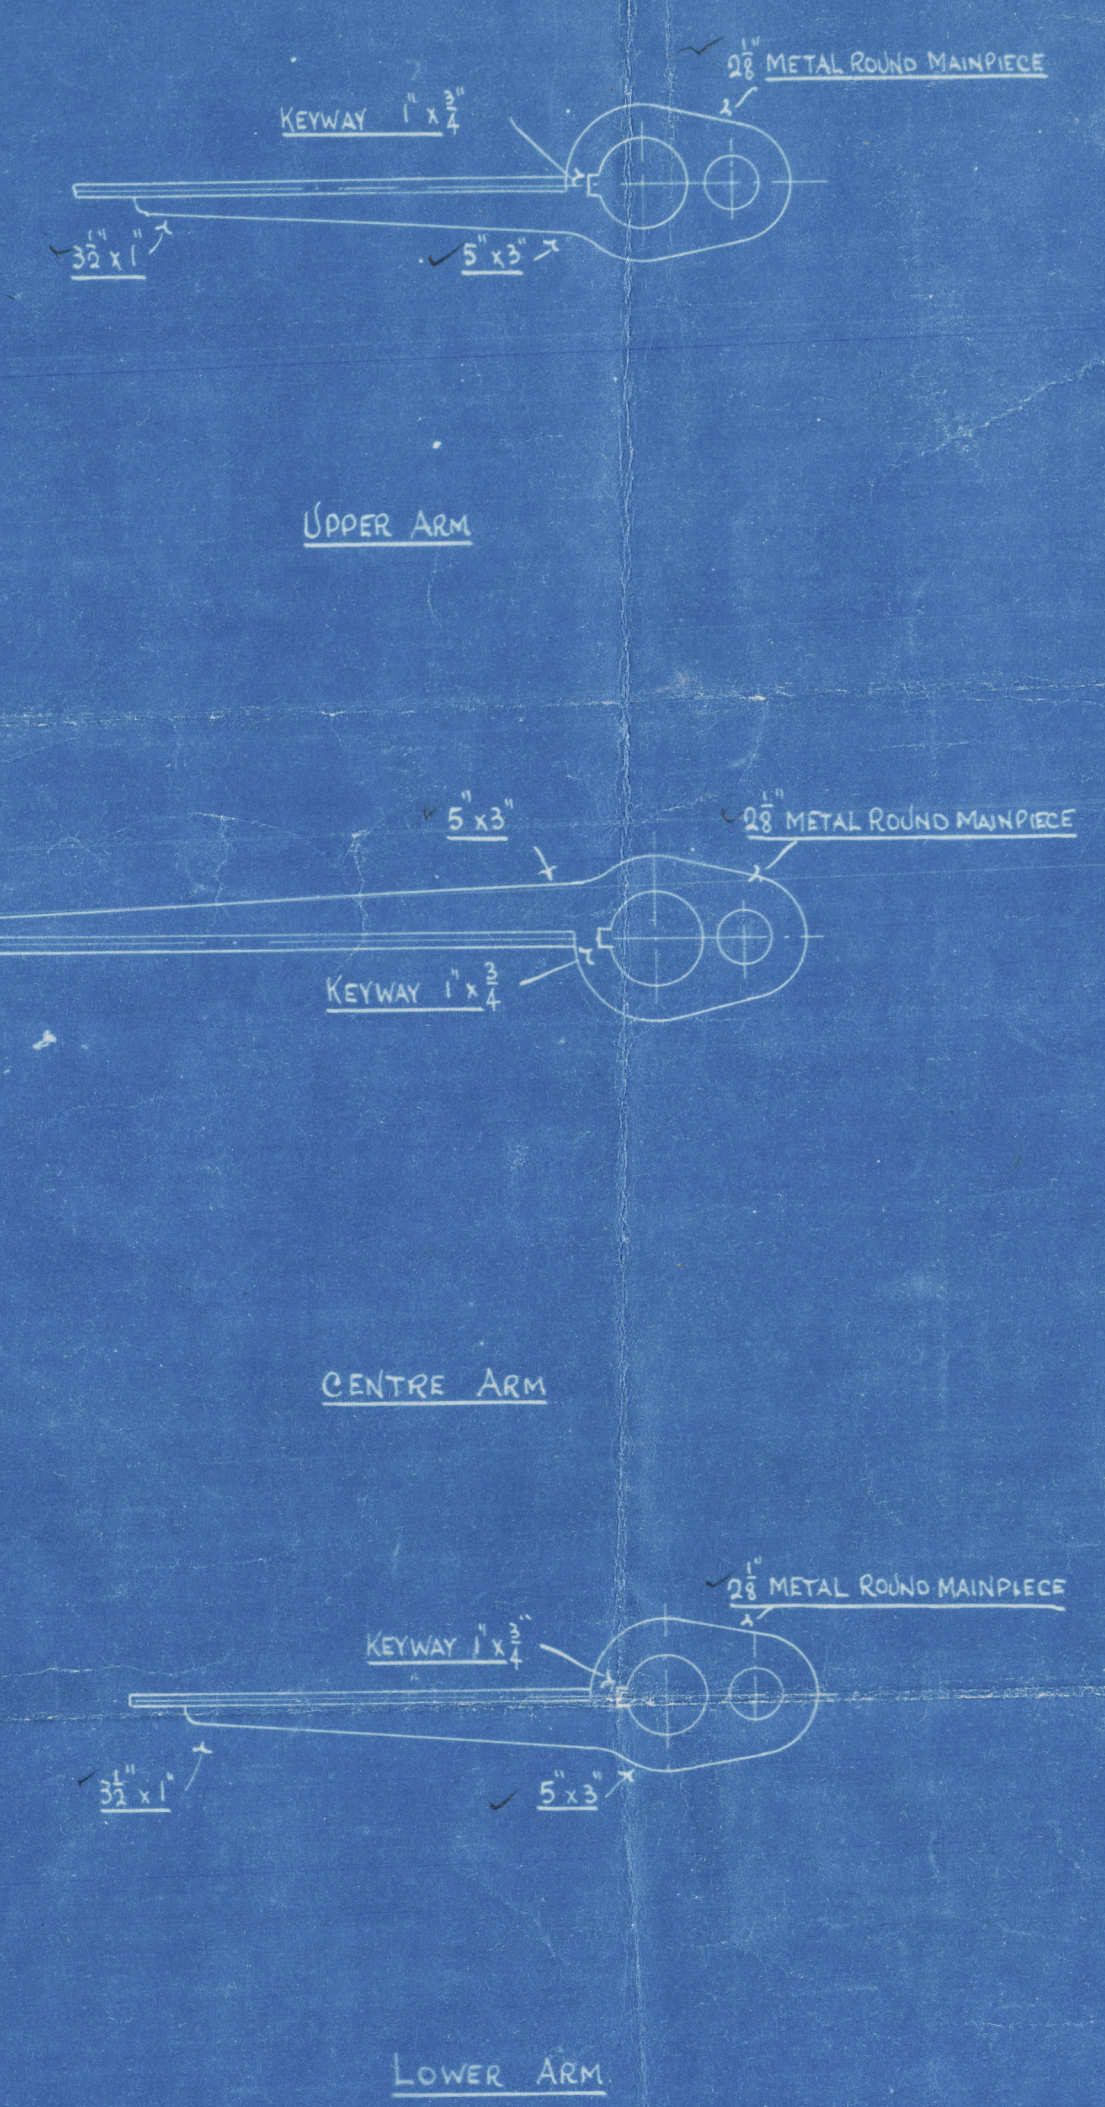


14.5 20

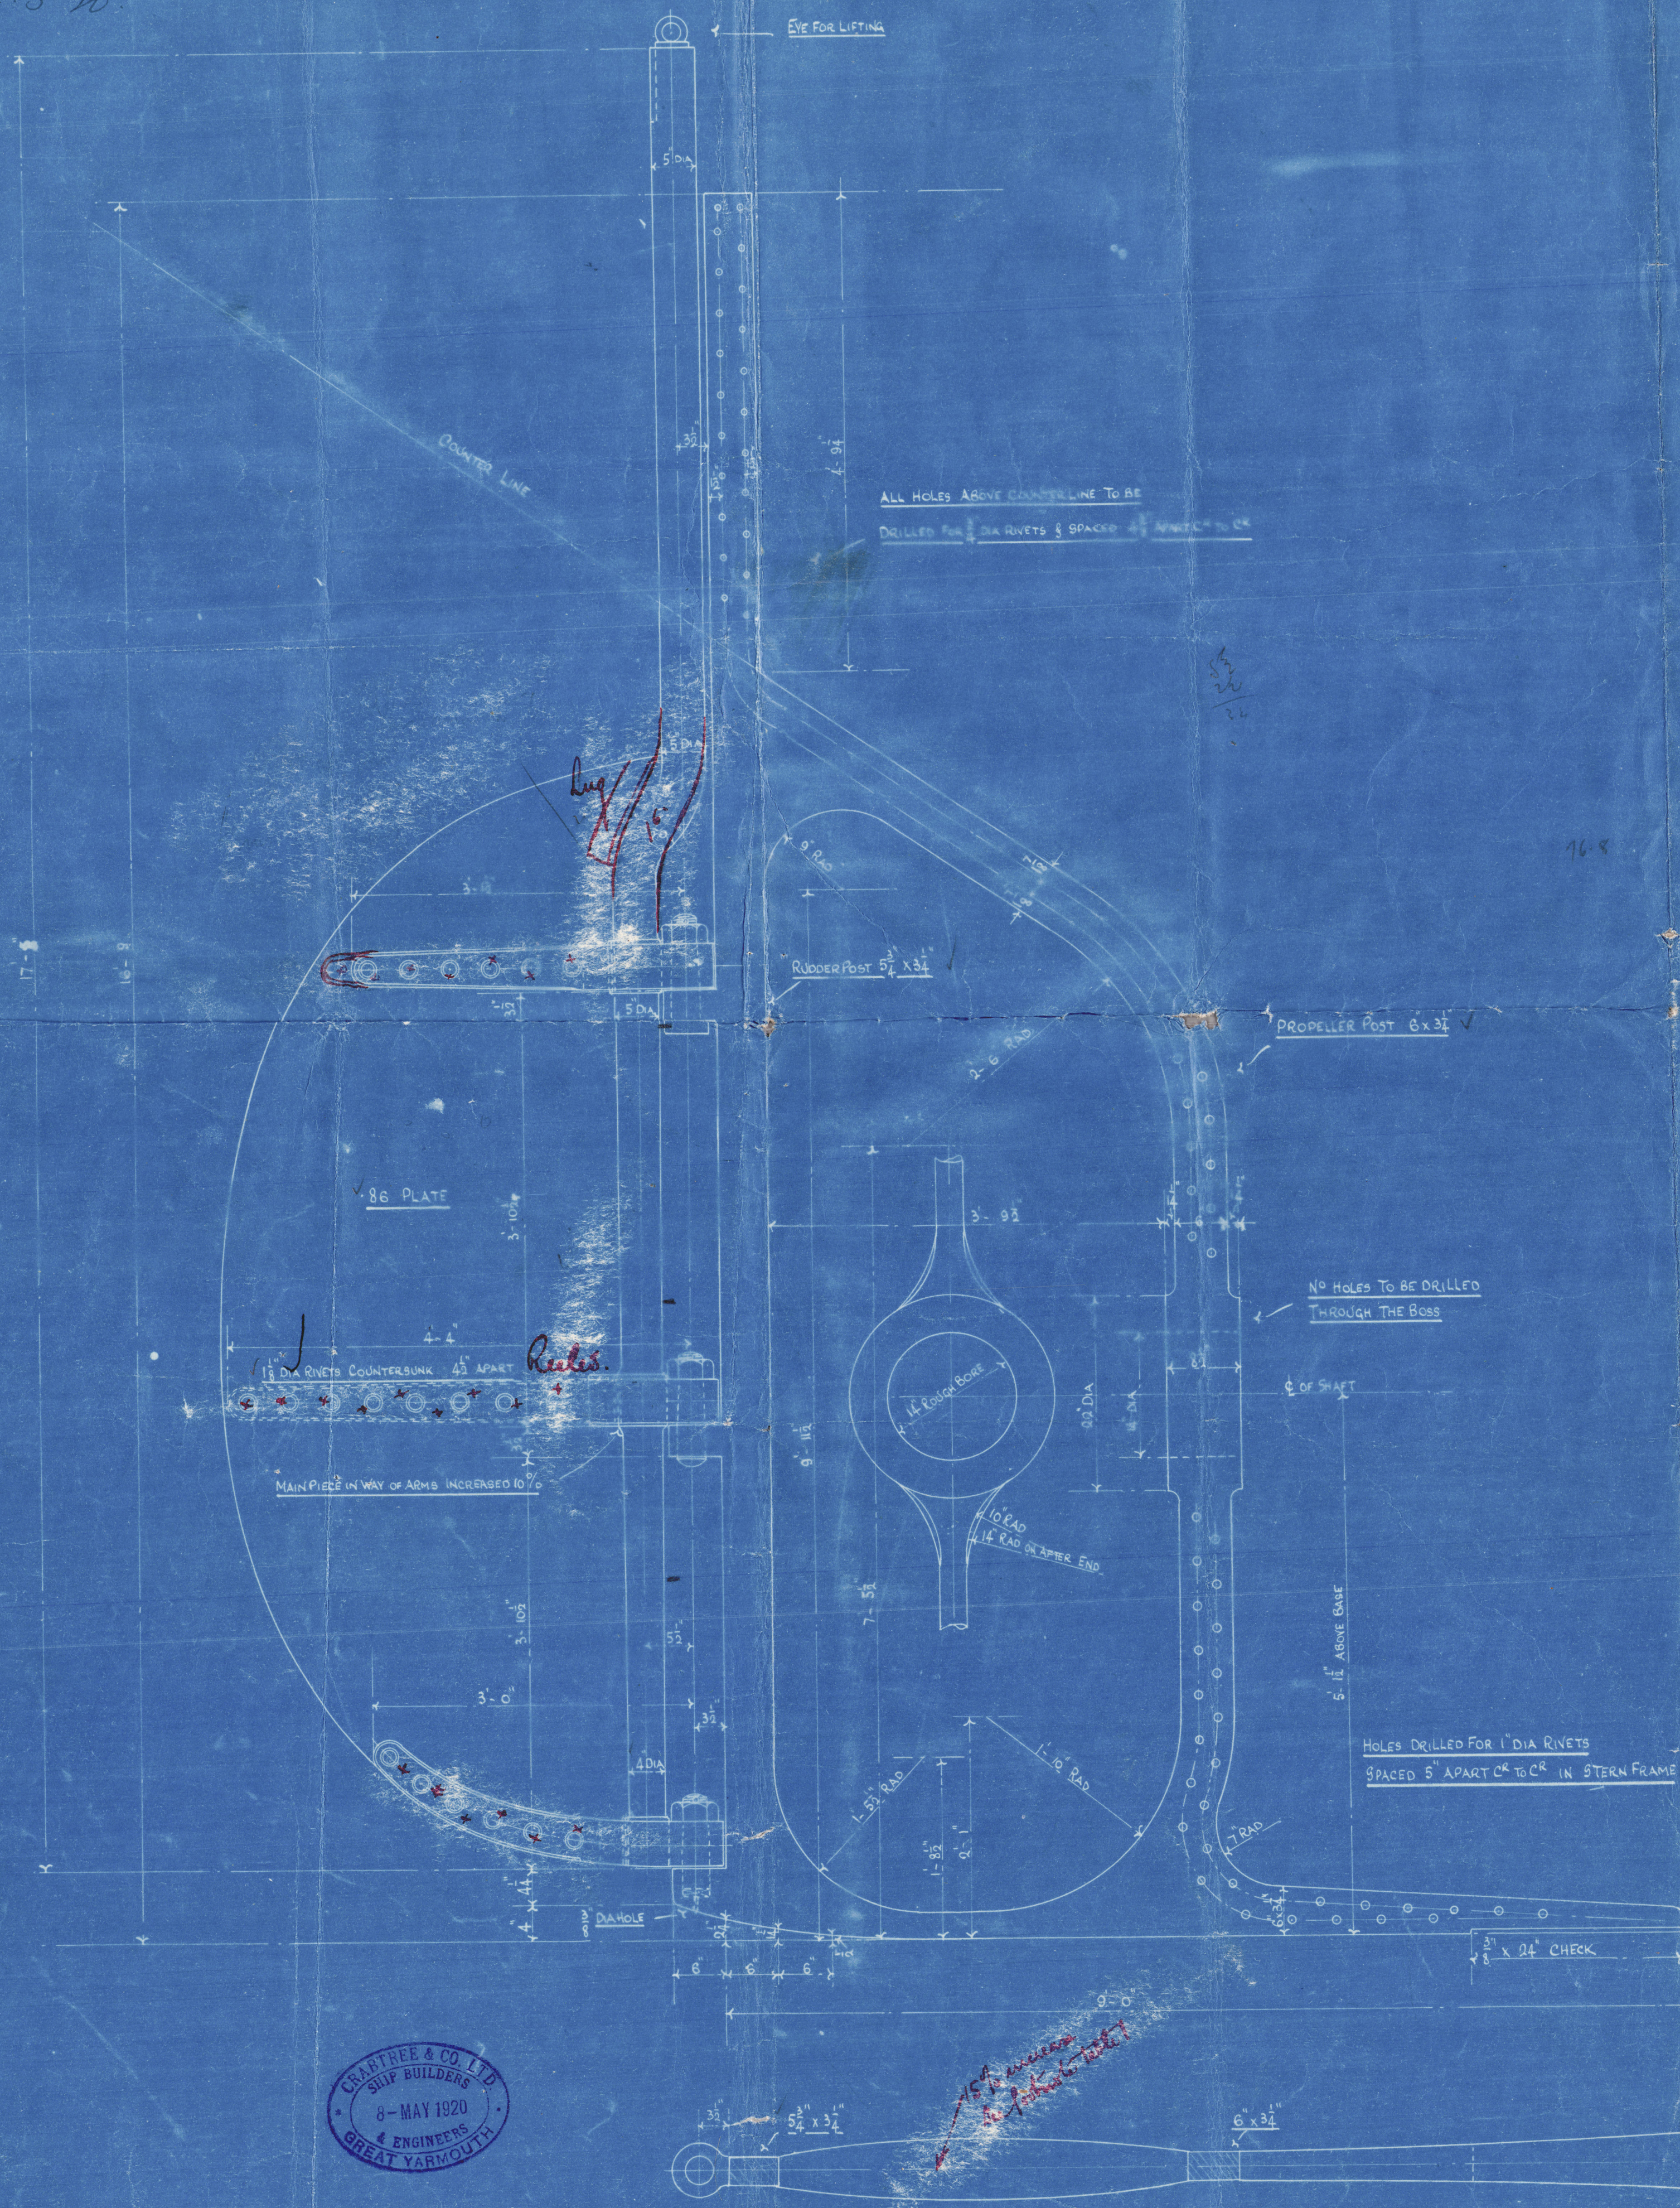

13.5.20

N^o 183

STEEL SCREW COASTING STEAMER

DIMENSIONS 142'-0" x 24'-6" x 11'-6" MLP

SCALE 1" = ONE FOOT




Crabtree & Co.

S.S. 183

Stern Frame & Pudding

183

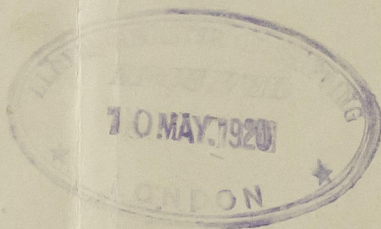

© 2020

Lloyd's Register
Foundation

Lloyd's
Captures 1873

"Steinfranke a Rudder"

"Glen. Mary"

Lon Rpt No.

84592



© 2020

Lloyd's Register
Foundation

001330-001339-0191