

EXT Bull 8/9/32

Index No. 30214 (For London Office only.)

Lloyd's Register of Shipping.

SURVEYS FOR FREEBOARD.-STEAM SHIPS.

TUE. OCT. 4 1921

No 4139?

PARTICULARS RELATIVE TO ALL STEAM SHIPS EITHER FLUSH DECKED, OR WITH TOP GALLANT FORECASTLES, SHORT POOPS AND BRIDGE HOUSES DISCONNECTED, OR WITH TOP GALLANT FORECASTLES HAVING LONG POOPS, OR RAISED QUARTER DECKS DISCONNECTED WITH BRIDGE HOUSES, OR OTHERWISE.

Port of Survey Glasgow
Date of Survey during completion
Name of Surveyor Albert Davis

Larne Shipyard & Co. N-80

Ship's Name	Port of Registry and Nationality.	Official Number.	Gross Tonnage.	Date of Build.	Particulars of Classification.
"BROUGHTY"	<u>Butech</u>	<u>144705</u>		<u>1921</u>	<u>+ 100 A. 1 contemplated</u>

Registered dimensions from Ship's Register.	LENGTH.	BREADTH.	DEPTH.	UNDER DECK TONNAGE.
	<u>166.15</u>	<u>25.30</u>	<u>9.6</u>	<u>327.83</u>
Length on LOADLINE.	<u>165.06</u>	Frame Depth $\frac{1}{2}$ Rule " <u>3</u>	Ceiling <u>fixed</u> Sheer + <u>48.81</u>	Peak } Incl. Tanks }
		$\frac{1}{2}$ " <u>3</u> drop in tank = <u>.25</u>	<u>+ .12</u>	
CORRECTED DIMENSIONS.	<u>165.06</u>	<u>25.05</u>	<u>10.75</u>	<u>327.83</u>

Moulded Depth as measured..... 11-9

Addition for Keel below base line for draught record..... 1 inches.

NOTE - If the depth is measured when vessel is afloat, the details of measurement should be reported.

CORRECTION FOR LENGTH.

Length of Ship on Loadline.....	<u>165.06</u>	-
Length in Table	<u>141.0</u>	-
Difference	<u>24.06</u>	-
Correction for 10ft., Table A.	<u>.9</u>	- Table C.
× Difference divided by 10	<u>2.16</u>	(if required.)
If $\frac{1}{10}$ ths length covered divide by 2	<u>+ 1"</u>	

CORRECTION FOR IRON DECK.

Proportion covered, if less than $\frac{1}{7}$ ths length covered
Thickness of usual wood deck, less stringer 3"

CORRECTION FOR ROUND OF BEAM.

Breadth at Gunwale amidships.....	<u>25-0</u>
Round of Beam	<u>6 1/4</u>
Normal round.....	<u>6 1/4</u>
Difference	<u>✓ ÷ 2 =</u>
Proportion of Deck uncovered (Para. 19)	

NOTE - The round of beam should be reported on the full breadth of vessel at the gunwale.

Co-efficient of fineness..... .458.74 743
Any modification necessary } .02 Cell Bottom
[Para. 4 (a) to (e)]* }
Co-efficient as corrected44.72

Sheer { Stem..... 66 1/2 } 108 ÷ 2 = 54 ... Mean 55.64
at { Sternpost ... 41 1/2 } 36.29.17
Sheer at $\frac{1}{8}$ of the length from { Stem 34 } 61.25 ÷ 2 = 30.62 ... Mean 55.69
Sternpost 24 1/4 } + .55
Gradual mean Sheer 54.83 ✓
Standard mean Sheer [Table, Para. 18] 26.5 ✓ Correction
Difference..... 28.33 ÷ 4 = 7" ✓
§ If limited as Para. 18 (f)

Rise in Sheer { At front of bridge house.....
from amidships }
[Para. 18 (e)] { At after end of forecastle ✓

Fall in Sheer }
Para. 18 (d) } ÷ 2 =
Length uncovered ✓ Correction

ALLOWANCE FOR DECK ERECTIONS :-

Freeboard, Table C..... 3 1/4
Correction for Length, if required (Para. 12, 13, and 14)
Freeboard by Table A. corrected for sheer, and for length, if required (Para. 12, 13, and 14) } 1. 1 1/2
Difference 10 1/4 ✓
Percentage as below..... 66.25%
64.15%
- 6.88"
+ .14
Correction for B. Q. Dk. if engine and boiler openings not covered by bridge house (Para. 11) } + 4 1/4
- 6.91"
Allowance for Deck Erections 6 1/2 3/4

	Length.	Length allowed.	Height.
Forecastle.....	<u>23.5</u>	<u>21.75</u> <u>22.72</u>	<u>4.0</u>
Bridge House	<u>10.75</u>	<u>10.75</u>	<u>4.0</u>
† Raised Qr. Dk.....	<u>95.5</u>	<u>95.5</u>	<u>3.6</u>
Poop.....			
Total	<u>129.85</u>	<u>128.894</u>	<u>.45.781</u>
Length of Ship	<u>165.06</u>		

Corresponding percentage { 64.15
(Para. 11, 12, 13, or 14) } 66.25%

FREEBOARD recommended amidships from centre of Disc to top of Statutory Deck Line, Wood (Iron) Deck :-

Fresh Water Line	above centre of Disc
Indian Summer Line	"	"	"	"	"	"
Winter Line	below	"	"	"	"	"
Winter North Atlantic Line	"	"	"	"	"	"

7.10.21

frames, skin planking, or ceiling are of unusual thickness the breadth of vessel to inside ceiling should be reported if possible. In obtaining an allowance for deck erections under Para. 11 where the sheer drops abaft amidships the height of the B.Q.D. is to be taken from the level of the top of the amidship beam. In decked vessels the total standard mean sheer means the sheer measured at the stem and sternpost. In vessels having poops and forecastles, it means the sheer measured at points distant from the stem and sternpost.

† State dimensions of freeing port area on back of this form.
‡ The Surveyor should state whether the fall in sheer as reported is measured relatively to the straight line of keel or to the water line. If measured relatively to water line the vessel's draft at time of survey, and also the usual load draft forward and aft should be reported.

Freeboard, Table A	<u>1 - 8 1/2</u>
Correction for Sheer	<u>- 7</u>
Correction for Length	<u>+ 1</u>
Allowance for Deck Erections	<u>1 - 2 1/2</u> ✓
Correction for Round of Beam.....	<u>6 1/2 3/4</u>
Correction for fall in Sheer (if any).....	<u>0 - 8 3/4</u>
Correction for Iron Deck (if required)	<u>- 3</u>
Other Corrections (if any) <u>Height of raised Qr. Dk</u>	<u>3 - 6</u>
Winter Freeboard	<u>3 - 11 3/4</u>
Summer Freeboard	<u>3 - 9 3/4</u> <u>10</u>
Indian Summer Freeboard
N. A. Winter Freeboard
Correction necessary because clearside amidships, measured in accordance with the Statute is not taken at the intersection of the wood or iron deck with side.	<u>1 3/4</u>

© 2020 Lloyd's Register MARKING REPORT RECEIVED 13.10.21

Do all the Frames extend to the top height in the Poop? Raised Quarter Deck? *Yes* Bridge House? *Yes* Forecastle? *Yes*
 To what height do the Reverse Frames extend? *Acron fair top*
 Has the Poop or Raised Quarter Deck an efficient Iron Bulkhead at the fore end? *Yes*
 Give particulars of the means for closing the openings in Bulkhead *no opening*
 Is the Poop or Raised Quarter Deck connected with the Bridge House? *Yes* Has the Bridge House an efficient Bulkhead at the fore end? *Yes*
 Give particulars of the means for closing the openings in Bulkhead *no openings*
 What is the thickness of the Bridge Front plating? *.24* and Coaming plate? *.30*
 Give scantlings and spacing of the Stiffeners *Stiff 5 x 3 x .48 Angles 30' apart*
 Are bracket plates fitted at each end of the Stiffeners? *Yes* Are hor'l. brackets fitted connecting Bridge Bulk'd. with Bulwarks? *Yes*
 Has the Bridge House an efficient Iron Bulkhead at the after end? *Yes*
 How are the openings closed? *no openings*
 Is the Forecastle at least as high as the main or top-gallant rail? *Yes* Has the Forecastle an efficient Iron or Wood Bulk'd. at after end? *Yes*
 Are the Engine and Boiler openings covered by a Bridge, Poop, Raised Quarter Deck, or enclosed by a Strong Iron or Steel Deckhouse? *covered by Raised Quarter Deck*
 If the openings are not so protected are the exposed parts of the Casings efficiently constructed?
 Give thickness of plating; scantlings and spacing of Stiffeners *Plating .24 Coaming .30 Stiff 2 1/2 x 2 1/2 x .25 spaced 30" apart*
 What is the height of the exposed Casings? *7-0* Are suitable means provided for closing all openings in them in bad weather? *Yes*
 Are the Weather Deck Hatchways efficiently constructed and at least equal to the requirements of Section 28 of the Rules for 1904-5? Give particulars below:— *Yes*

Position and Size.	N ^o 1 = 27.0 x 14.0		N ^o 2 = 26.6 x 14.0		Ship.	Rule.	Ship.	Rule.	Ship.	Rule.
	Ship.	Rule.	Ship.	Rule.						
COAMING	Height above top of DECK	30"								
	Thickness	Sides	.44	do						
		Ends	.44							
SHIFTING BEAMS OR WEB PLATES	Number	4								
	Section and Scantlings		5 x 3 x .50	do						
			13 x .34							
Material		3 x 3 x .42								
* FORE AND AFTERS.	Number	none								
	Section and Scantlings			do						
		Material								
HATCHES Thickness		2 1/2	do							
Remarks										

* The depth of Fore and Afters should be stated from the underside of the hatches in all cases.


(If the sill of the lowest side scuttle will be less than 6 inches above the Indian Summer Load Line if assigned under the tables, state vertical distance from top of deck at side amidships to lower edge of lowest side scuttle.)

The following information is to be given in all Cases of vessels dealt with under Paras. 11, 12 (under 15 feet Moulded depth) and under ~~State Deck Rules~~.

What is the thickness of the Bridge Sheerstrake? _____ Strake between Main and Bridge Sheerstrakes? _____

Delete the words The Crew are, are not, berthed in the bridge house.
 that do not apply The arrangements to enable them to get backwards and forwards from their quarters are, ~~are~~ satisfactory.

Length of Bulwarks in well *36-0 35-21*
 Area of Freeing Ports required by Para. 11 (e) each side of vessel = *10.402* Sq. ft.
 Ft. Tenths. Ft. Tenths. No. } Freeing Ports = *11.25* Sq. ft.
1.5 x 2.5 x 3 (each side of vessel)
 Total deficiency or excess = *1.75* Sq. ft.

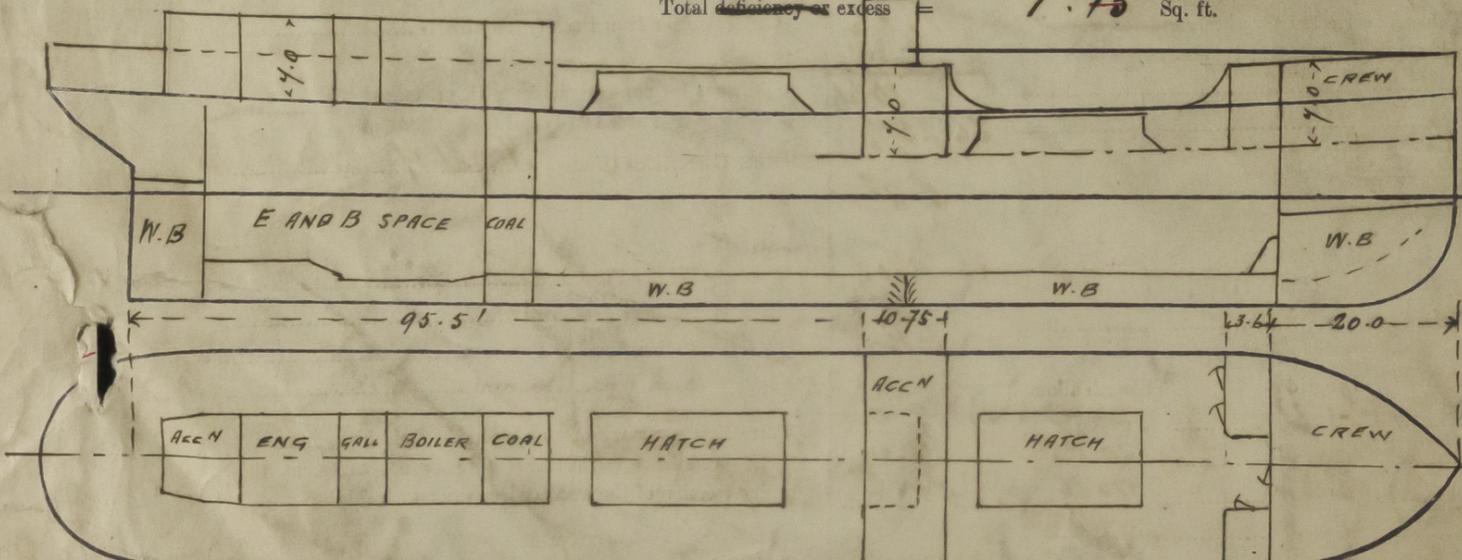

Show hereon line of Floors or Tank Top with position of any Breaks in same; also height of Peak Tank tops, &c., &c.

State any special features in the construction of the Vessel *This vessel is stated to be a sister vessel to the M^r Kerry more, the Larue Shipbuilding Coe N^o 78 = Built at Larue she has been completed & fitted out by Scott Sons - Bowling*
 Owners *The Dundee Perth & London Shipping Coy L^d*
 Address *East Rock Street - Dundee*

Fee £ *2 : 2 : 0* Received by me

