
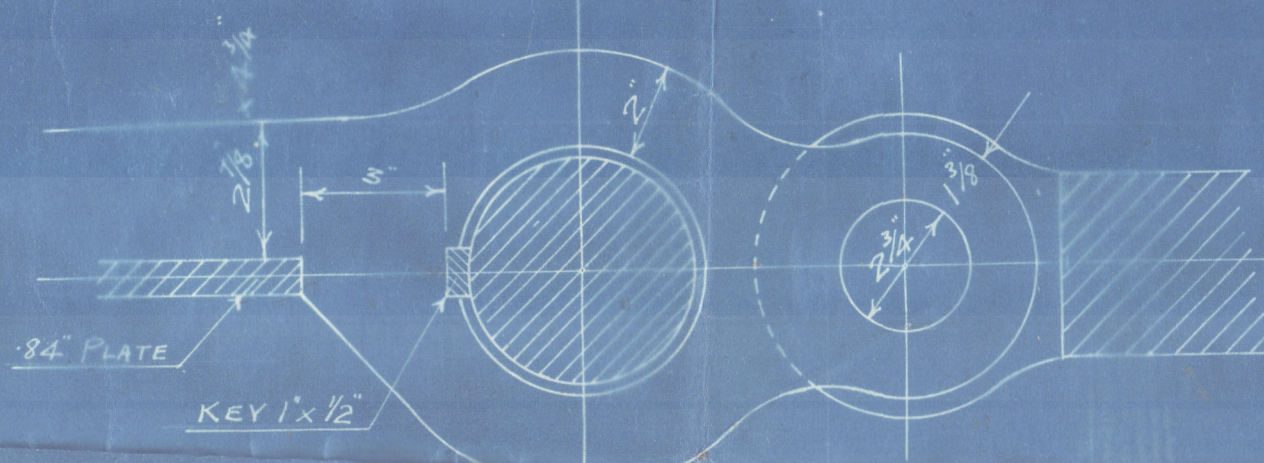
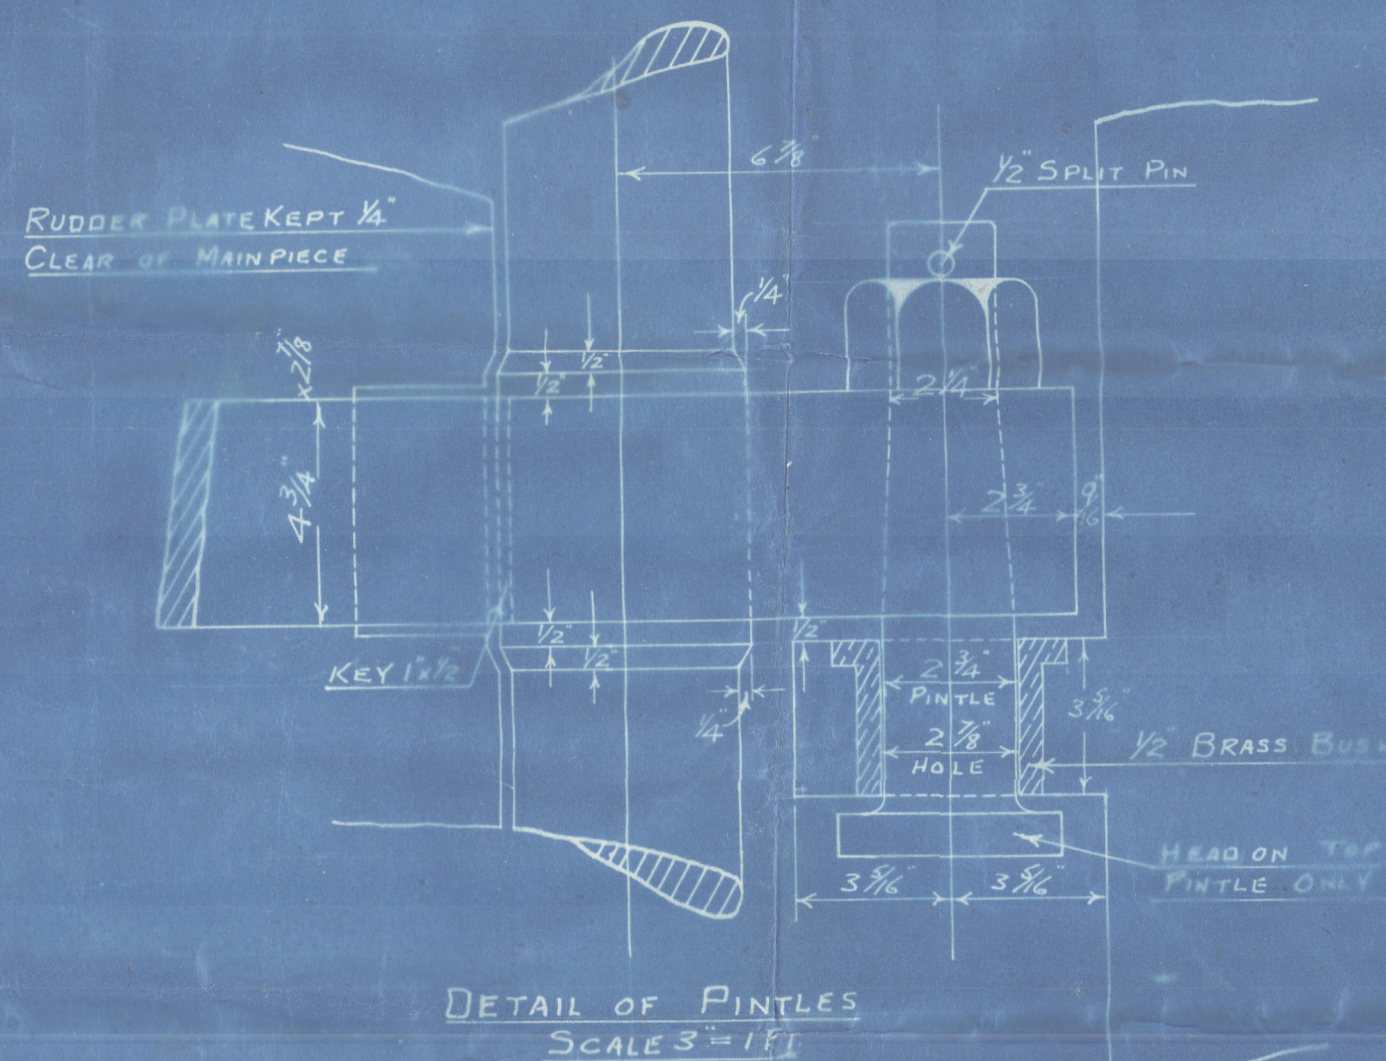


Nos 80-81


STERNFRAME & RUDDER

SCALE $\frac{3}{4}$ " = 1 FOOT



SPEED NOT EXCEEDING 10 KNOTS
TO CLASS LLOYDS 100 A1.

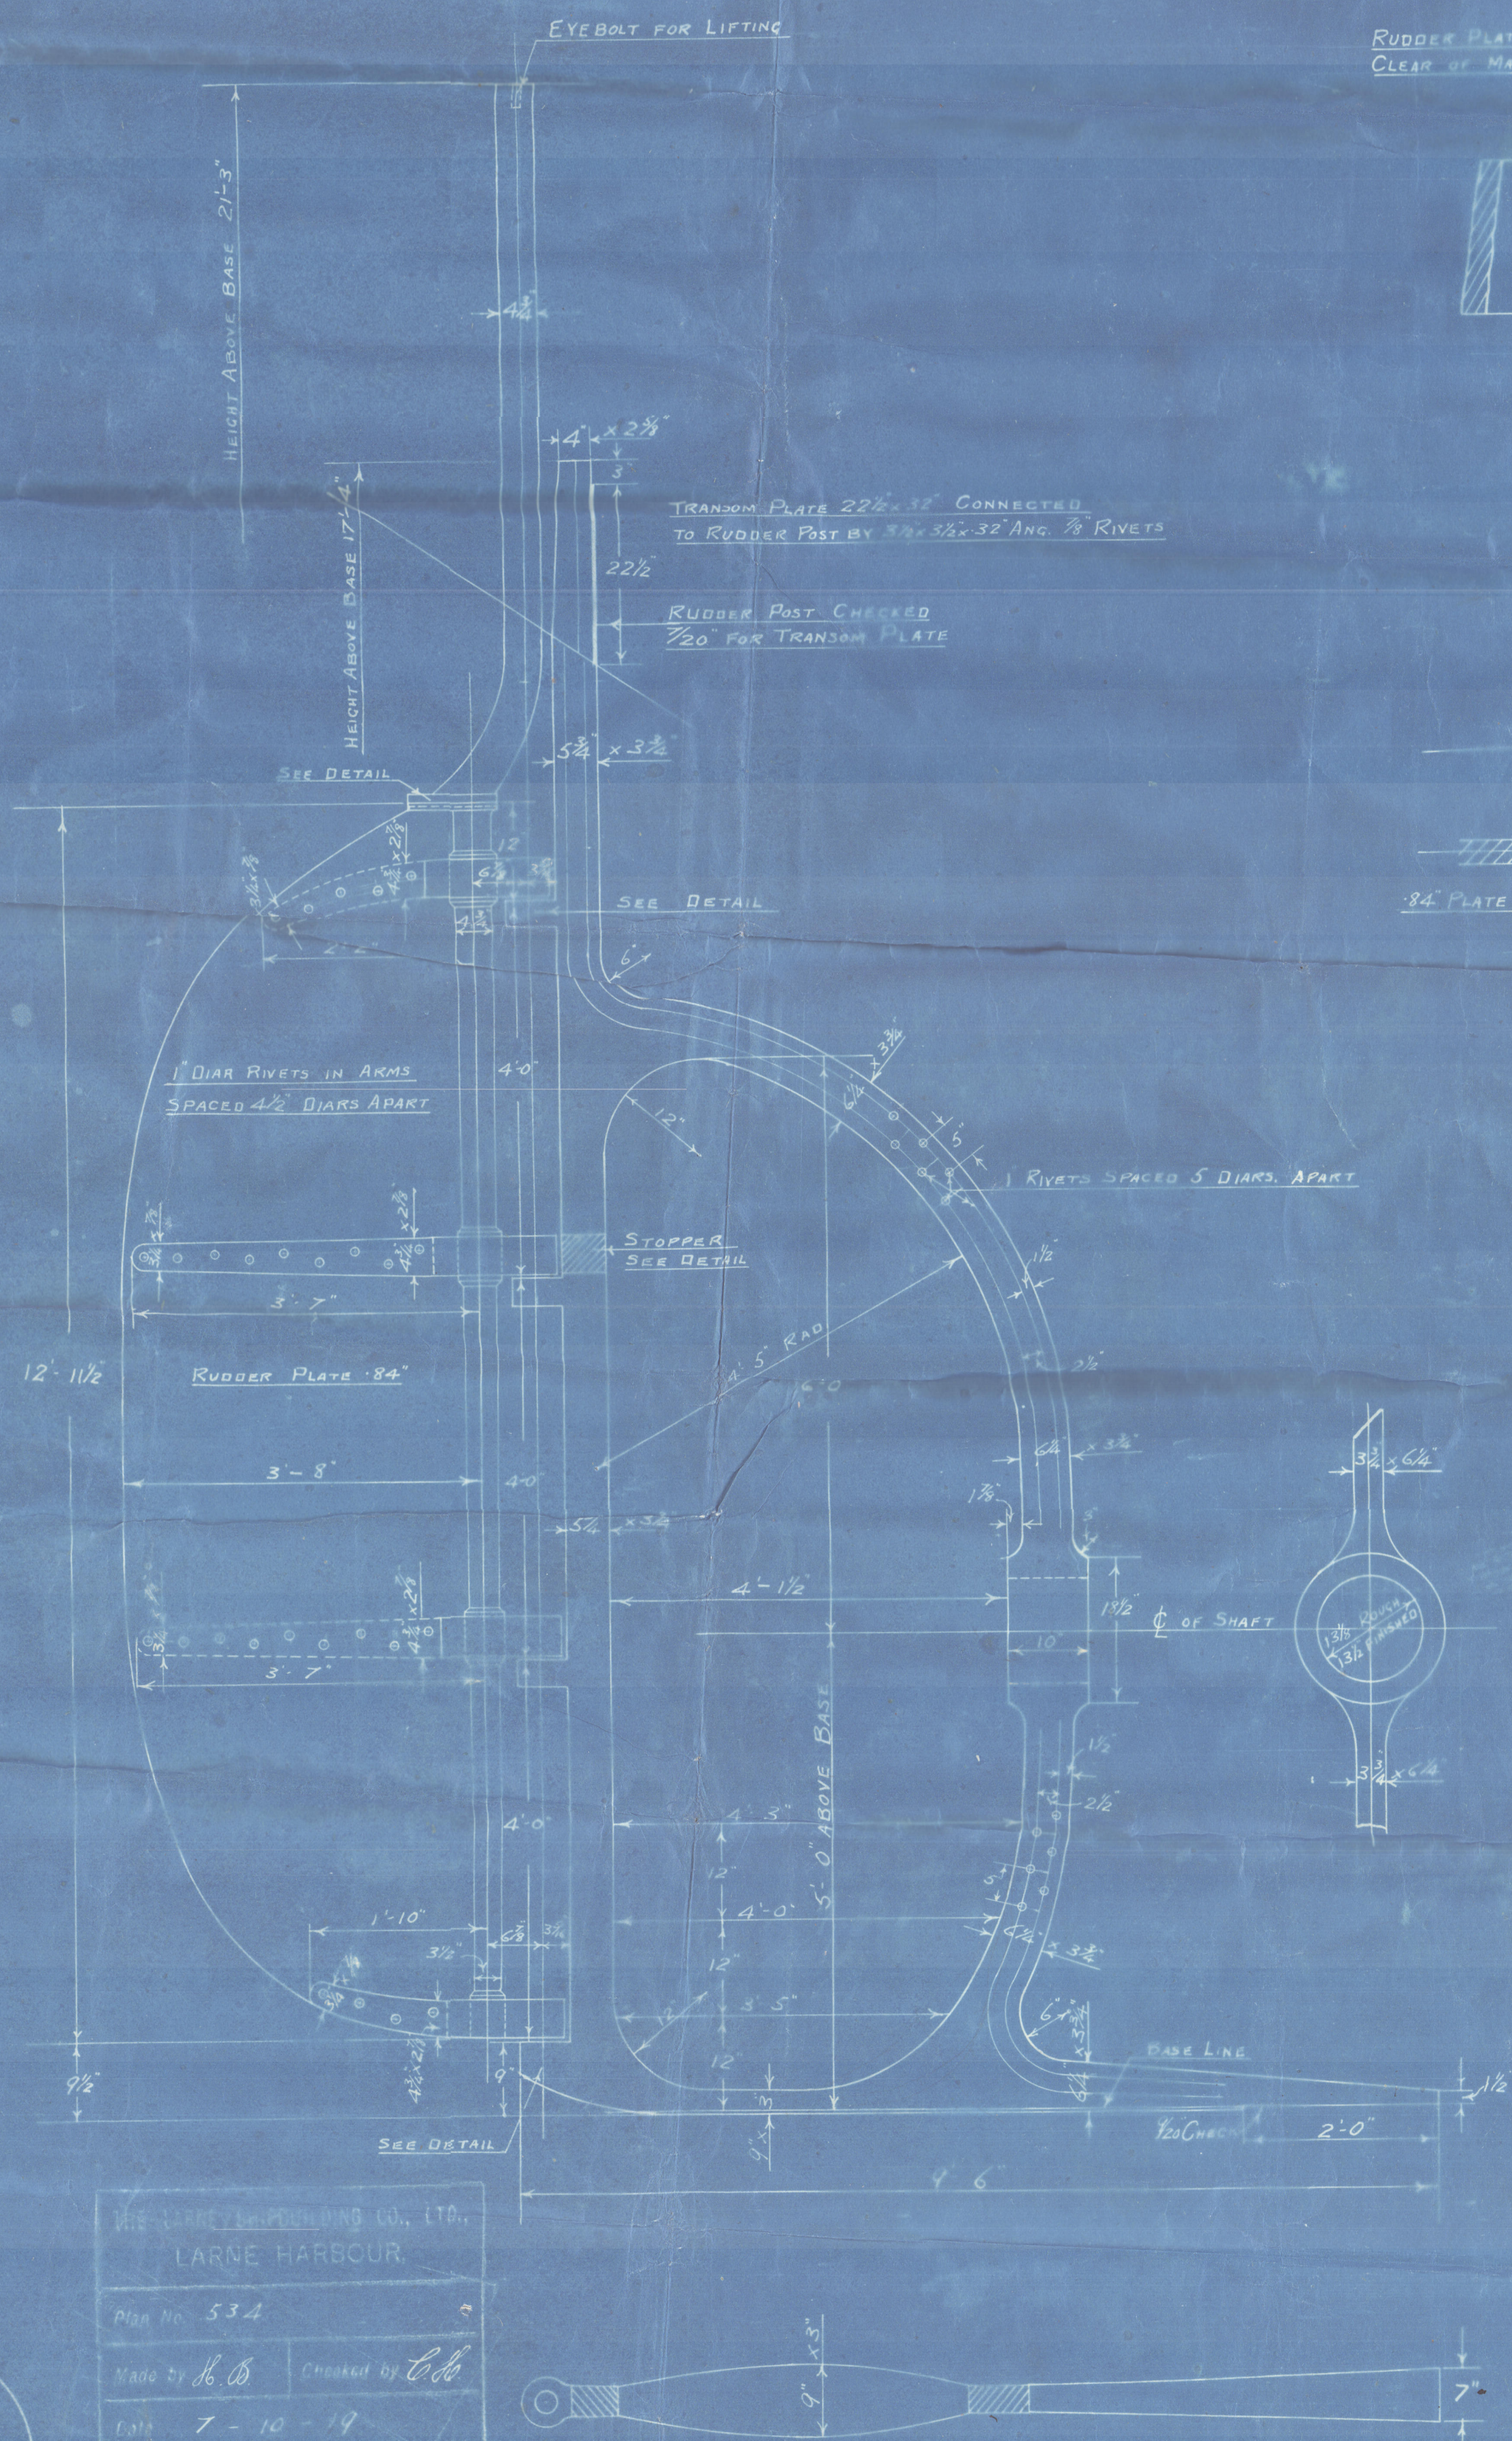


PLAN OF RUDDER ARM
SCALE 3\"/>

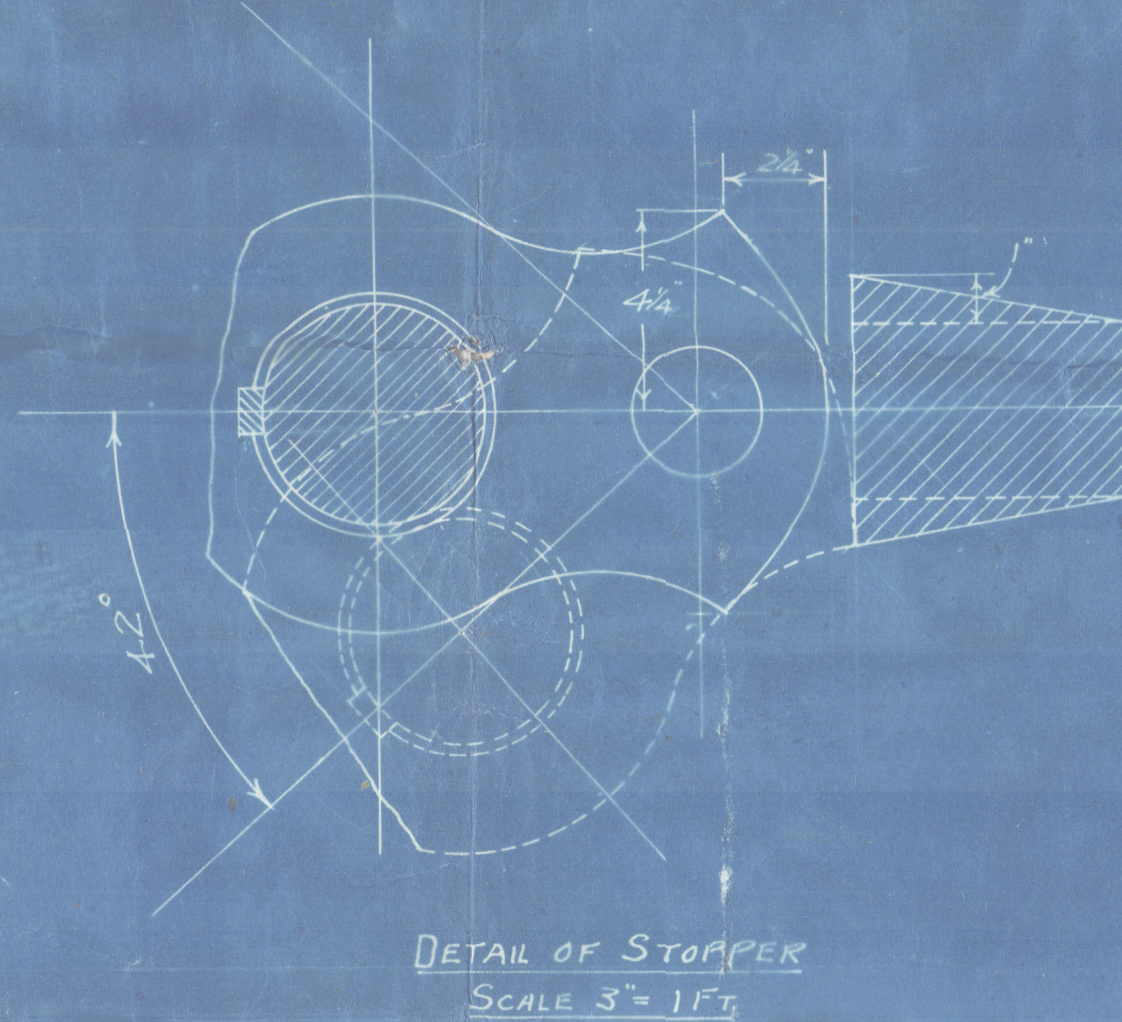

DETAIL OF STOPPER
SCALE 3\"/>

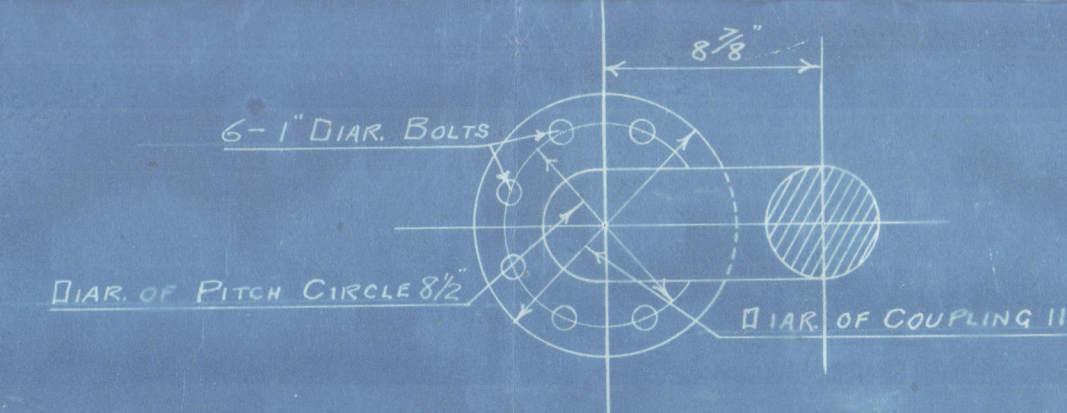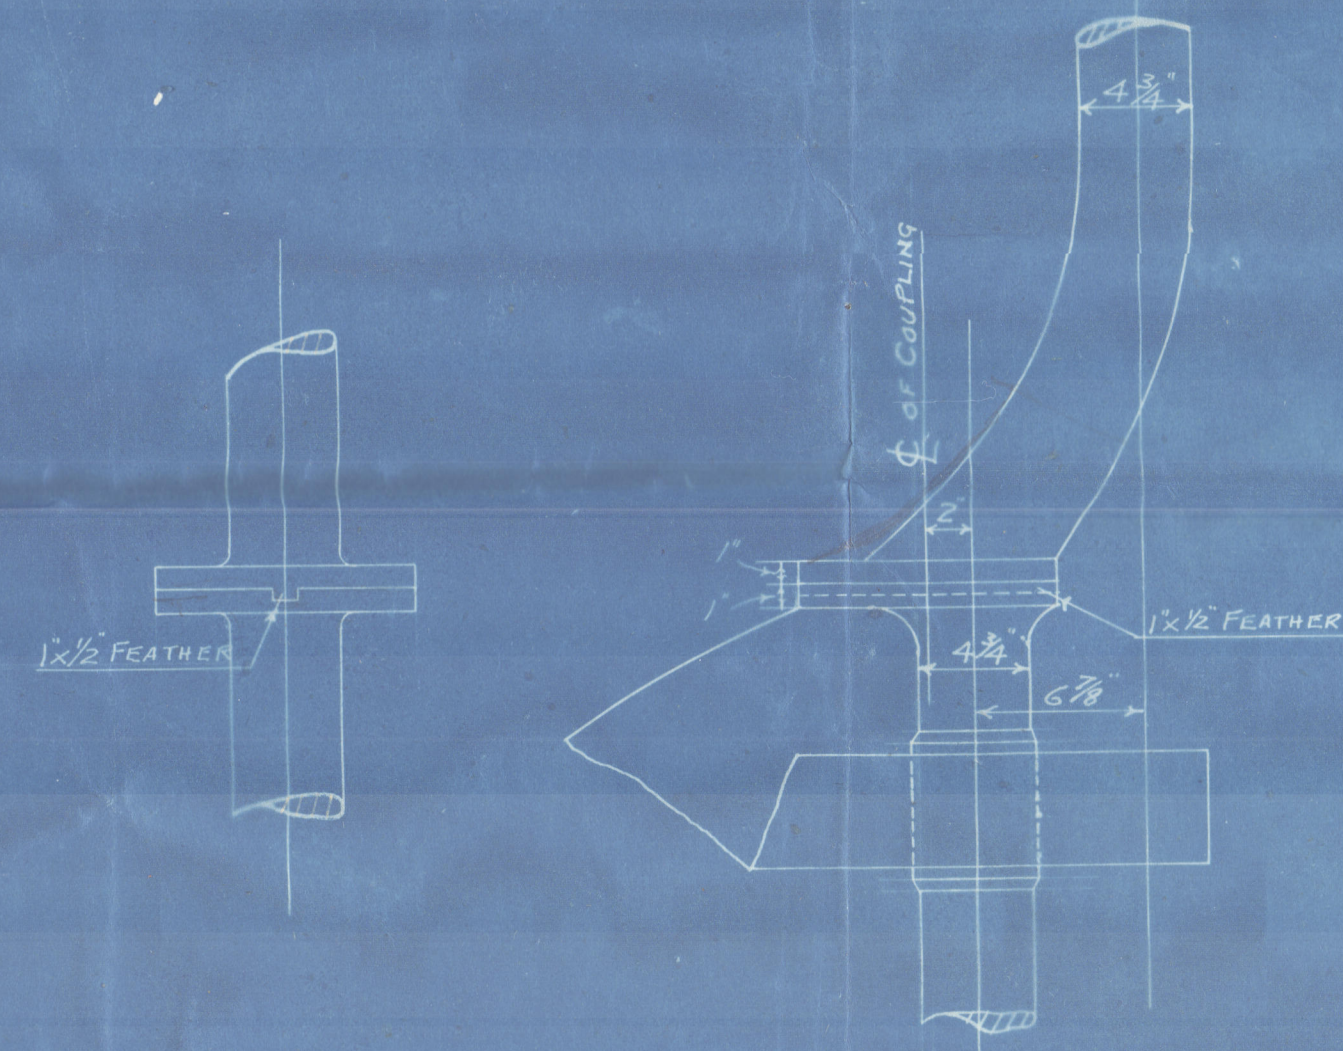

DETAIL OF COUPLING
SCALE 1\"/>

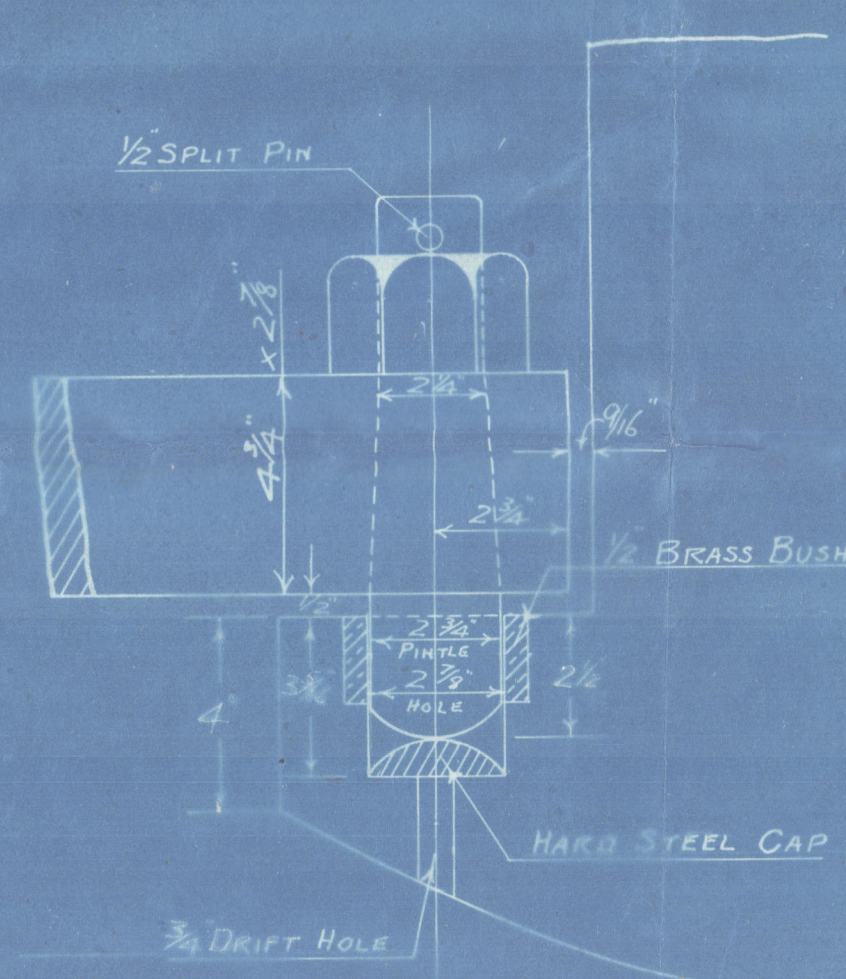

DETAIL OF BOTTOM GUDGEON
SCALE 3\"/>

THE LARNE SHIPBUILDING CO., LTD.,
LARNE HARBOUR.
Plan No. 534
Made by H. O. Checked by C. O.
Date 7-10-19

Nos. 80-81
+ 1m 86+87
Lloyds Approved
Sternframe & Kur
Received 16/10/19.

W. Broughley

GLASGOW REPORT No.
41464

002340-002351-0044

© 2020

Lloyd's Register
Foundation