

29.12.99

MIDSHIP SECTION  
SCREW STEAMER N°92  
SCALE 1/2 INCH = 1 FOOT  
TO CLASS 100 A.I. QUAR. DECK, BRIDGE & TOP<sup>ST</sup> FCS<sup>LS</sup>


DEPTH 10.95  
1/2 BREADTH 11.25  
1/2 GIRTH 19.95  
1<sup>ST</sup> N° 42.15 x 136 = 5732 = 2<sup>ND</sup> N°  
+ 56 of 1/8<sup>th</sup> = 400  
6132 = EQUIP<sup>T</sup> N°

PROPORTIONS  
BREADTH TO LENGTH = 6.04  
DEPTH = 12.42

EQUIPMENT

2 BOWER ANCHORS 5 3/4 CWT. EX. STOCK OR 1/4 CWT STOCKLESS  
1 STREAM 1 1/2  
1 KEDGE 3/4  
165 FATHOMS 1 1/2" STUD CHAIN CABLE MIN. WT 6A-1-11  
45 " 10" STREAM CHAIN OR 2 3/4" STEEL WIRE  
75 " 6 1/2" TOWLINE OR 2 1/2"  
90 " 4" HAWSER

FORECASTLE DECK BEAMS 4 1/2 x 3 x 20 on alternate frames  
" " " " STRINGER 20 x 20 to 16 x 20 Angle 2 1/2 x 2 1/2 x 5  
" " " " TIES 4 x 20 DECK 2 1/4 PINE  
BRIDGE DECK BEAMS 4 x 2 1/2 x 20 on alternate frames  
" " " " STRINGER 20 x 20 Angle 2 1/2 x 2 1/2 x 5  
" " " " TIES 4 x 20 DECK 2 1/4 PINE

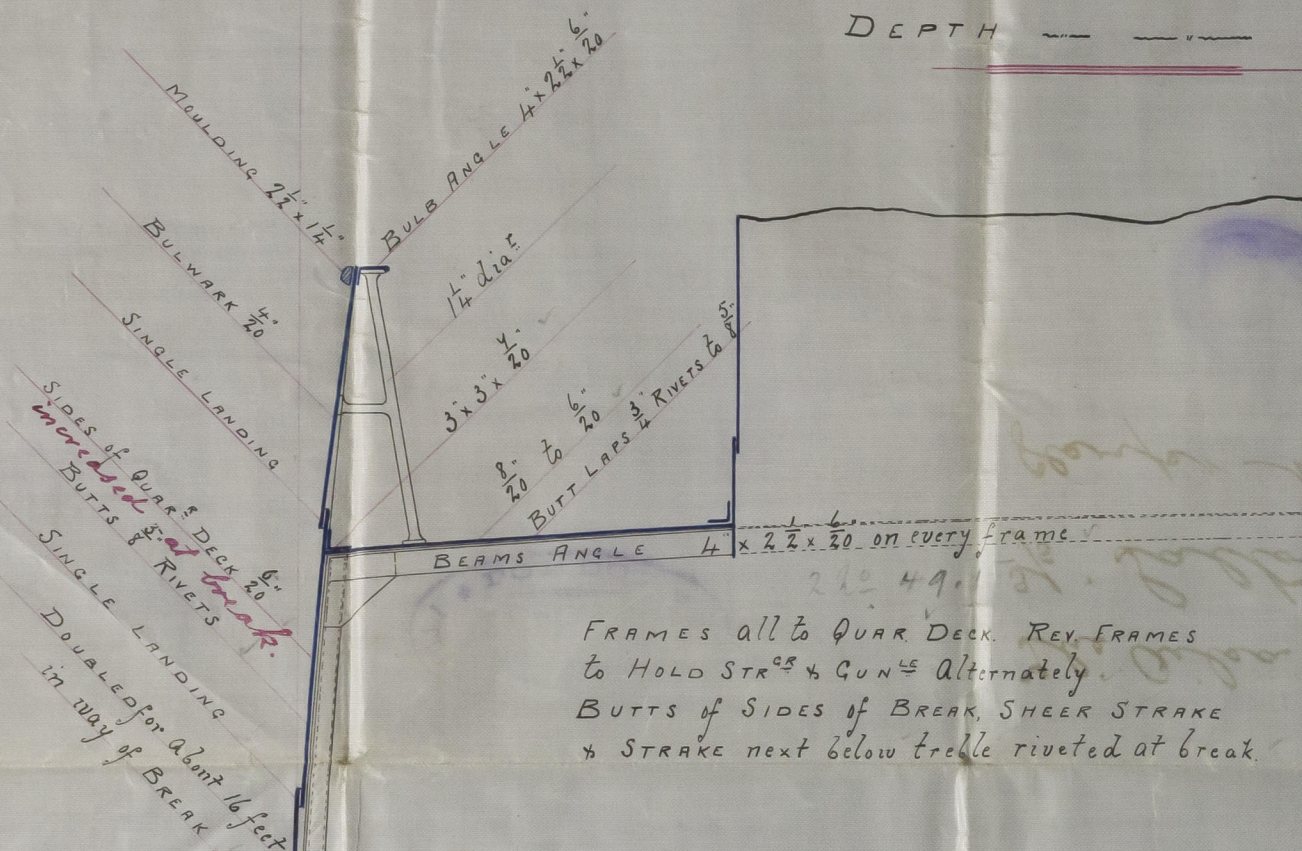


FRAMES ALL TO QUAR. DECK. REV. FRAMES TO HOLD STR. & GUN. ALTERNATELY  
BUTTS of SIDES of BREAK, SHEER STRAKE & STRAKE next below treble riveted at break

RIVETING  
KEEL STEM & STERN POST 1" RIVETS 5 CENTRES  
RUDDER 1/8 RIVETS 4 3/8 CENTRES  
FRAMES, REV. FRAMES, FLOORS, KEELSONS & BEAM ANGLES 8 RIVETS 4 3/8 CENTRES  
3/4 & 1/8 RIVETS thro frame & shell  
CENTRE KEELSON 3/4 RIVETS throughout  
OTHER KEELSONS 3/4. GUN ANGLE 3/4 RIVETS 3 CENTRES  
IRON DECK Single Landing 5 RIVETS 2 3/4 CENTRES  
BUTT LAPS 5 RIVETS double for 1/2 L. single at ends & thro beams 4 3/4 CENTRES  
BUTT LAPS of STRINGER double riveted  
SHELL BUTT LAPS treble riveted for 1/2 L double at ends  
BUTTS of SHEER STRAKE all double riveted & STRAPS 20 thicker for 1/2 L  
BUTTS of CARBOARD STRAKE double riveted

NOTE RIVETS IN BUTTS of OUTSIDE PLATING & STRINGERS spaced 3 1/2 dia apart & 4 to 4 1/2 dia apart in edges of PLATING & at other parts

DEPTH 11'0" (with normal round of beam 10'11 1/2")  
HOLD TO FLOORS 9'9"

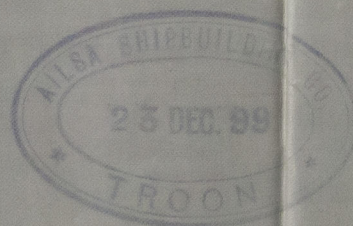

29.12.99

29.12.99



© 2020

Lloyd's Register Foundation

002340-002351-0030




27 DEC 1892  
LONDON

The Ailsa 3136-1892  
3/5 Salton  
flap 185-91

Tanner

9

10.15.00

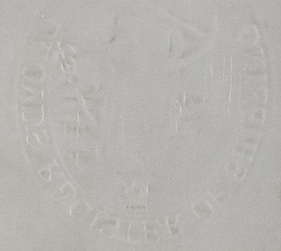

92

002340-002351-0020








© 2020



Lloyd's Register  
Foundation