




29.12.99

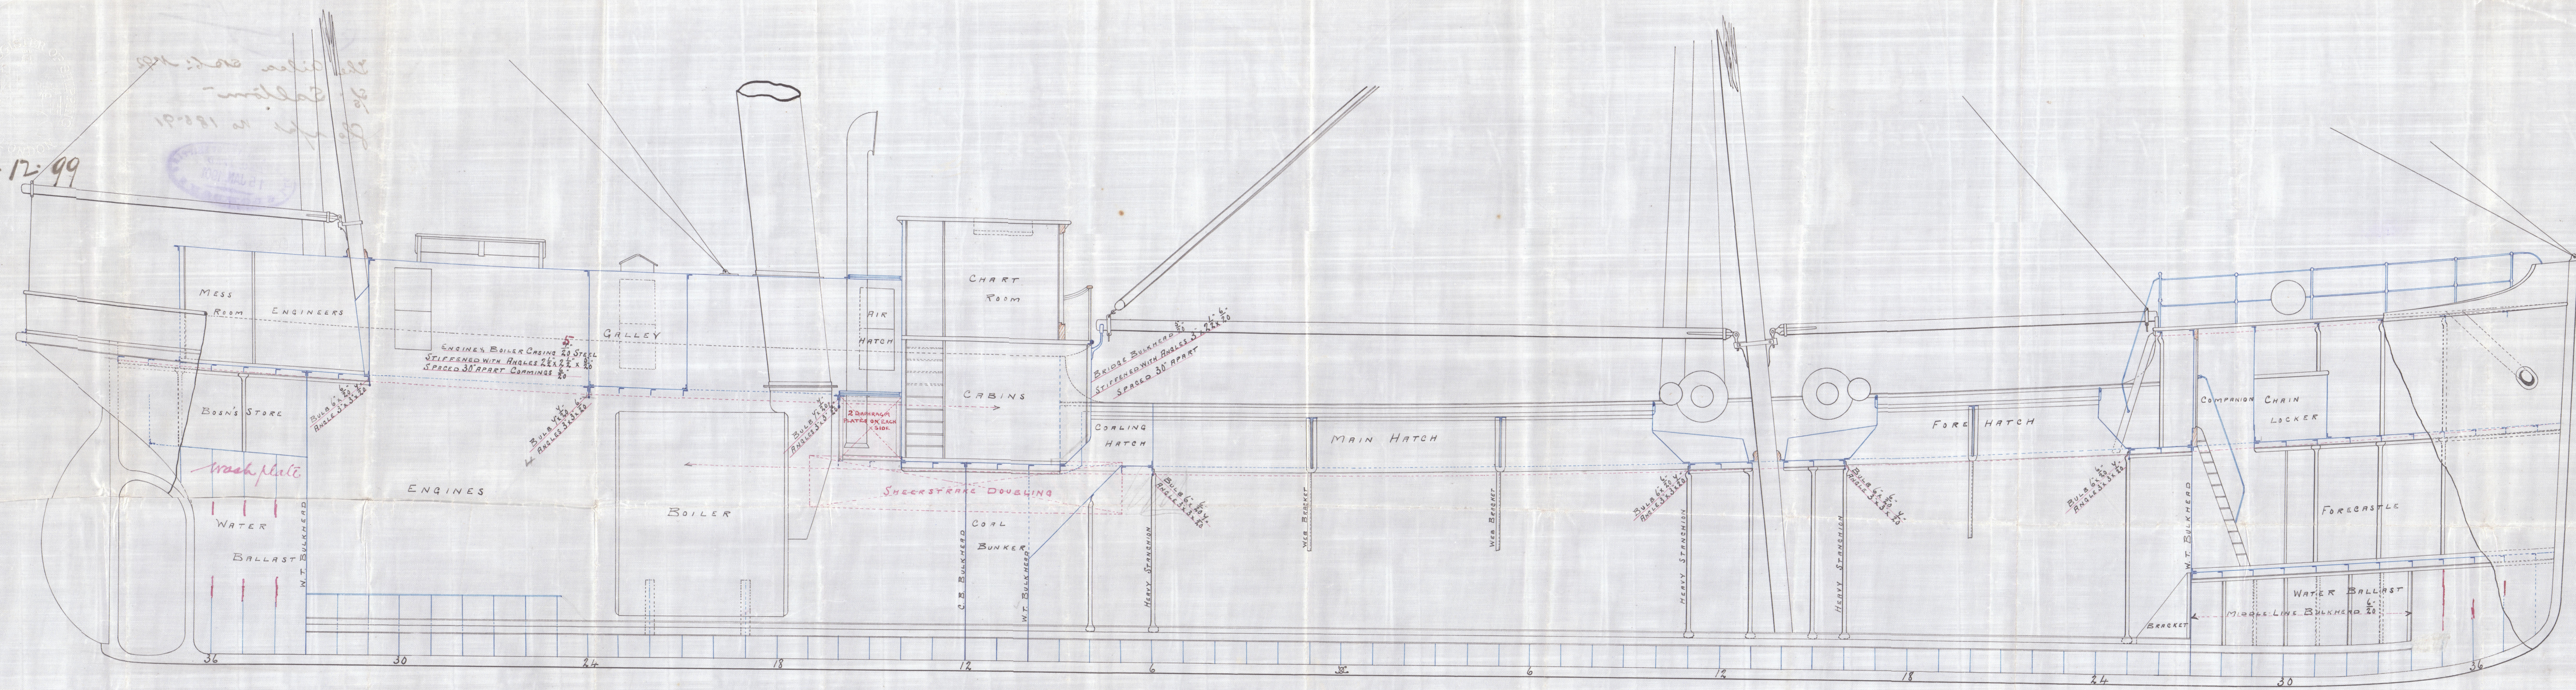

Bottom strengthened as per circular 10/8.

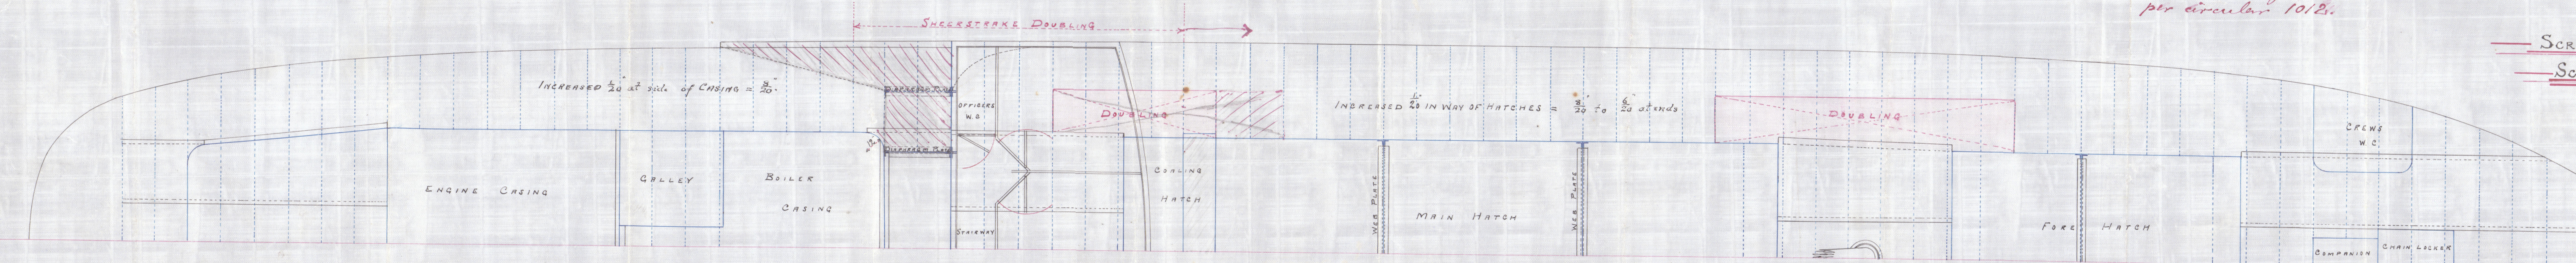

SCREW STEAMER N°92
SCALE 1/4 INCH = 1 FOOT

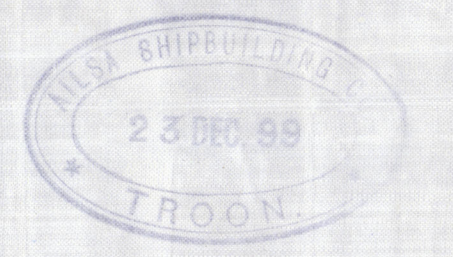


29.12.99

29.12.99

92

The Ailsa sub: N°92
S/S. Saltom-
flo rpt no 188-91

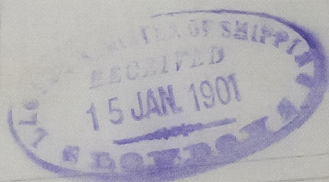

002340-002351-0081



© 2020

Lloyd's Register
Foundation