


2.3.11

PROFILE AND DECK PLANS.

DIMENSIONS LENGTH BP 365' BREADTH MLD 47' DEPTH MLD 29'6"

SCALE 1/4" = ONE FOOT

ISHERWOOD SYSTEM (PATENT)

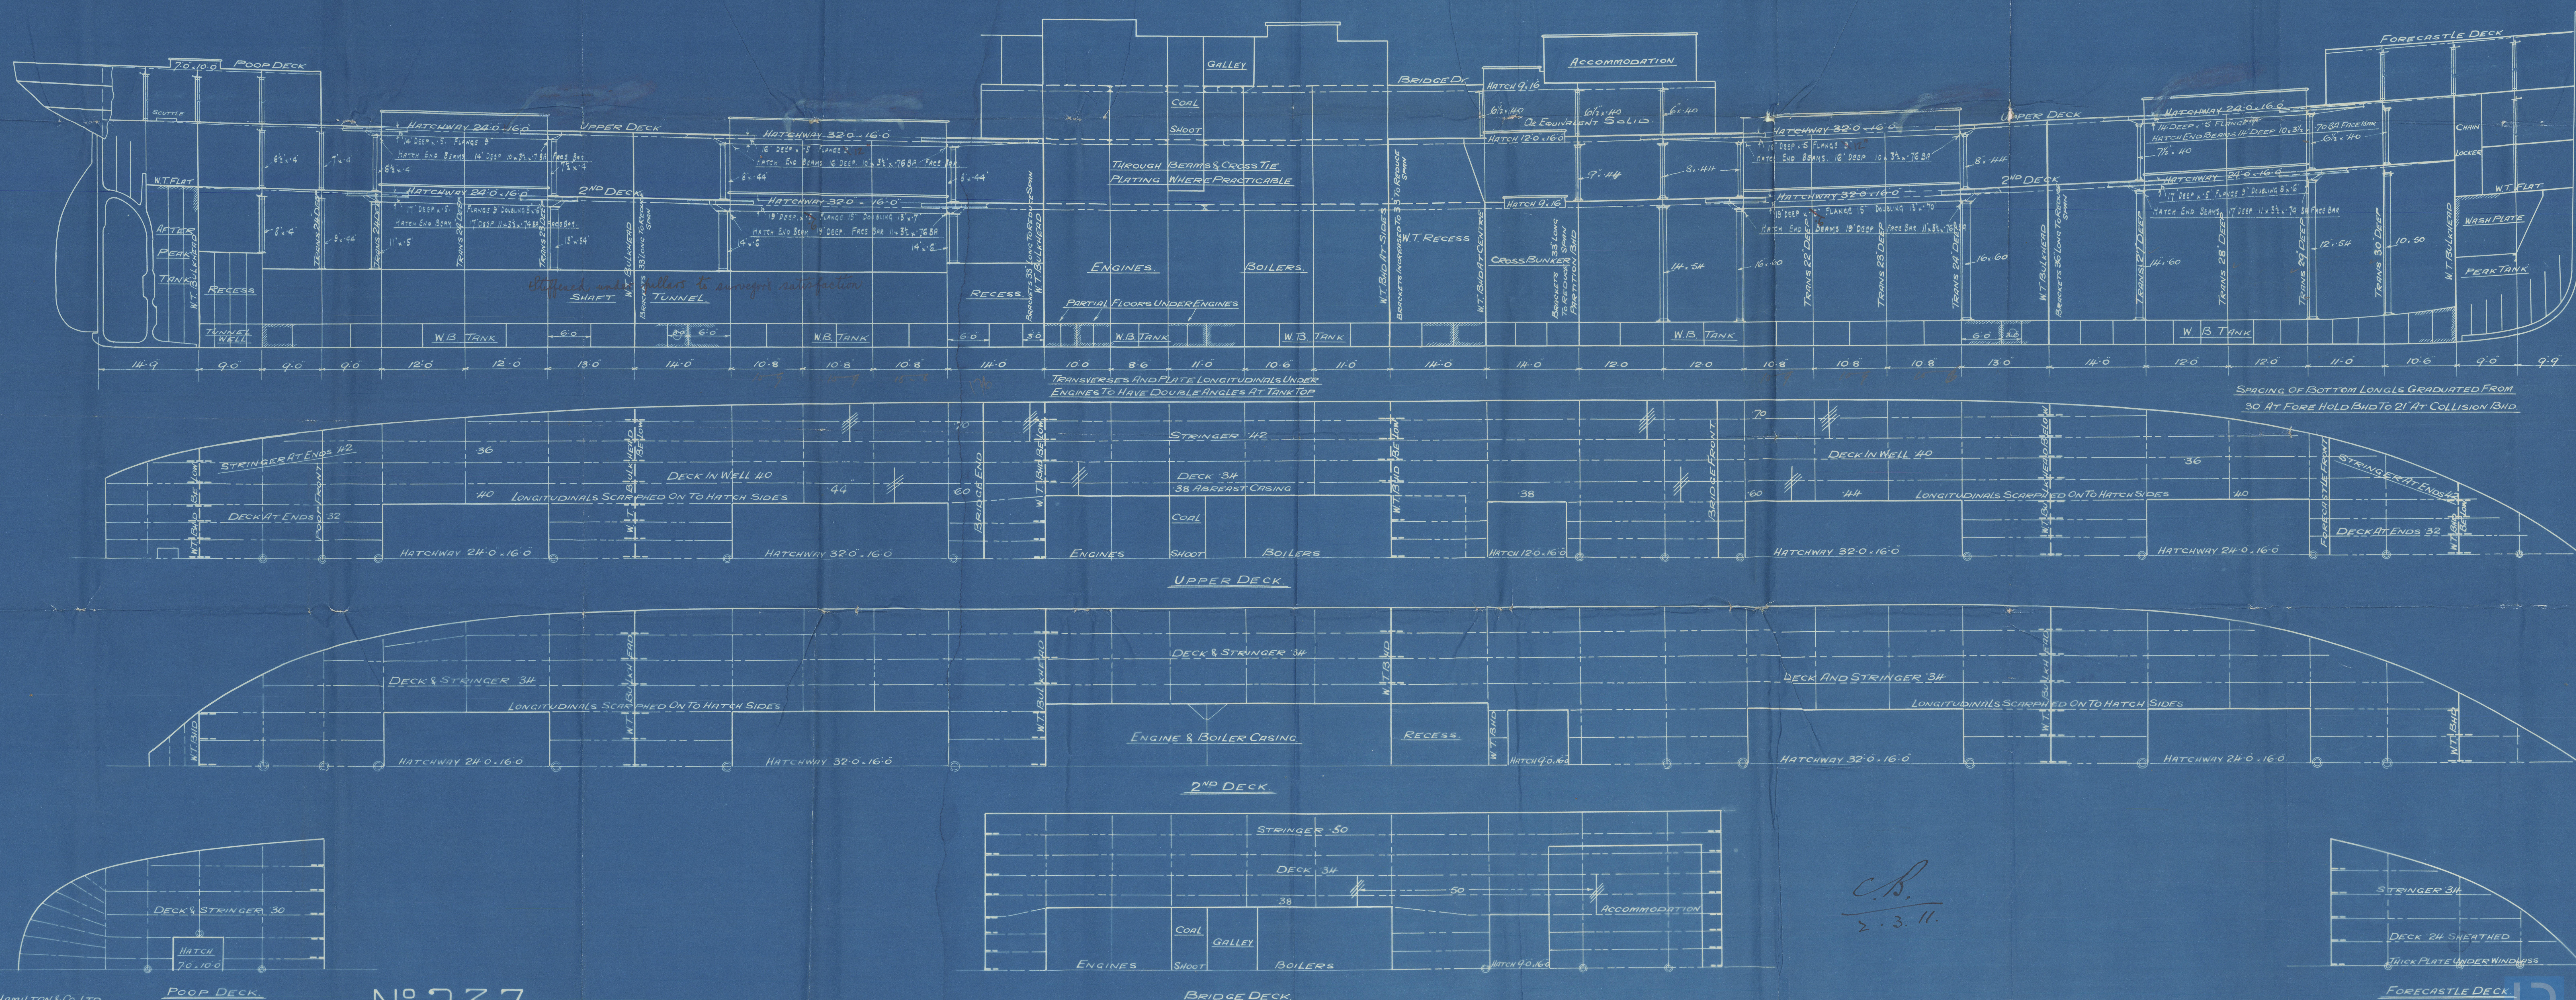

25/2/11

Messrs W. Hamilton & Co. Ltd.  
PORT GLASGOW.

Nº 237


C.B.  
2.3.11.



237

Profile + spec ✓

Correct Plan

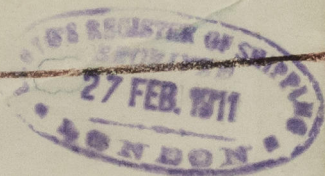

002352-002361-0001



© 2020

Lloyd's Register  
Foundation




Profile & Deck Plan

Wm Hamilton & Co's

No 234

G. Intombi

Greenock Report No. 16284

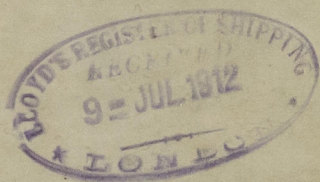

© 2020

Lloyd's Register

002352-002361-0001