

(1041) 11/7/27. (1048) 22/12/28  
 PLAN No. 6827  
 FOR ENCLOSURE TO  
 Messrs. The Surveyors  
 Lloyd's Hull. FROM  
 COCHRANE & SONS, LTD.  
 SHIPBUILDERS, SELBY.  
 DATE 8/7/27.

# PROFILE & DECK.

STEEL SCREW TUG.



Nº 1010.

DIMS: 80'-0" B.P. x 22'-0" EX. x 2'-3" MLD.

SCALE 1/4" = 1 FT.

TO CLASS 190 A LLOYDS

Bulkhead Stiff.  
 6 x 3 x 36 L } invariable; speed  
 5 x 3 x 34 L } to 3 x 3 x 30 L in line.  
 17/8/27

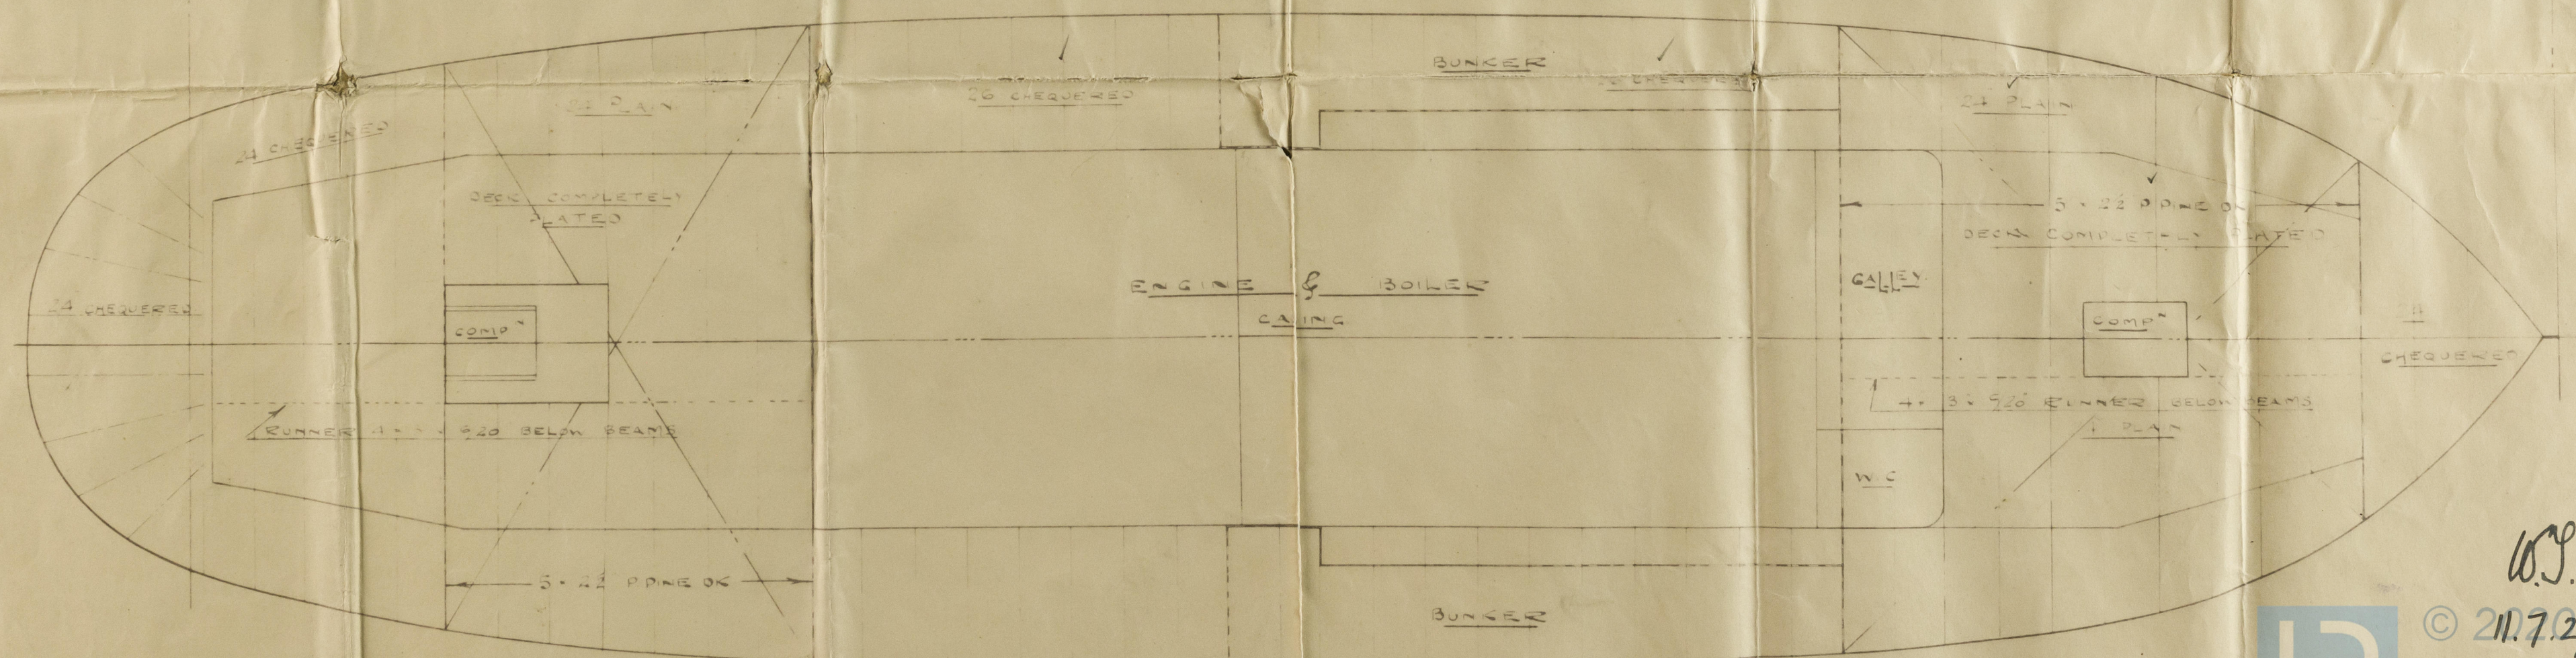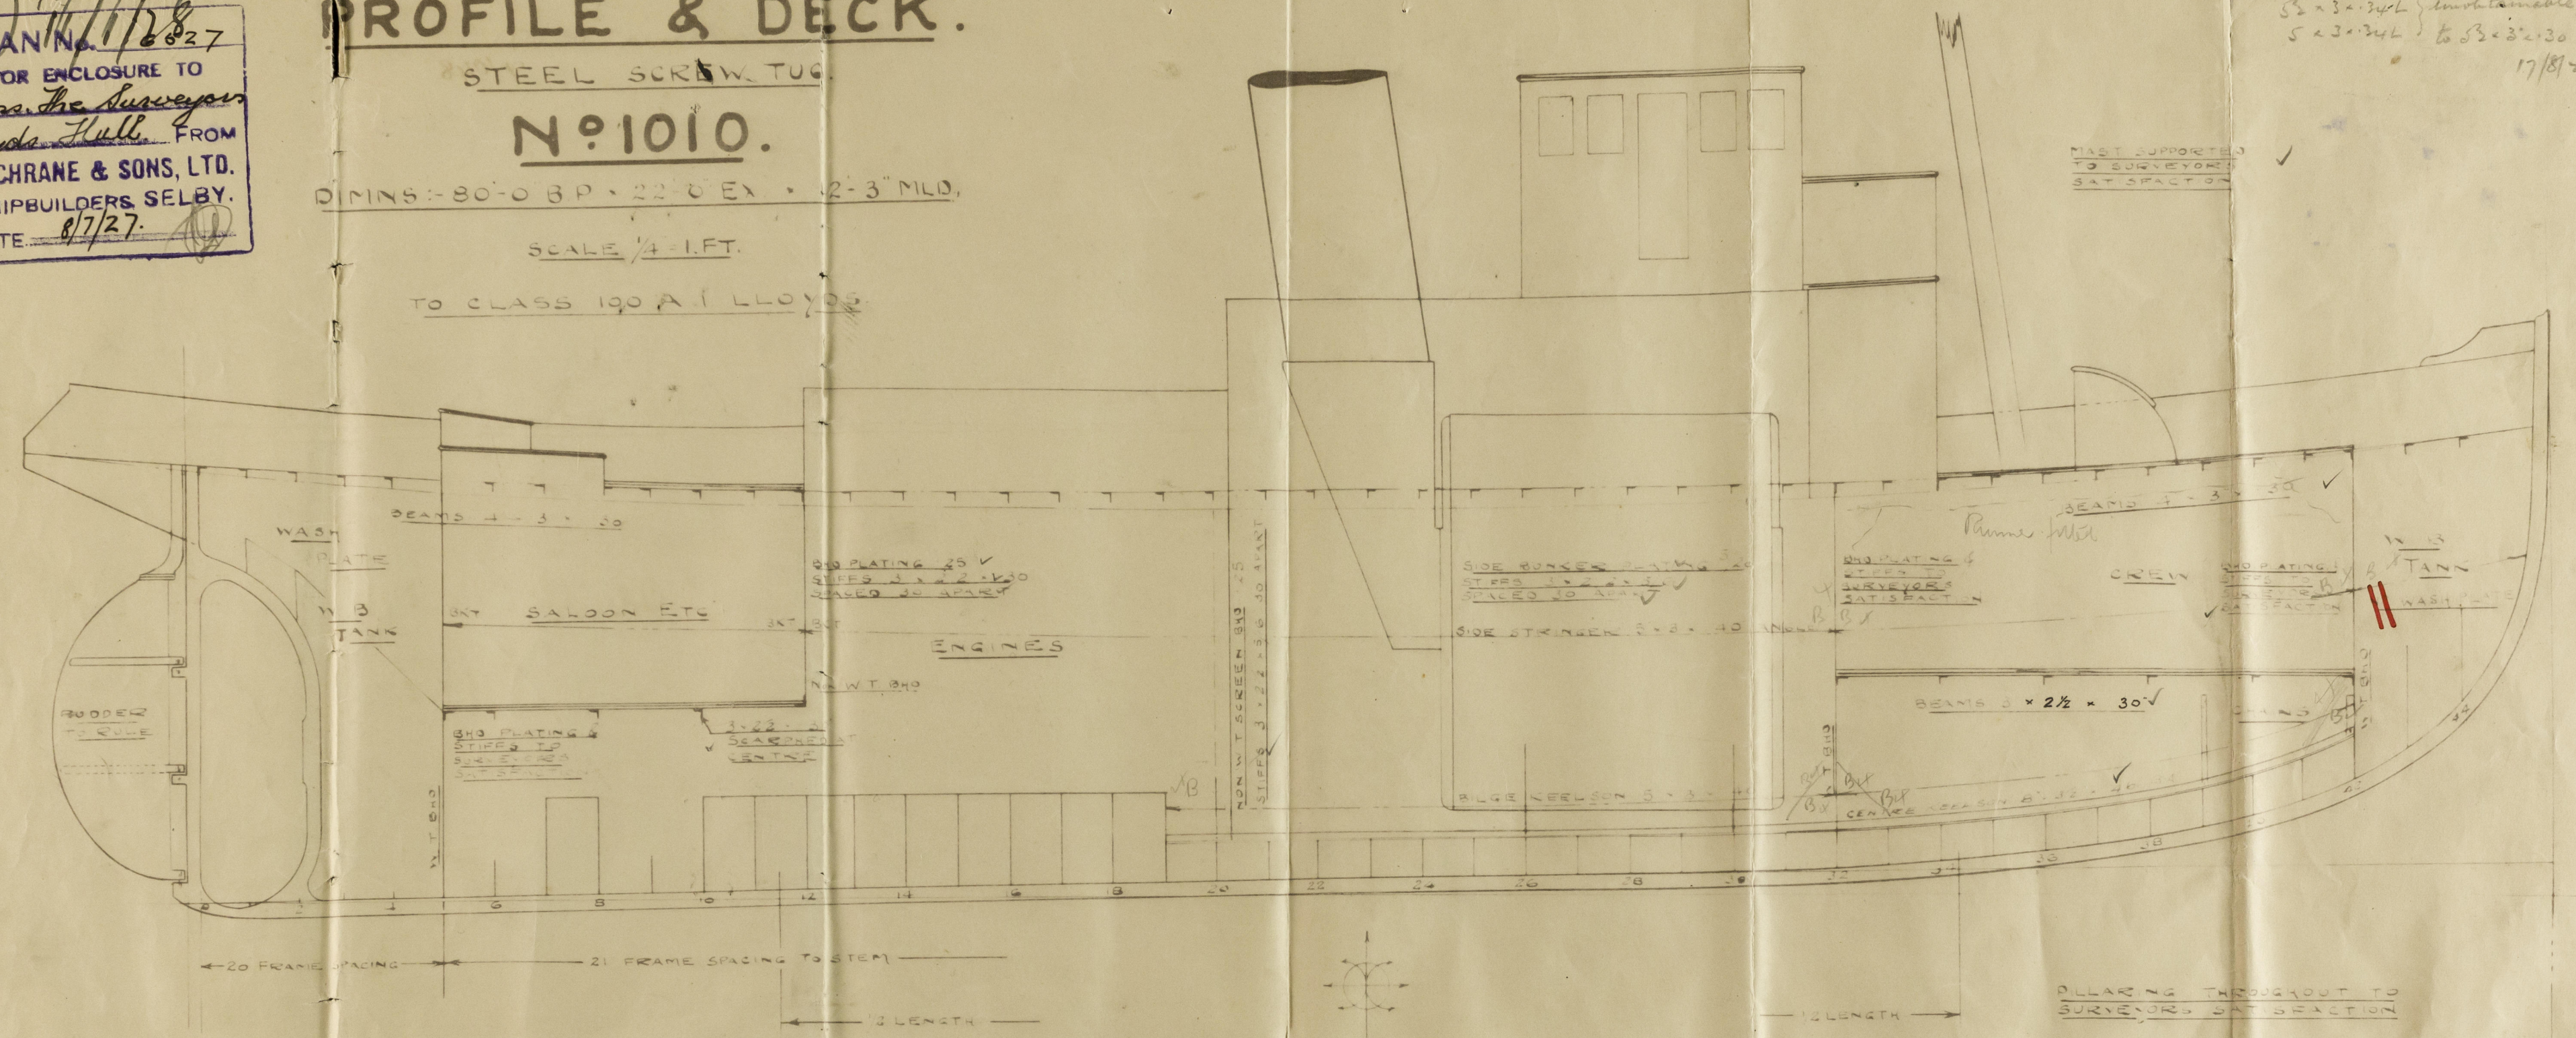



Profile & Deck plan for

Bohranes No 1070. 47011  
91048.

S.T. Abeille No 14


Hull Rpt 38506.

S.S. "Abeille No 18"


HULL REPORT No. 38949

S.S. "Abeille No 17"

HULL REPORT No. 39973

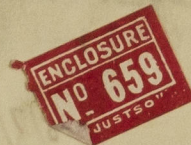

002352-002361-0153

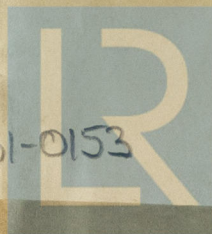

© 2020

Lloyd's Register  
Foundation