

For the information of Surveyors and the Committee only.

Received at

Office 24 NOV 1927

Lloyd's Register of Shipping

(Report on Vessel No. 38506 Port *Andal*)



SHIP FORGINGS OR CASTINGS.

I have to report that the undermentioned Iron or Steel Forgings or Castings, manufactured by *Mr J. S. Forster & Son Ltd* of *Sunderland* for the Vessel No. *1010*, being built by *Cochrane & Son Ltd* of *Selly* have been inspected by me as set forth below and found to be, so far as can be seen, *Sound*.

Forgings or Castings.

Lloyd's

No. *4502*

22.5.27

D. D. Williamson

Sunderland, 22.8.27

STERN FRAME.

RUDDER FRAME.

STEM.

Scrap Iron Forged

5 1/2" x 2 3/4"

Forged & Finished

4-8-27 to 22-8-27

CASTINGS.

on Standard Test Pieces.

Test—

per square inch

ension per cent. ...

ending Test—

e before fracture



est—

ht from ground ...

ering Test—

ade according to Rules
d found satisfactory ...

SKETCHES OF FRAMES SHOWING POSITION AND DESCRIPTION OF WELDS OF FORGINGS.

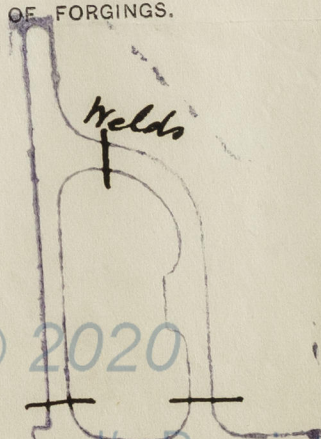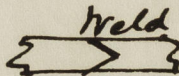

Fee (if any chargeable) £

To be paid at

of Iron, state whether scrap or puddled Iron. If of Steel, state whether made on the Open Hearth process.

S. T.

002352-002361-0158