

# Nº 604SHIP

## MIDSHIP SECTION

DIMENSIONS:- 155'-0" B.P. x 26'-0" B.DTH. MLD. x 15'-0" DEPTH MLD.

CLASS 100.A.1 STEEL SCREW STEAM TRAWLER


SCALE 1/2" = ONE FOOT

### Equipment

1 Stockless Anchor	9 1/4 cwt.	✓
1 do. do.	8 3/4 do.	✓
1 Rodgers Anchor	3 3/4 do. [Ex Stock]	✓
135 faths. 1 3/16" Stud Link Cable	✓	
60 do. 6" Hawser	✓	
60 do. 5 1/2" Warp	✓	

### Lloyds Numerals

L x D	2325	✓
B x D	41	✓
L x (B + D)	6355	✓
D	15' 00	✓
"d"	13' 50	✓
L/D	10.33	✓
L/B	5.96	✓

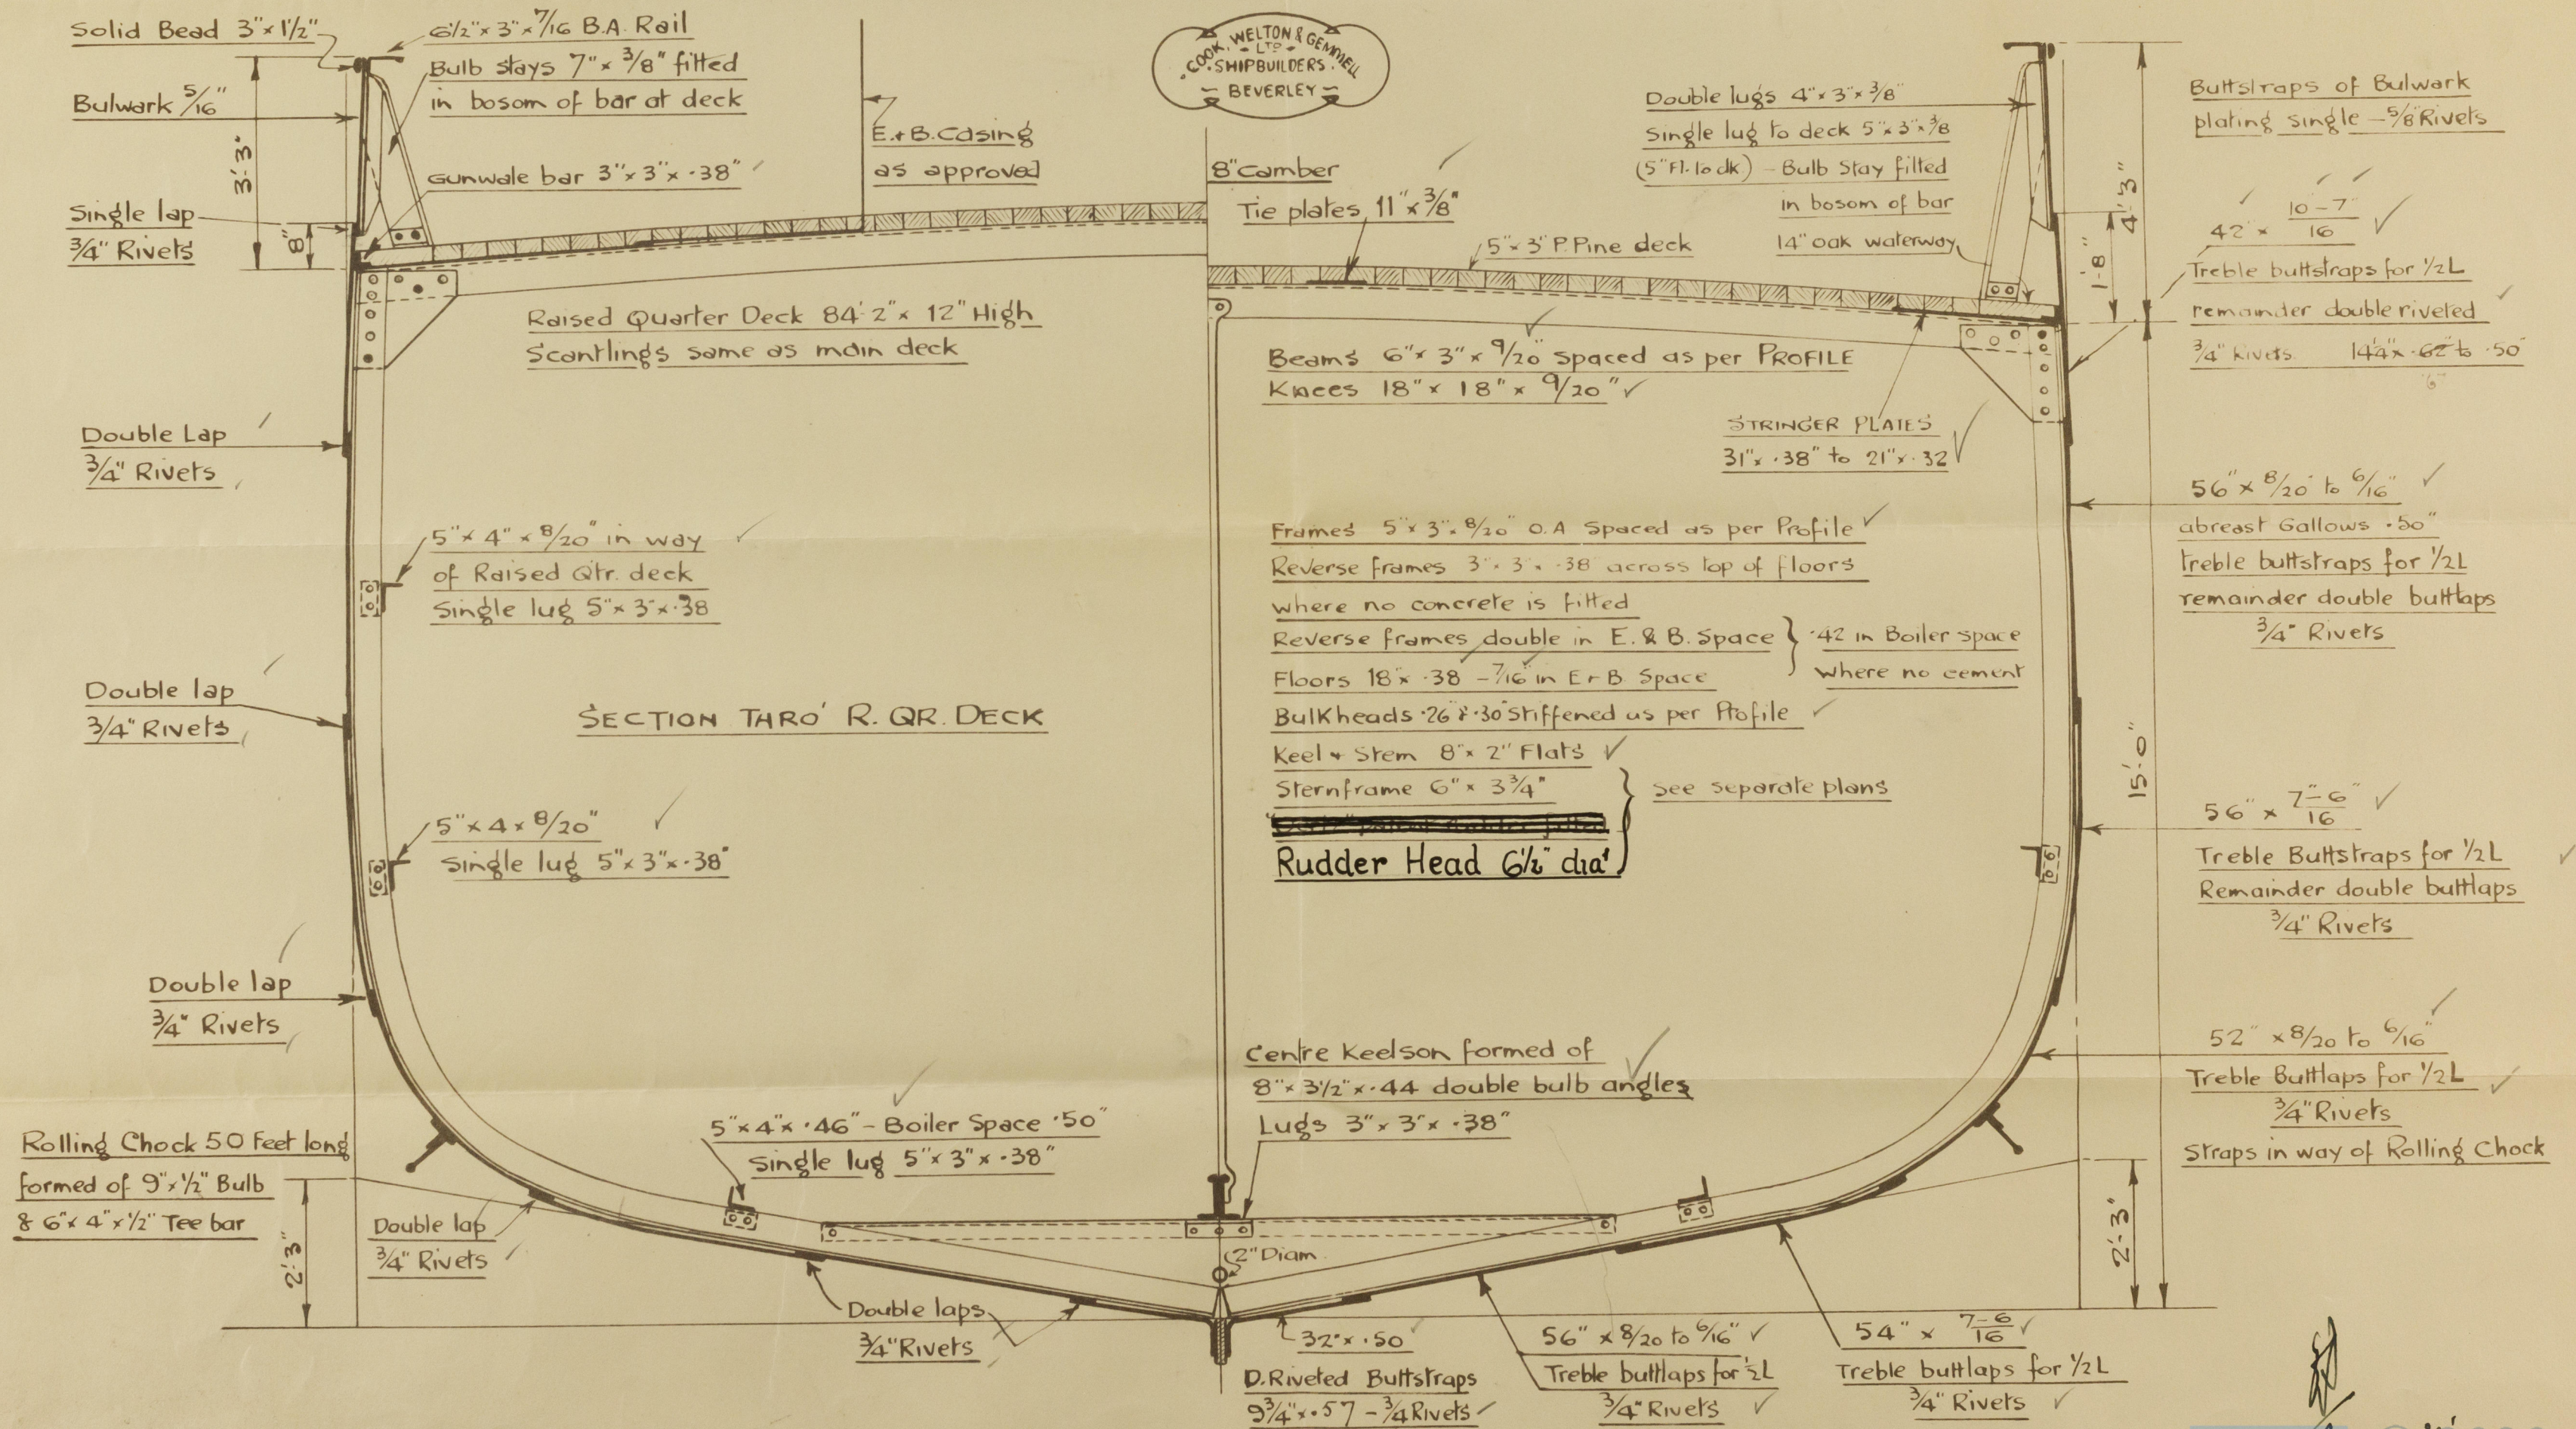

APPROVED BY LLOYDS



HULL

book, Belton & Gemmell's  
Yard No 604

— " —

Midship Section.

GEN BOX NO 711

2

\* 8/5 Thornwick Bay

N.N. AFRIDI



© 2020

Lloyd's Register  
Foundation

002367-002373-0066