

LLOYD'S
STAMP
18/2/20

PROFILE AND DECK

Nos 701 & 2



STEEL 'SCREW STEAMERS


DIM^s 175'-0" BP x 23'-0" Ex x 13'-6" MOULDED

1/4" SCALE

PLAN No. 4044
FOR ENCLOSURE TO
Messrs Lloyd's Surveyors
Steel
FROM
COCHRANE & SONS, LTD.
SHIPBUILDERS, SELBY.
DATE 1/4/20

BULB ANGLES SHOWN 5 1/2" x 3" INSTEAD OF RULE SIZE
ARE ALTERED TO EXPEDITE DELIVERY OF MATERIAL

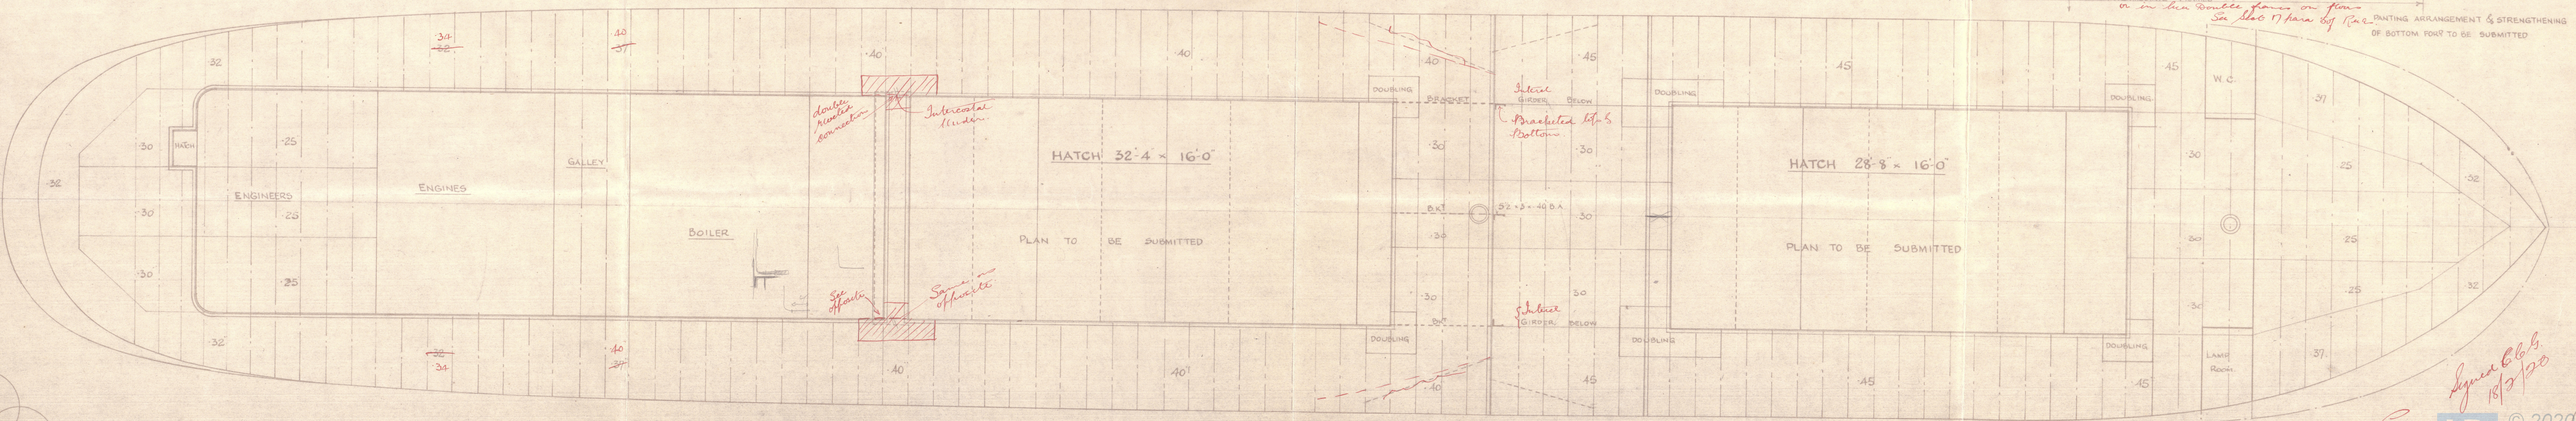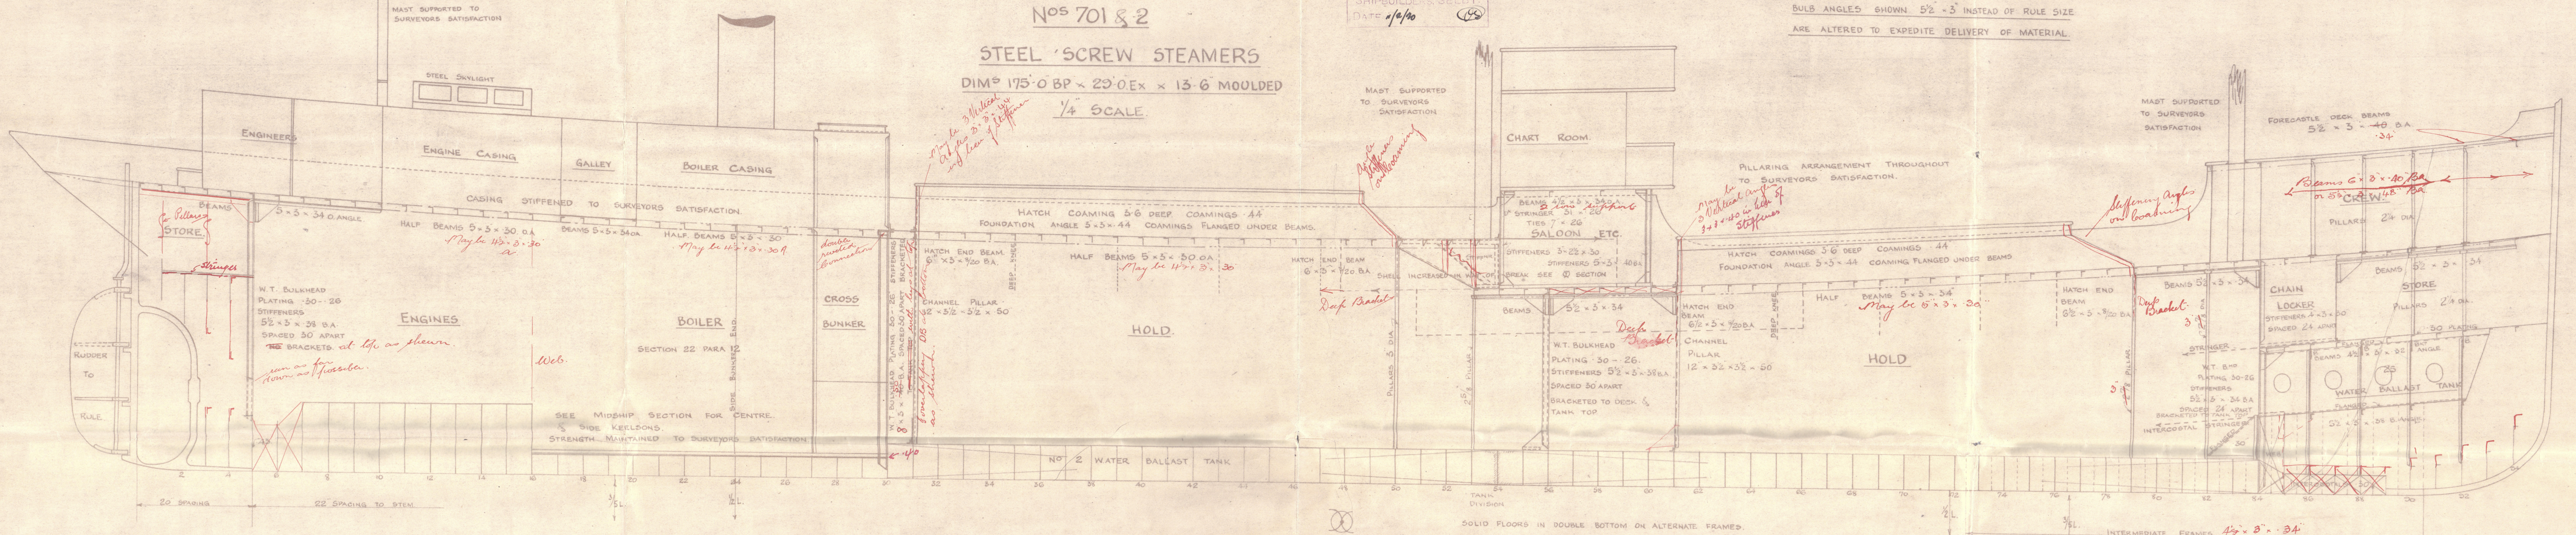

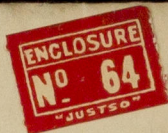

N^{os} 701-Z

Profile & Deck Plan
Cochrane & Sons Ltd
Copy of approved Plan

PLAN No. _____
FOR ENCLOSURE TO
Sub B
3079.
CITY OF LONDON
SHIPPING OFFICE
LONDON

RETAIN

S.S. "Kewrix."

Atl. 32830.

Tolker



© 2020

Lloyd's Register
Foundation

007362-002373-0098