


# PROFILE & DECK PLAN

SCALE 1/4" = 1 FOOT

ALL BULB ANGLES, CHANNELS ETC. ON THIS PLAN ARE (NEW BRITISH STANDARD.)

DIMENSIONS :- LENGTH B.P. 100'-0" BREADTH MID 23'-0" DEPTH MID 11'-0"

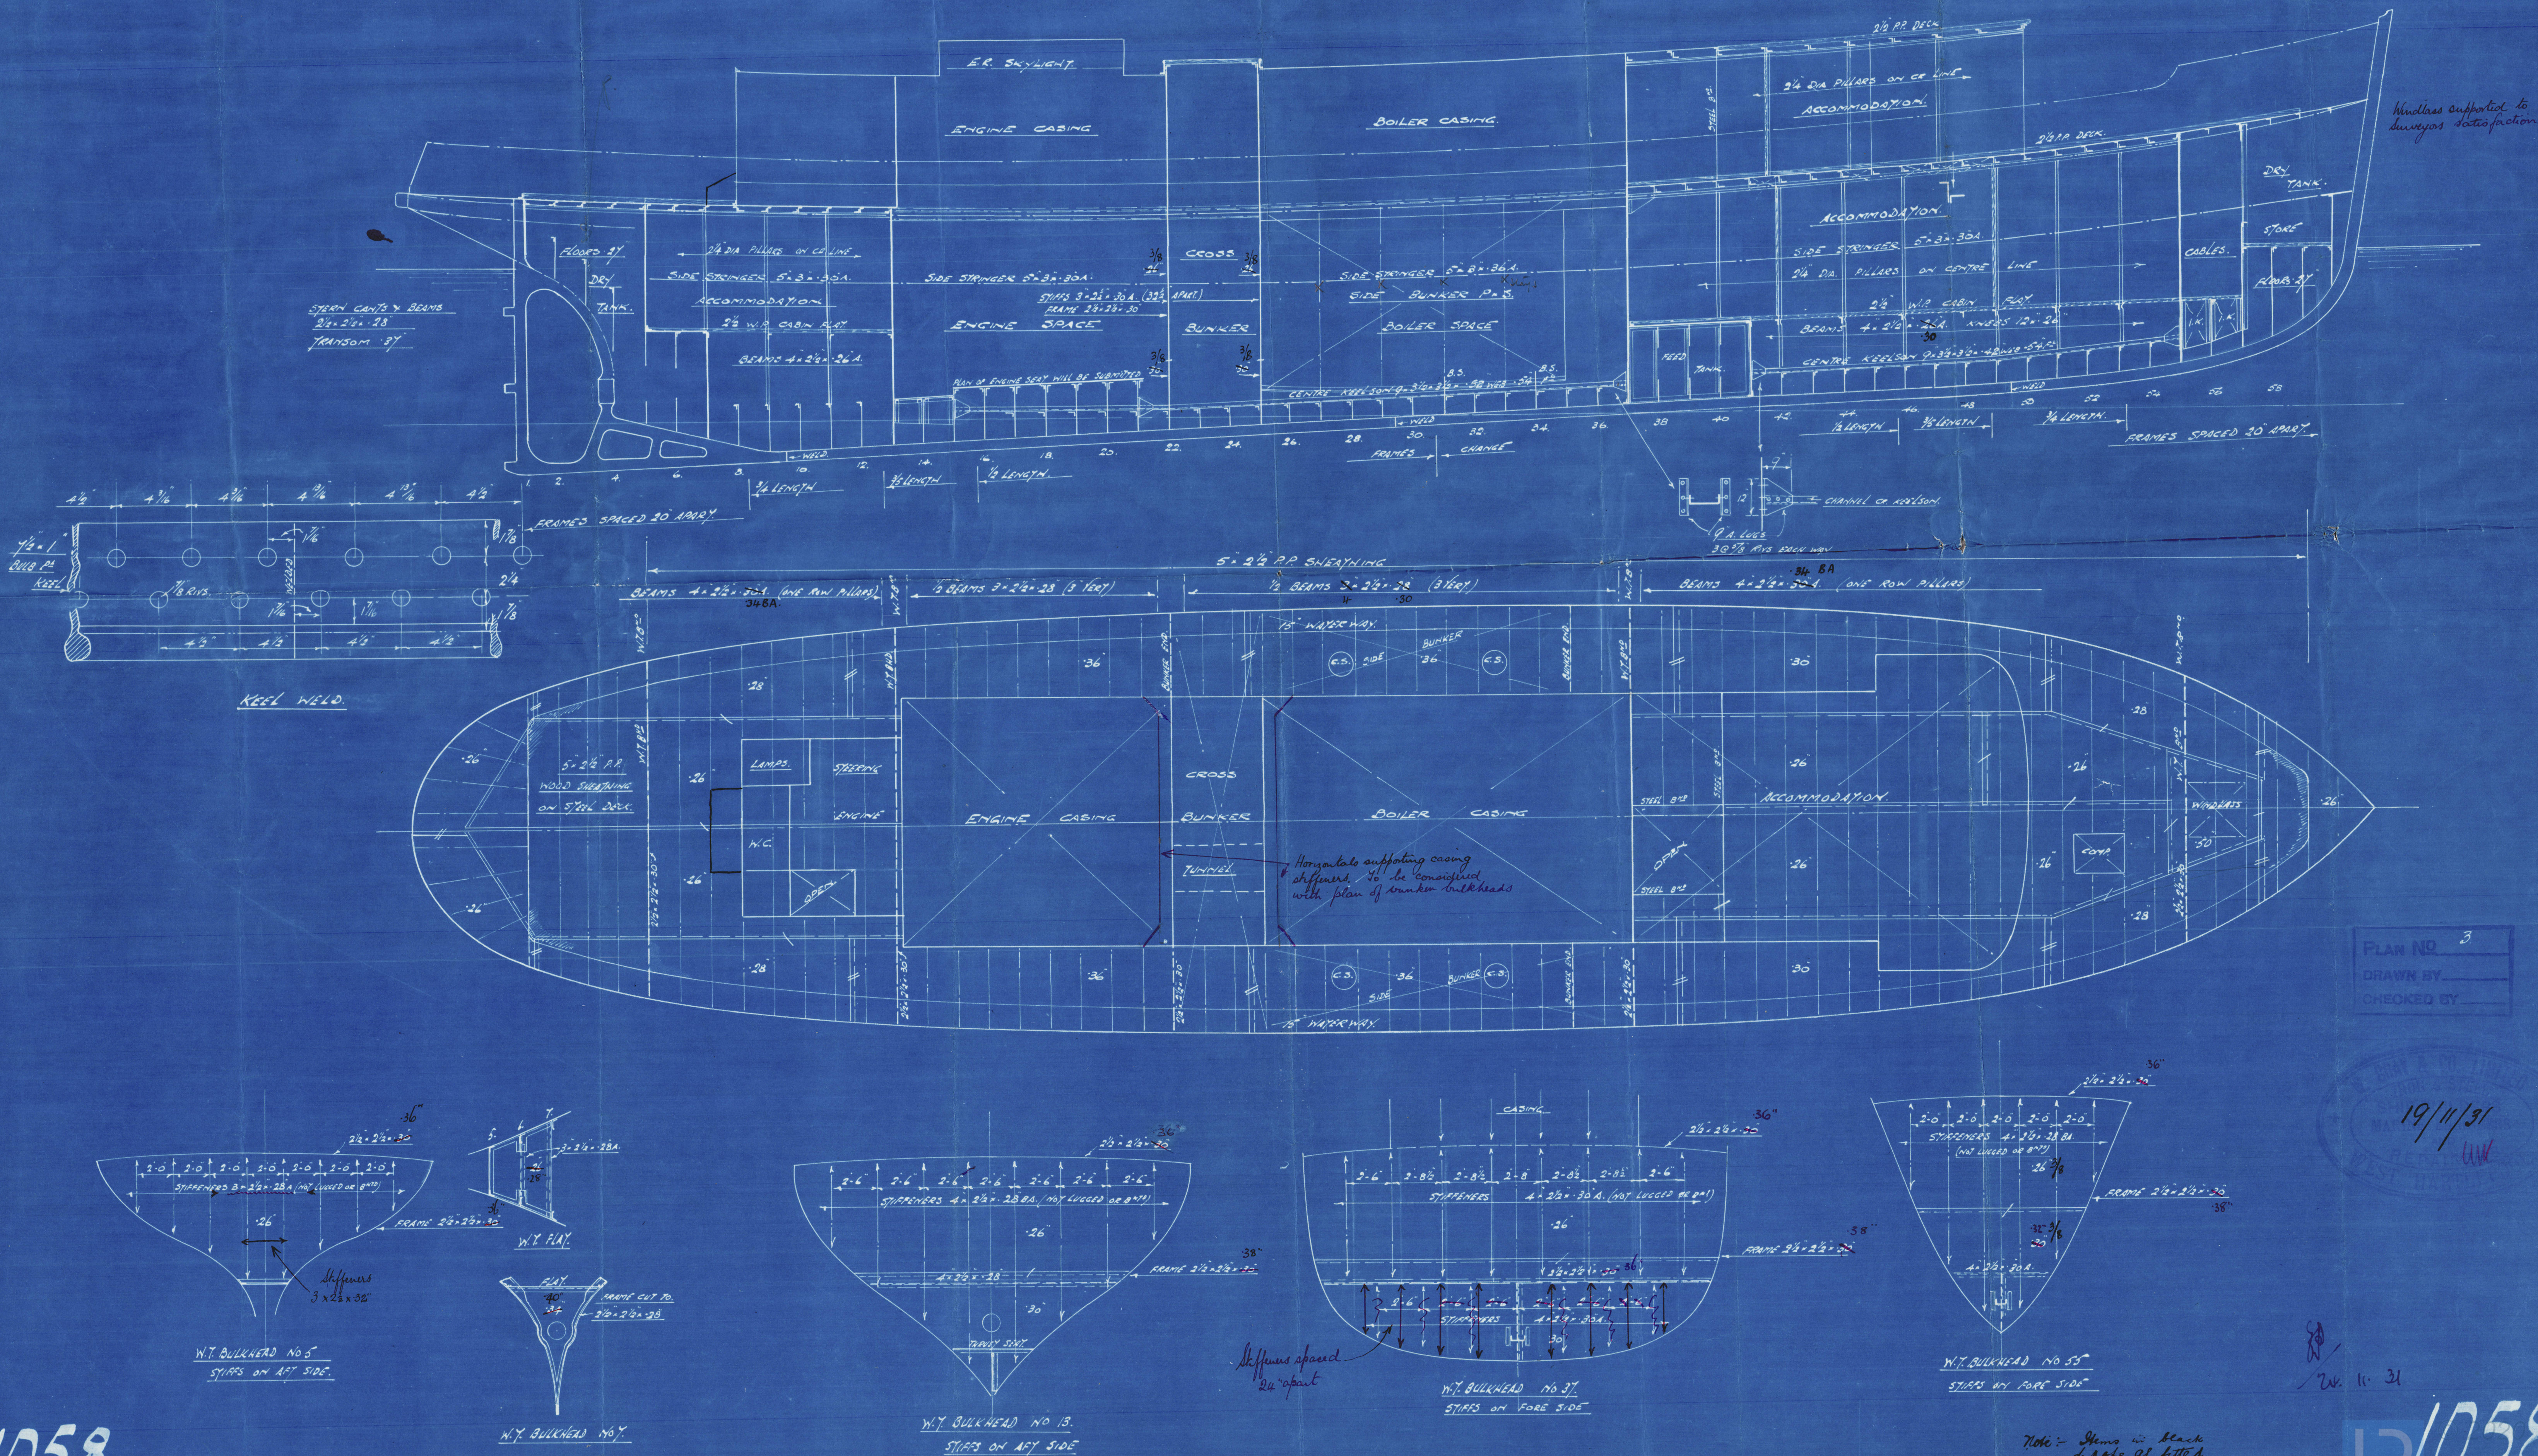

Kindness supplied to  
Surveyors satisfaction

PLAN NO 3  
DRAWN BY  
CHECKED BY

19/11/31  
W.W.

W.W. 11. 31

Note: Items in black  
dots as fitted

1058



Wm Gray & Co.

Profile + Decks

Bulkheads

I. W. Tank

- No 1058

B. O. DAVIES

(2)

West Hantlepool

Report No 1715

RETAIN

© 2020

002374-002384-0090

Shoys Register  
Foundation