


PART MAIN DECK PLATING

STEELWORK PLAN


VESSEL N° 578 Also V. 579 & 590 / 600/674

SCALE 1/4" = 1 FT.

ALTERATIONS IN RED ALSO V. 674

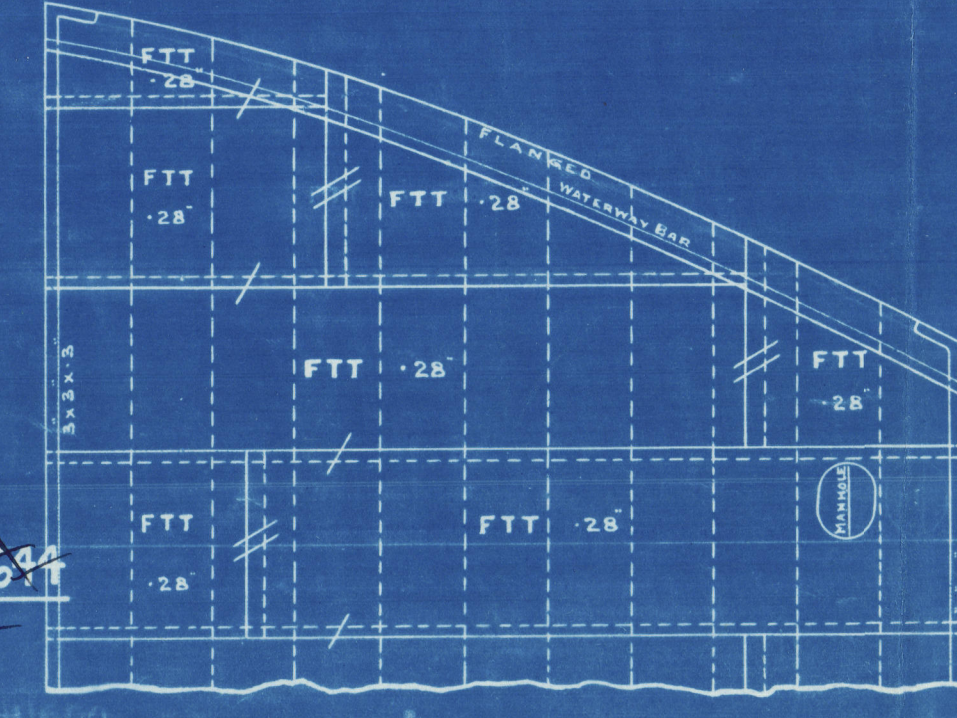

FORWD. TANK TOP

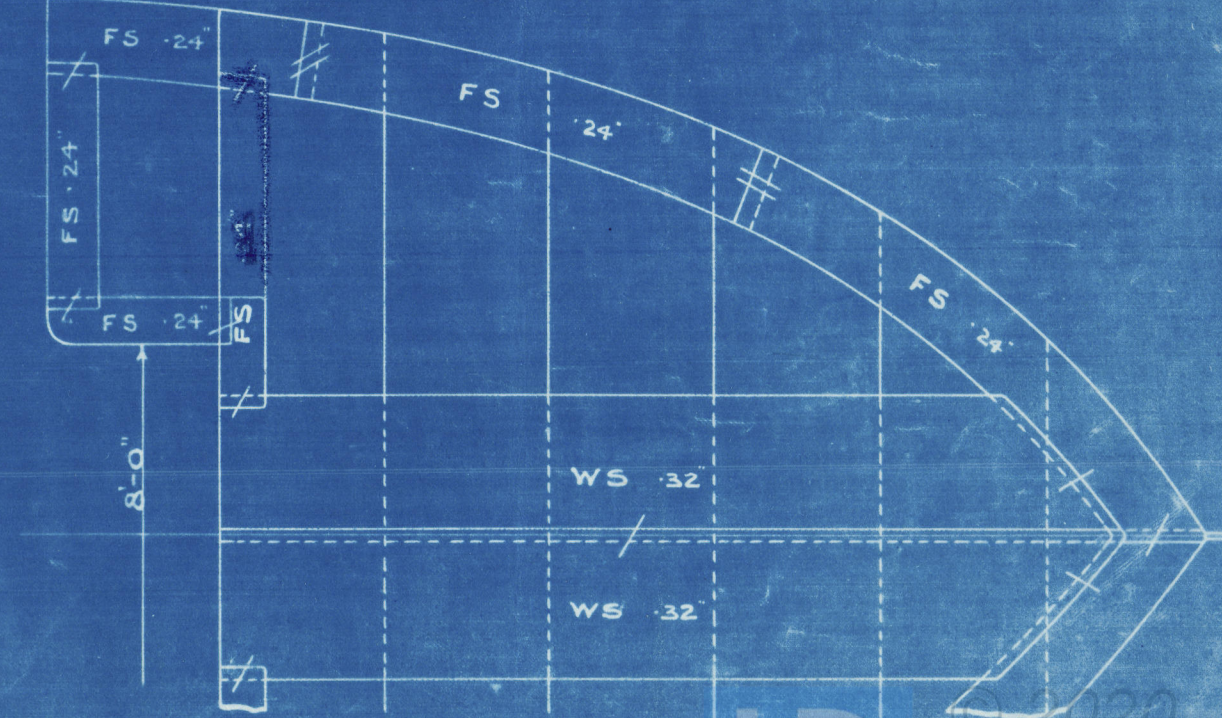

FOCSLE DECK PLATING

APPROVED BY LLOYD 18/11/19 APPROVED BY LLOYD 24/11/19



Latham J. B. & Eng. Co

N<sup>o</sup> 674

Shell plating Profile &  
deck plan

S/s Elmfield

S. S. *Elmfield*

LIVERPOOL

Report No. *89215*

RETAIN



© 2020

Lloyd's Register  
Foundation

002374-002384-0131