

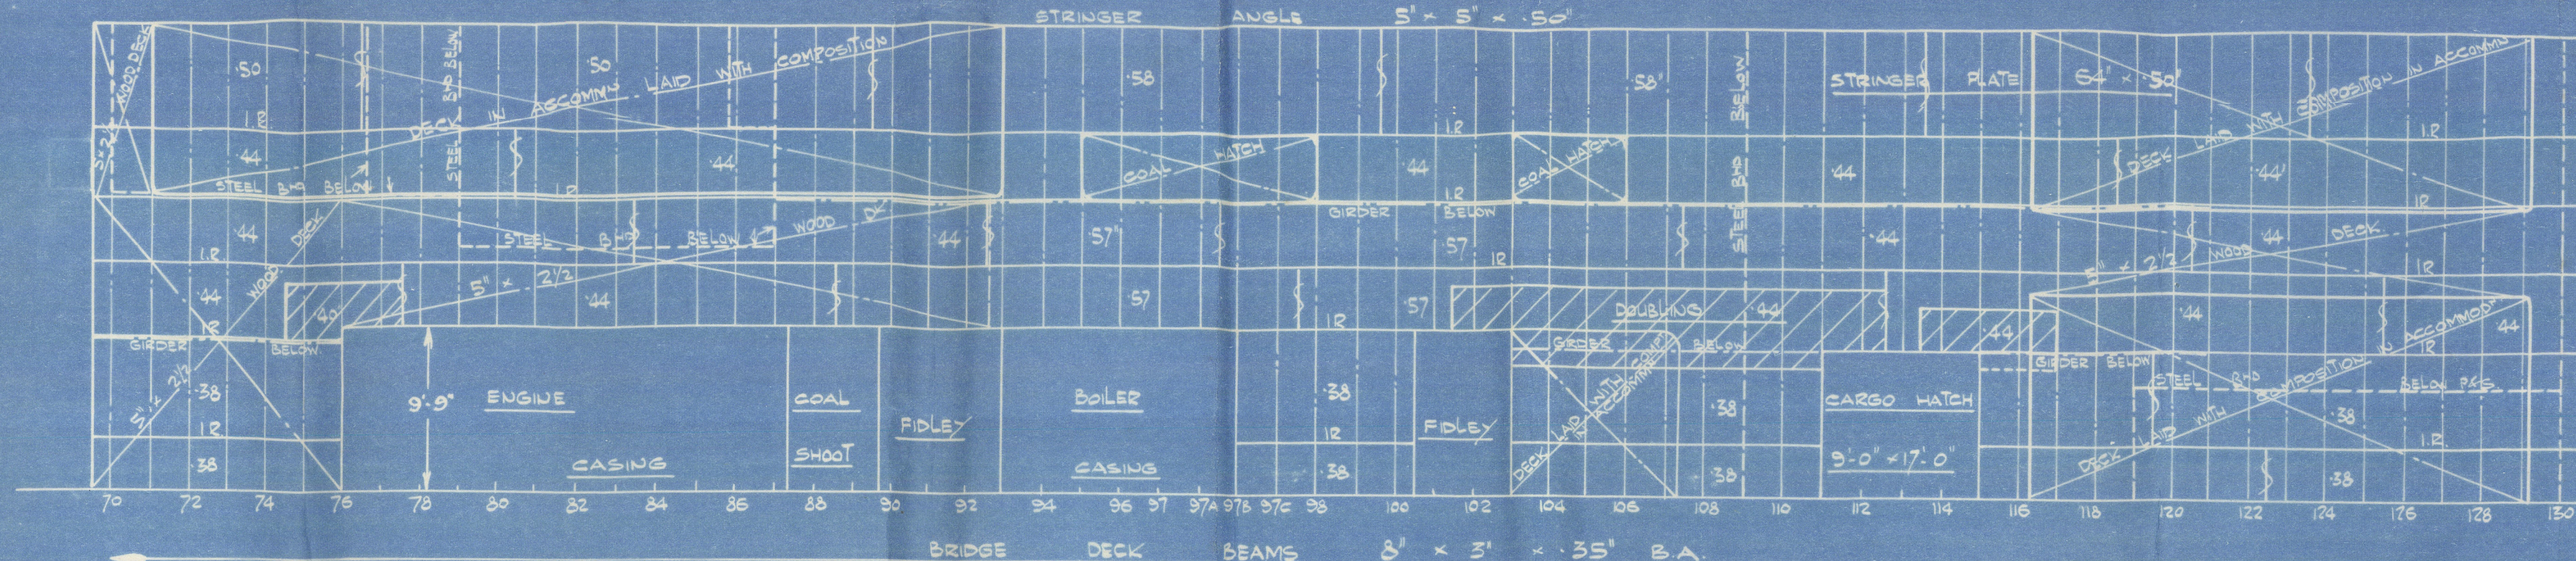
 


BRIDGE DECK

 

# PROFILE AND DECKS. S.S. ADVISER.

SCALE 1/8" = 1 FOOT.  
DIMENSIONS :- 44'-9" B.P. ON L.W.L. X 56'-6" B.T. X 56'-3" MLD. X 32'-2" MLD. TO UPPER DECK.  
TO CLASS 100 A.I. AT LLOYD'S SPECIAL SURVEY.

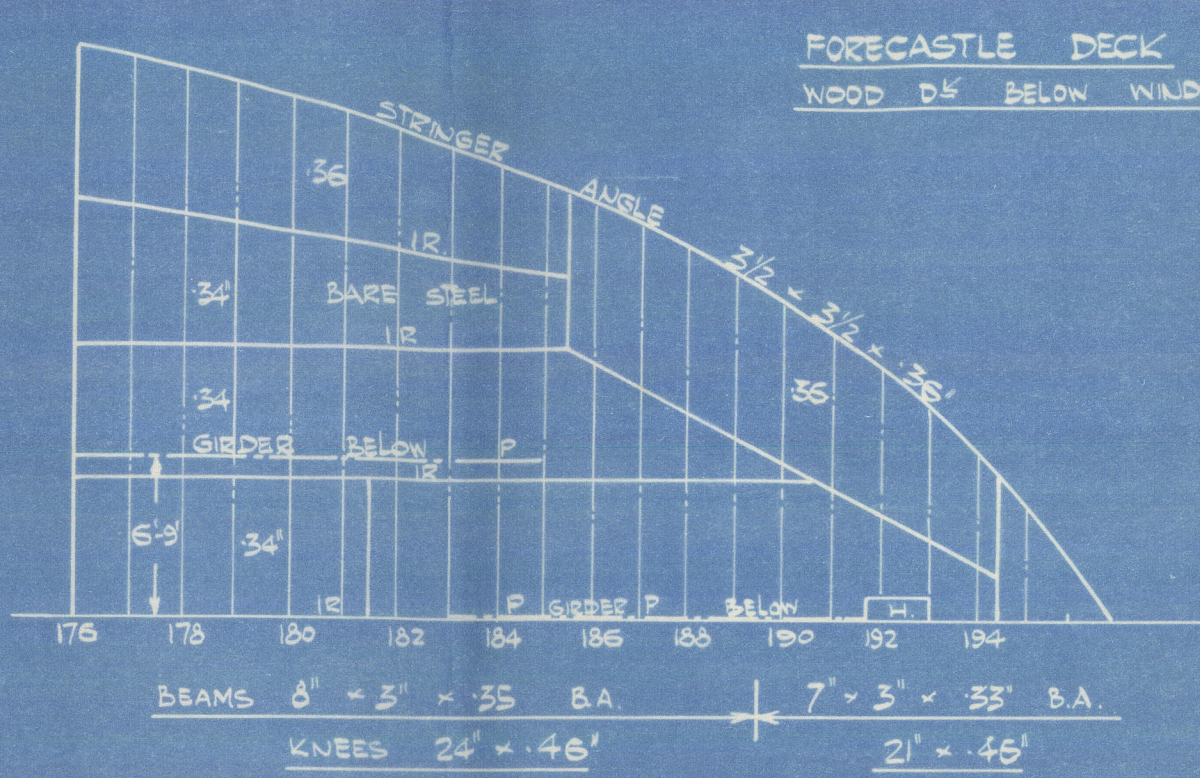



S. S. ADVISER

LITHGOWS LTD NO 917

PROFILE DECKS

AS BUILT

GREENOCK FIRST ENTRY

REPORT NO



© 2020

Lloyd's Register  
Foundation

002410-002411-0001