


PROFILE & DECK PLANS.

SCALE $\frac{1}{8}'' = 1$ FOOT.

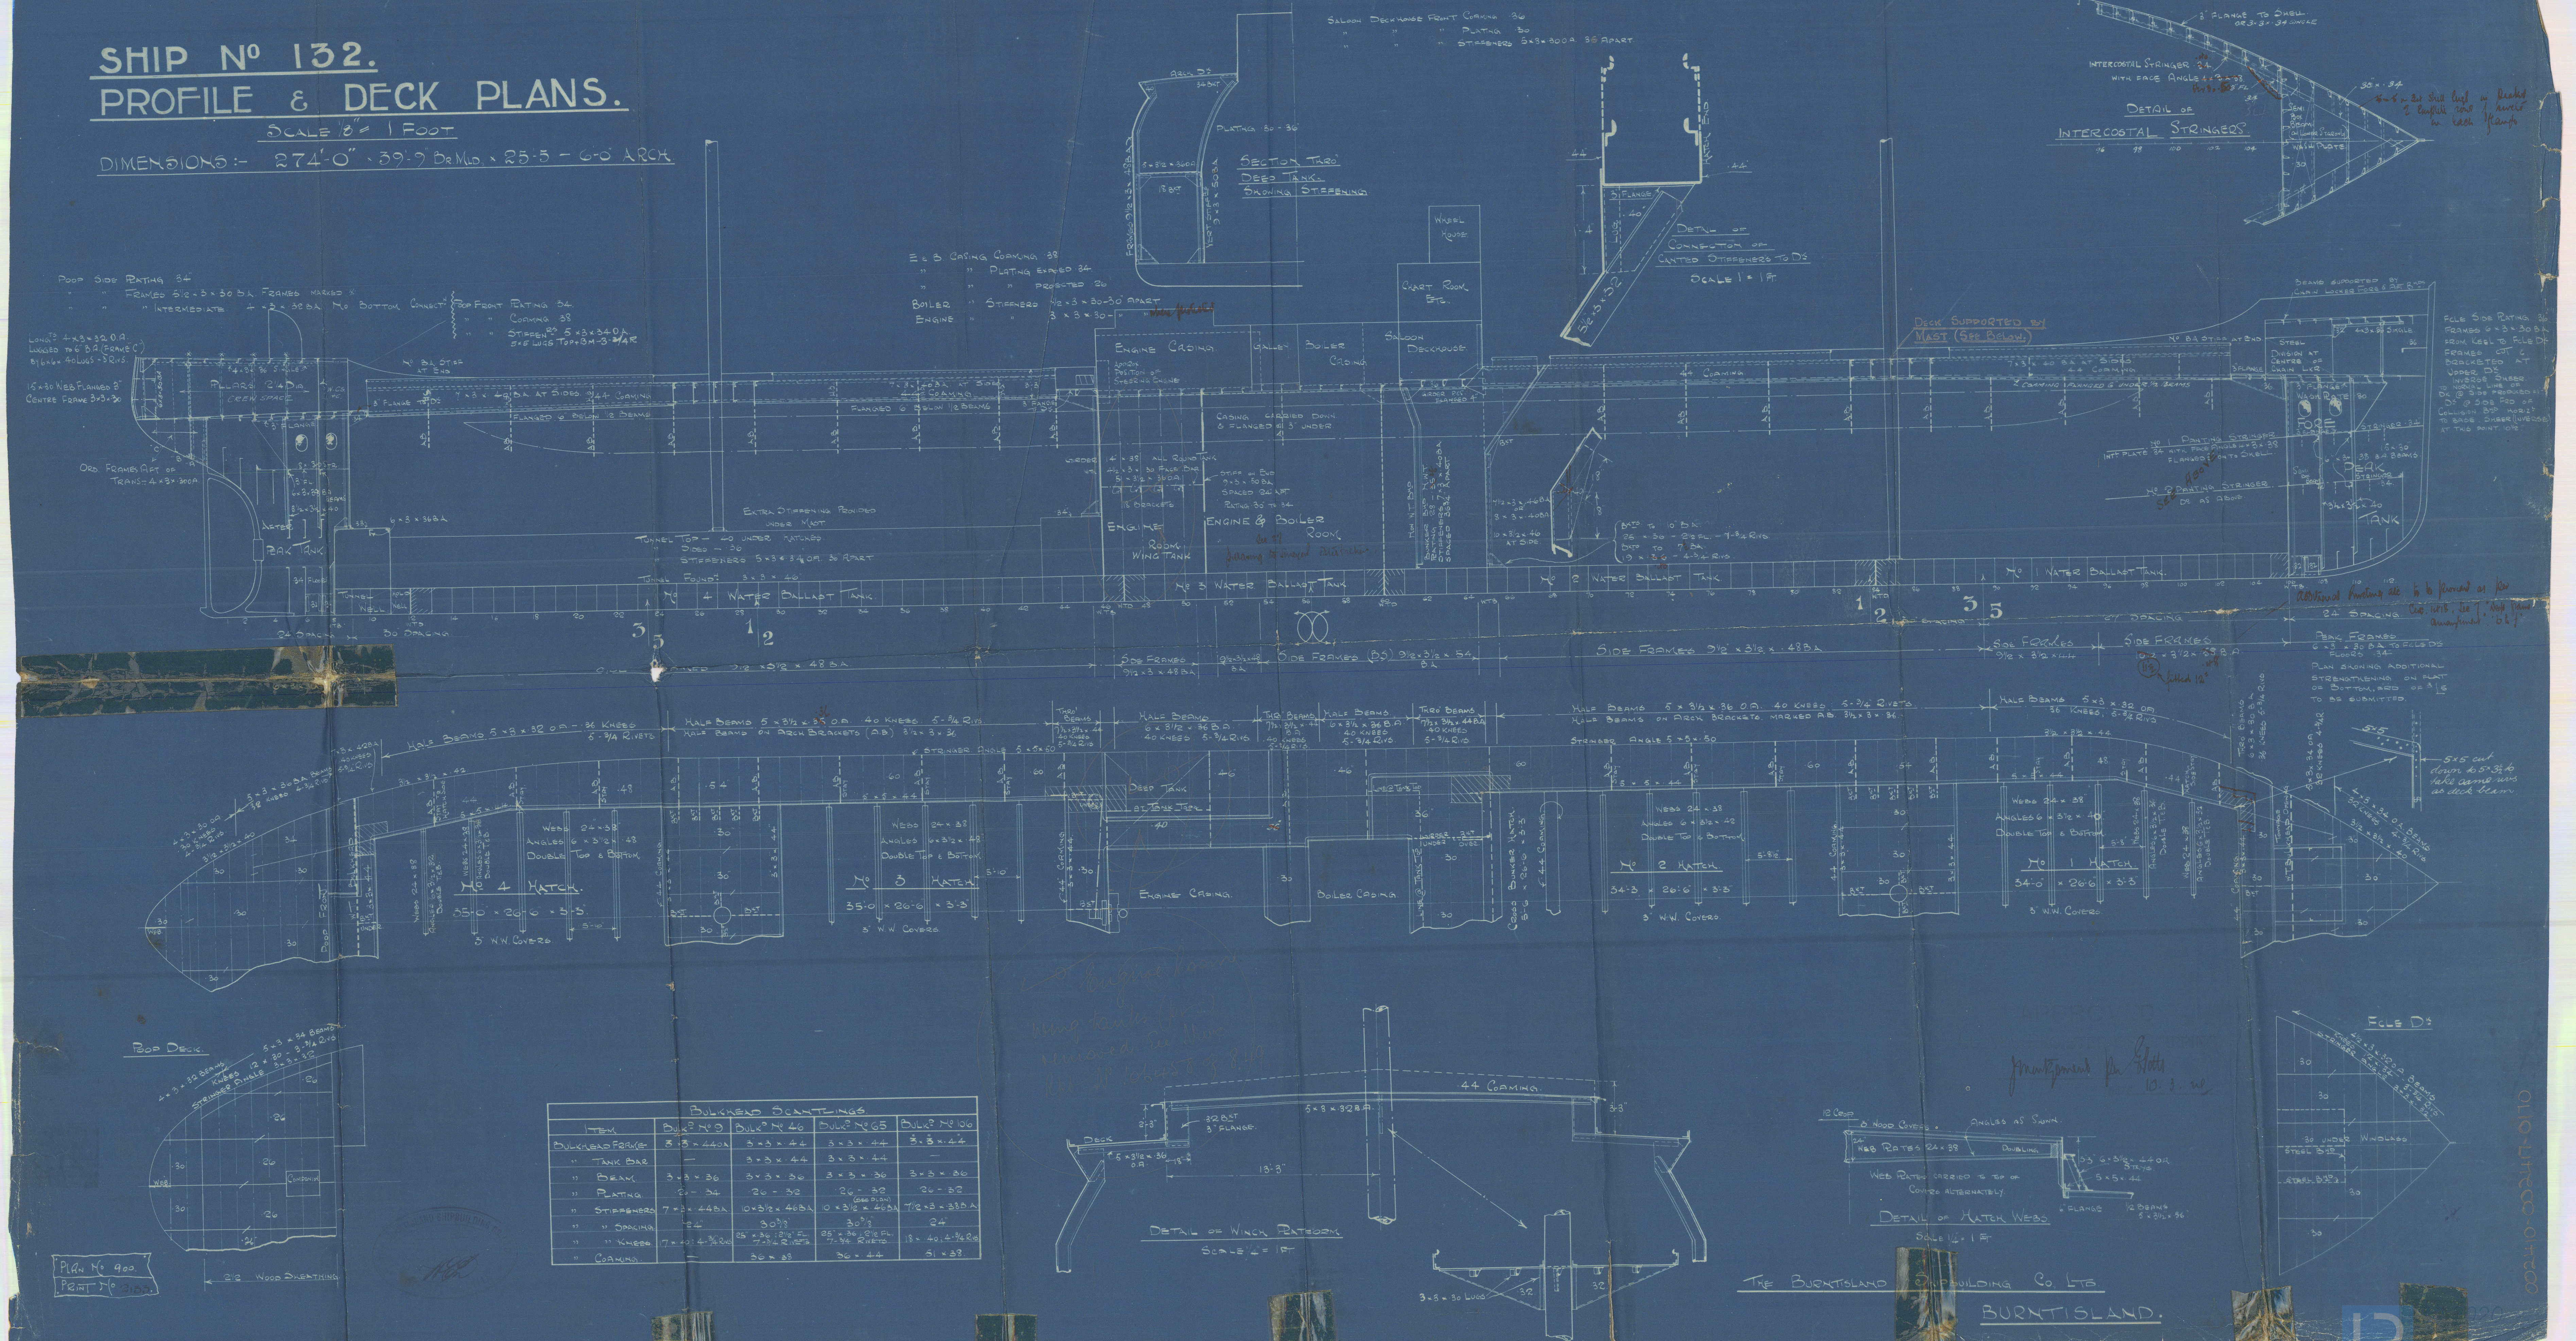


No. 132.

Profile & Hb.

Machrai

N N "AYTON"

© 2020

002410-002417-0170

