

13.10.25

SECTIONS

SHIP N° 1194

-SCALE ~ 3/4" TO 1 FT.-


DIMENSIONS

LENGTH O.A.	98'-0"
" B.P.	92'-6"
BREADTH MLD.	21'-3"
DEPTH "	8'-9"


TO BE CLASSED 100 A1. LLOYDS SPECIAL SURVEY
Carrying Petroleum in bulk middle two bulkheads in all light
 $L \times D \quad 92.5 \times 8.75 = 809$
 $L \times (B+D) \quad 92.5 \times (21.25 + 8.75) = 2,775$
 $D/L \quad \frac{92.5}{8.75} = 10.57$

EQUIPMENT *if equipment number not exceeding 3000*


ONE STOCKLESS ANCHOR	4 1/2 CWTs.
" " "	4 1/4 " "
" STREAM "	3/4 " (EX STOCK)
120 FATHOMS OF 1/16" STUD LINK CABLE.	
45 " " 9/16" SHORT " STREAM CABLE.	
75 " " 5/2" HEMP.	
90 " " 3" "	

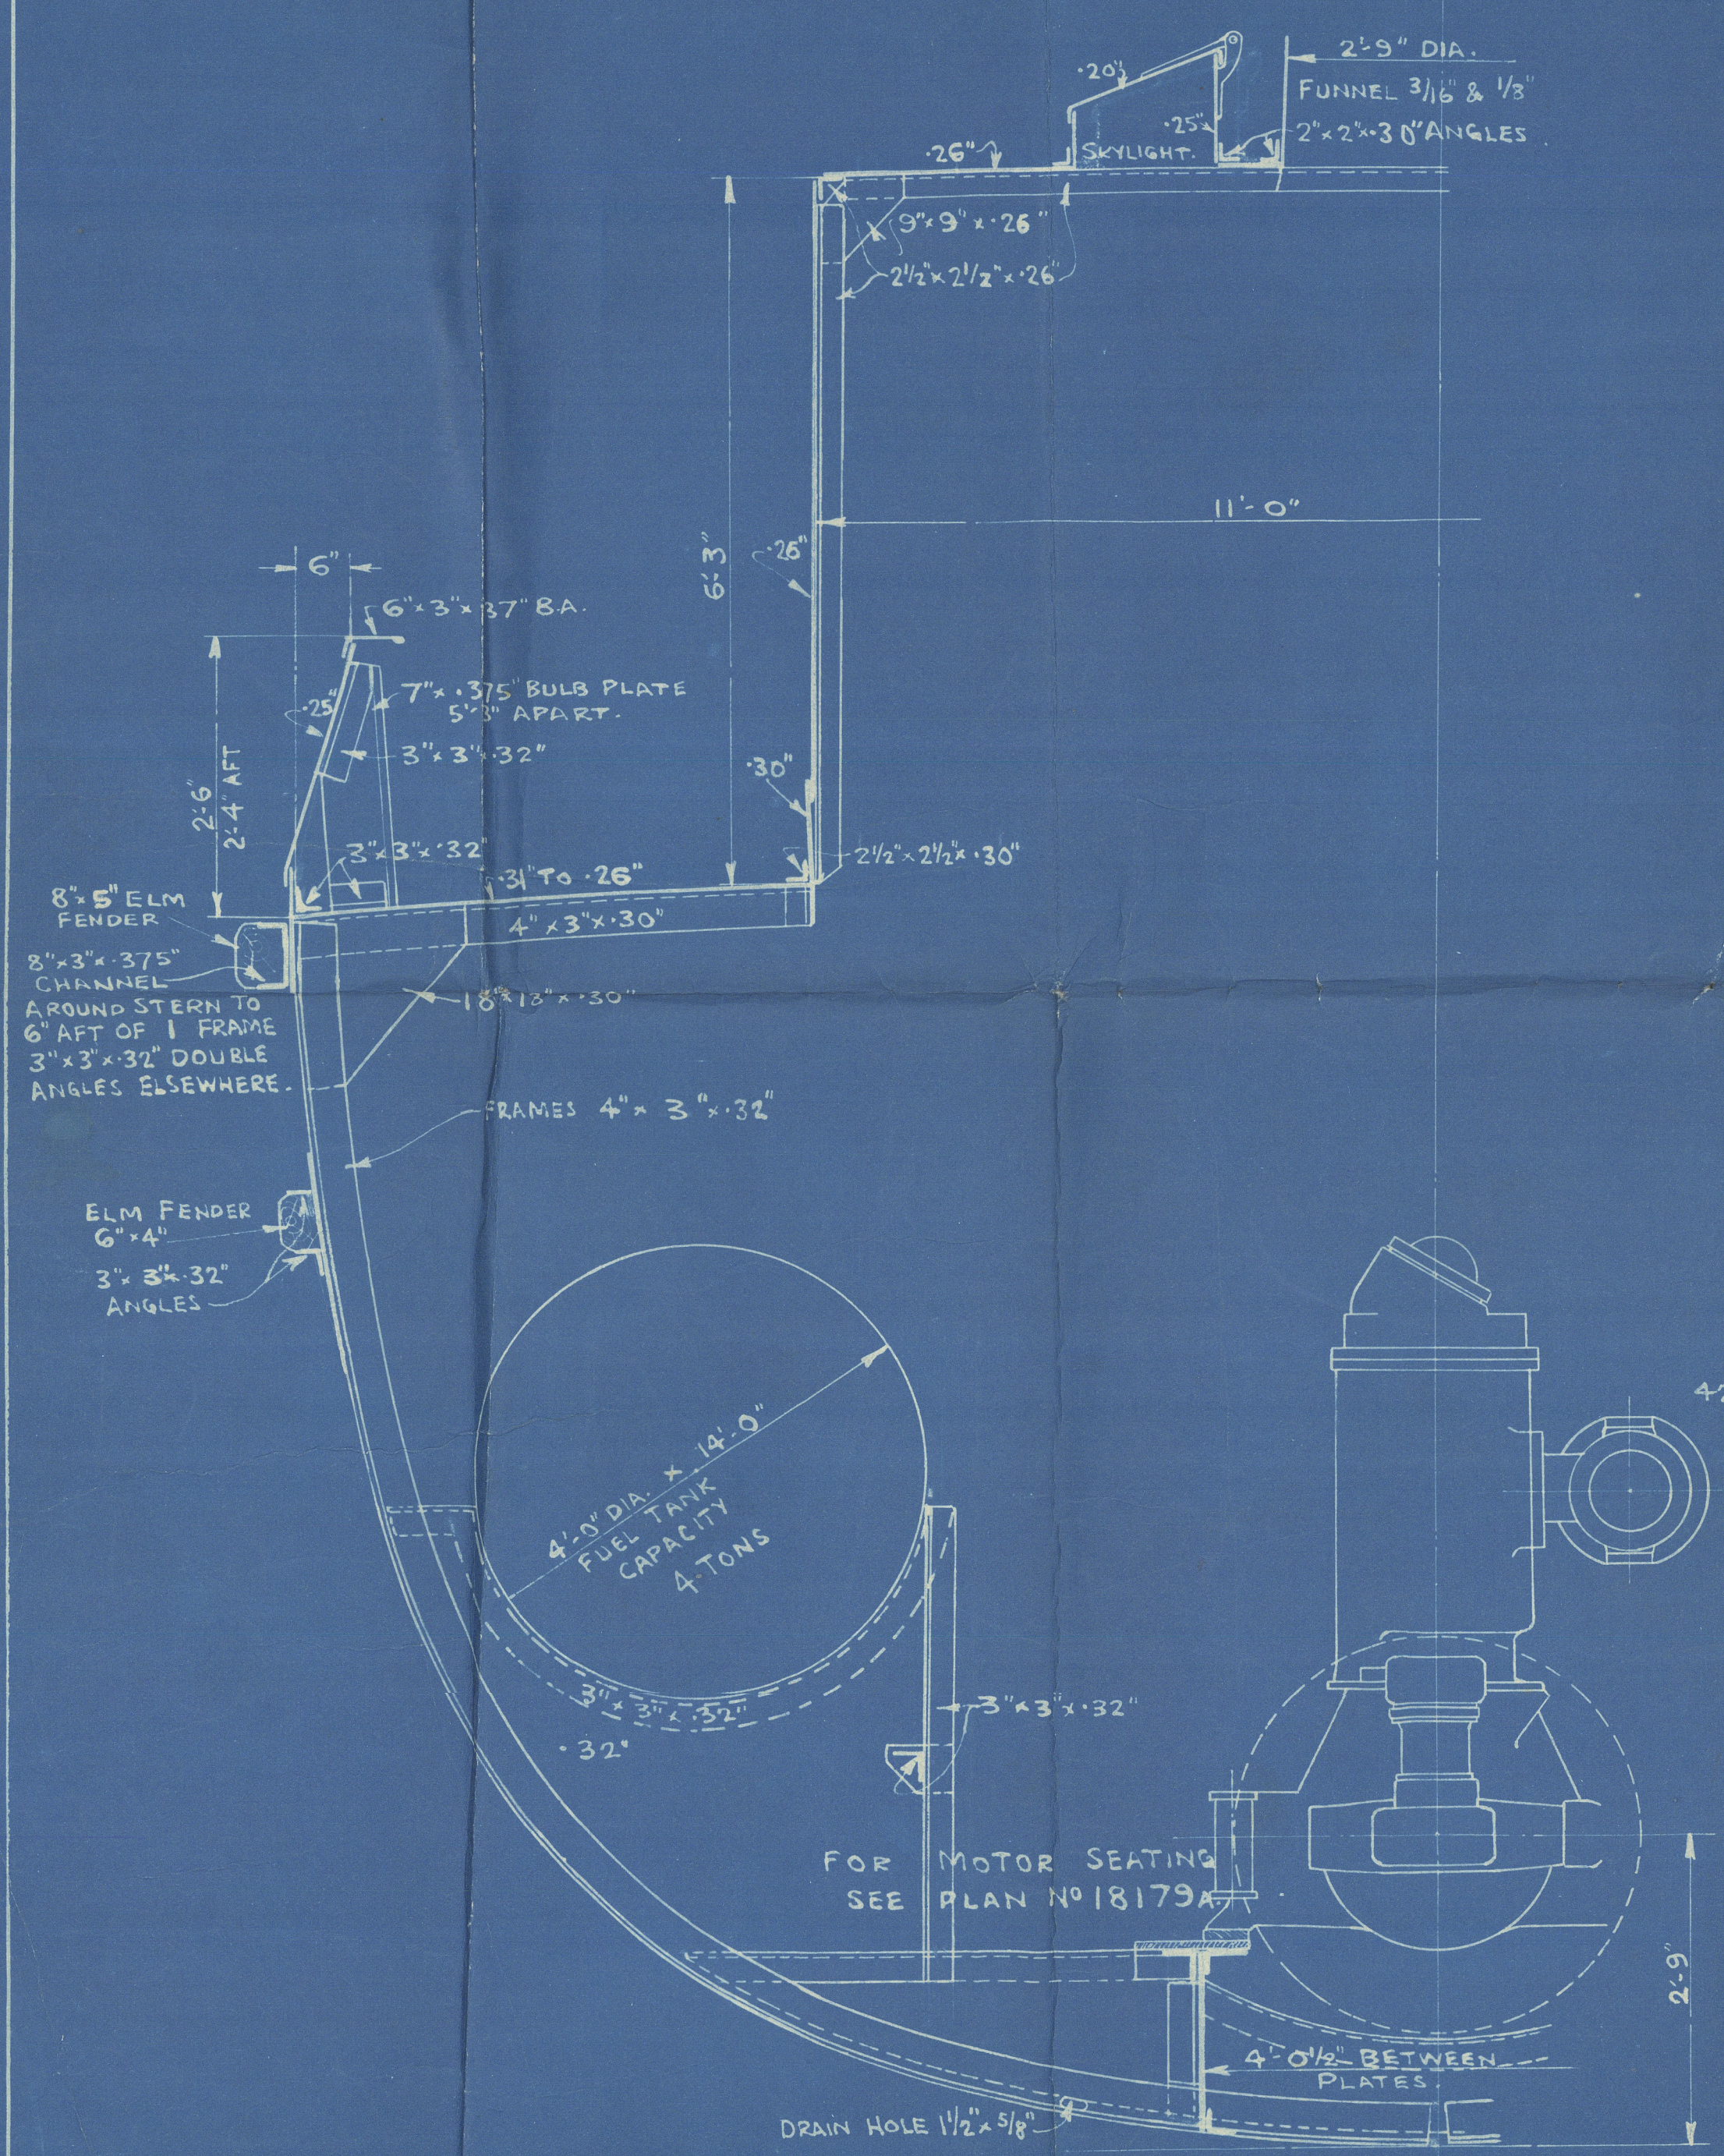

SECTION AT FRAME N° 10
LOOKING AFT

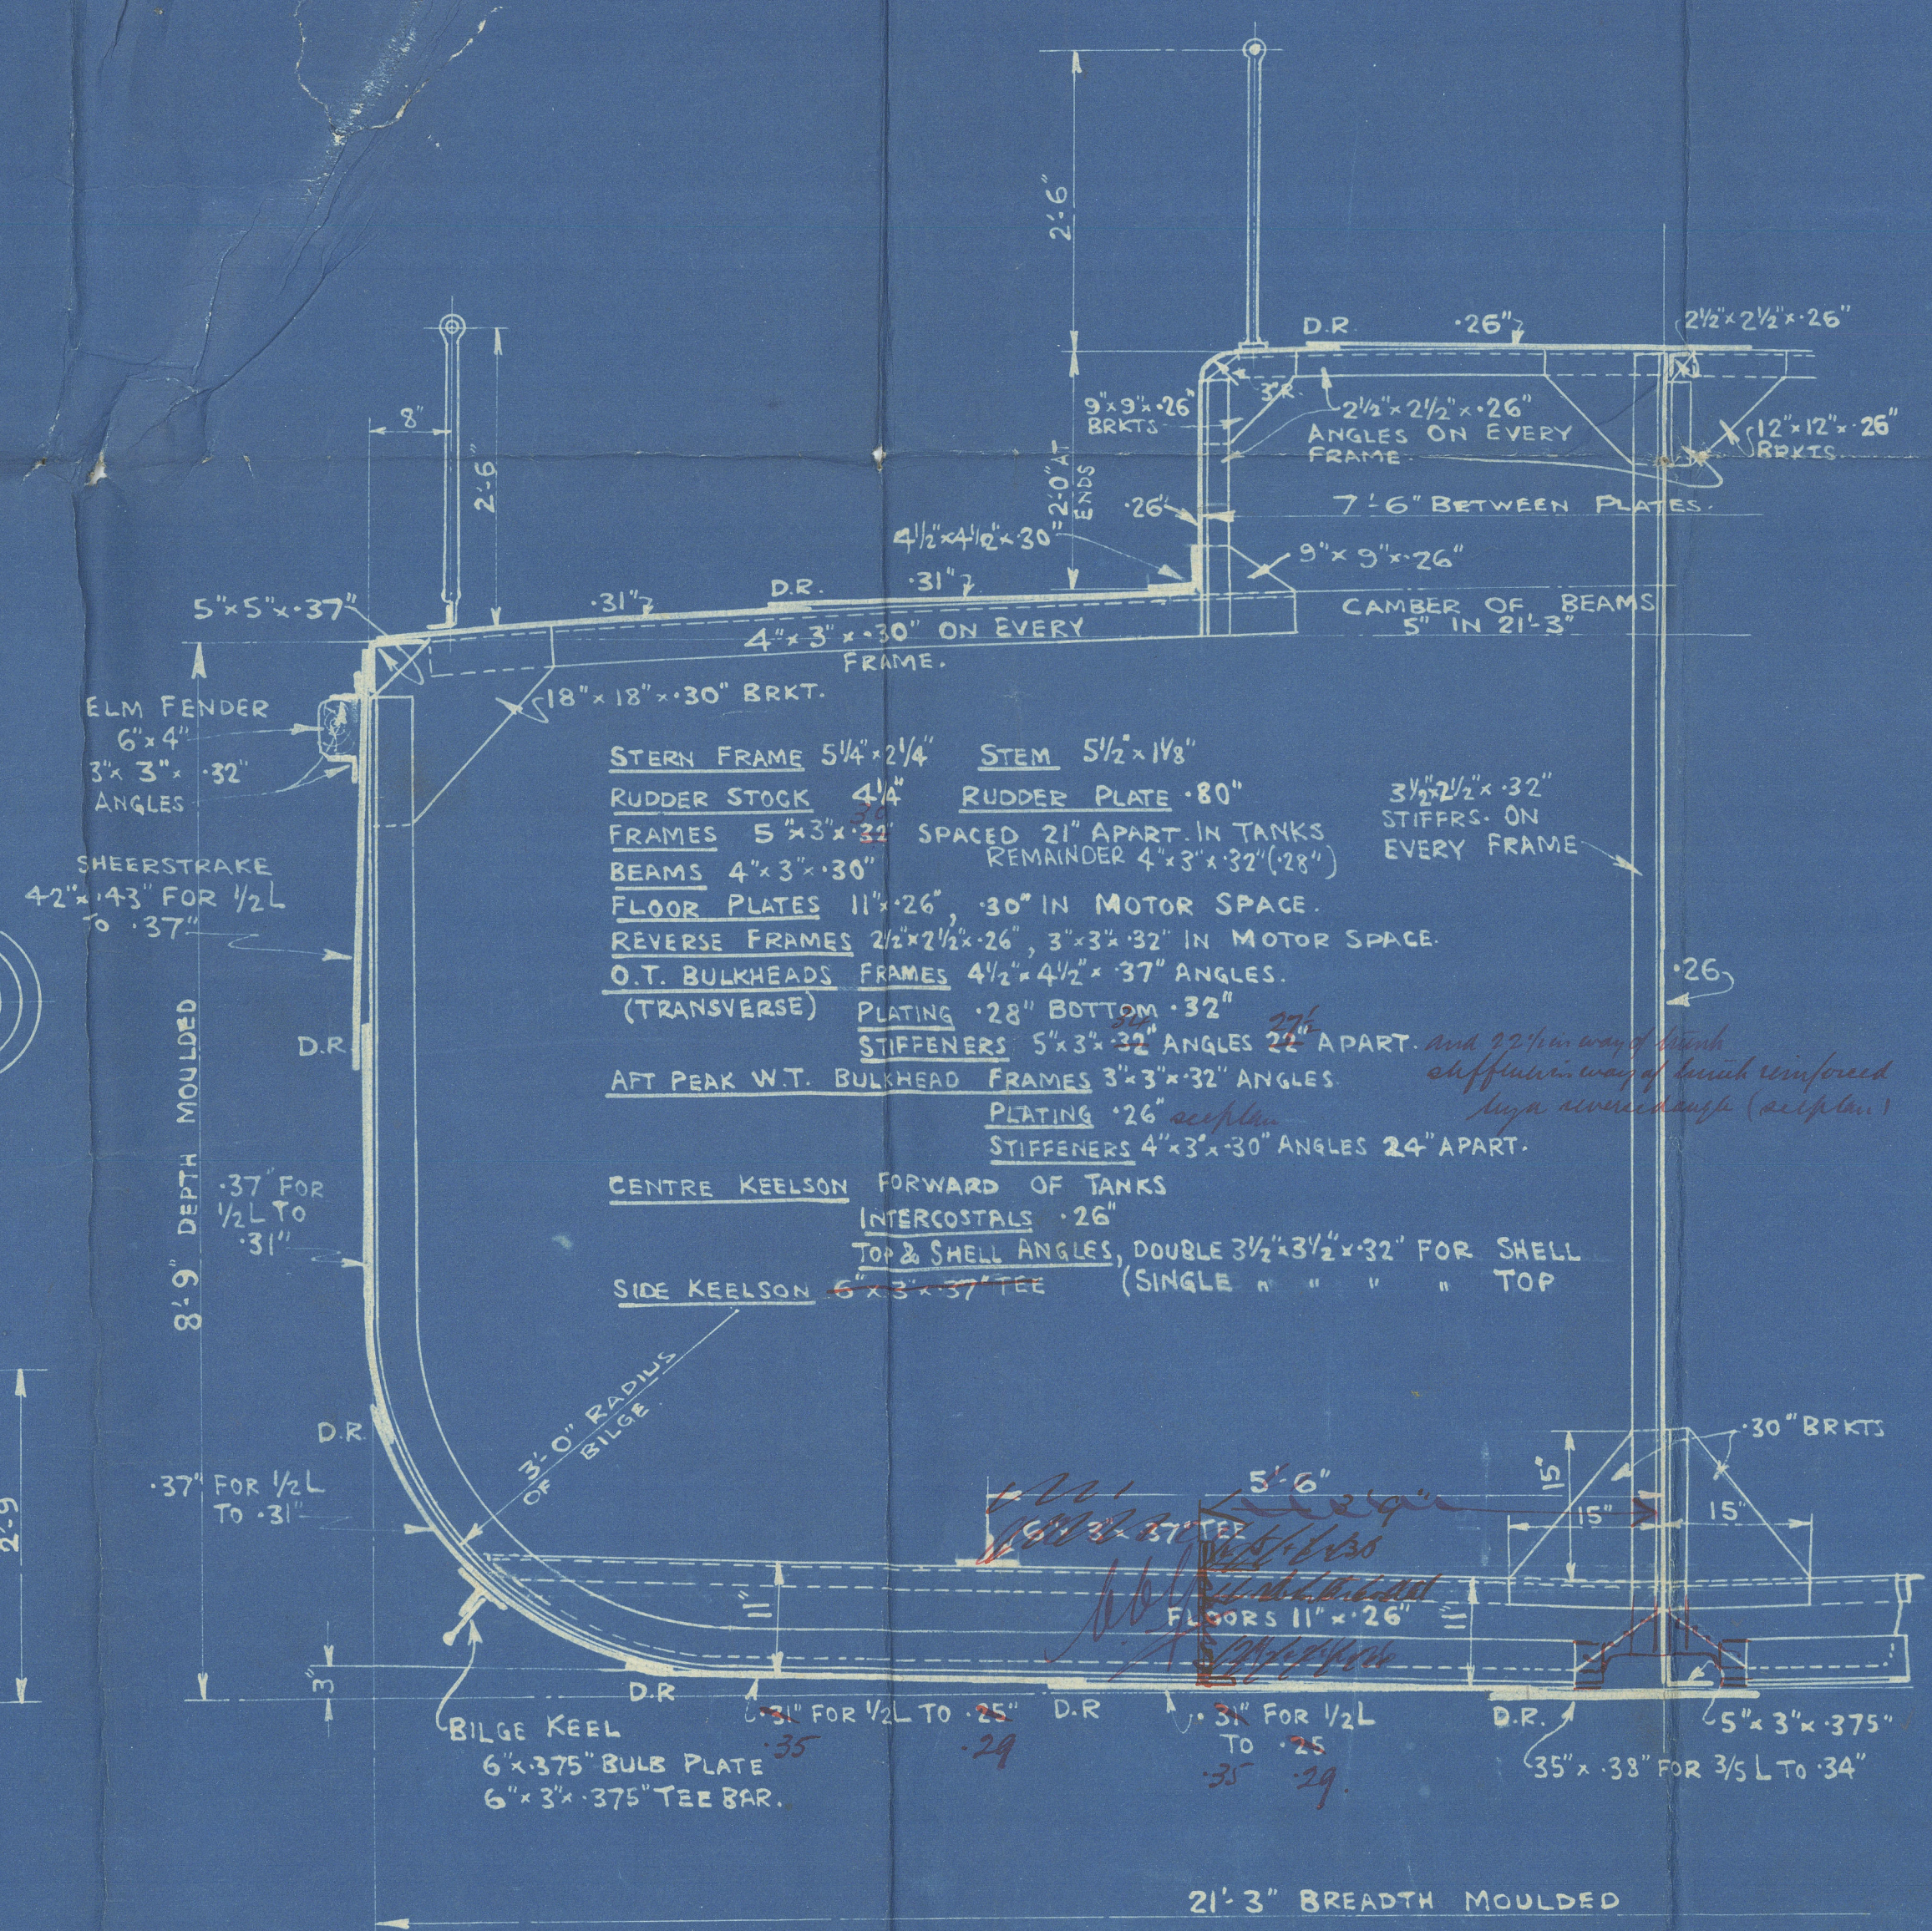

MIDSHIP SECTION
LOOKING FORWARD

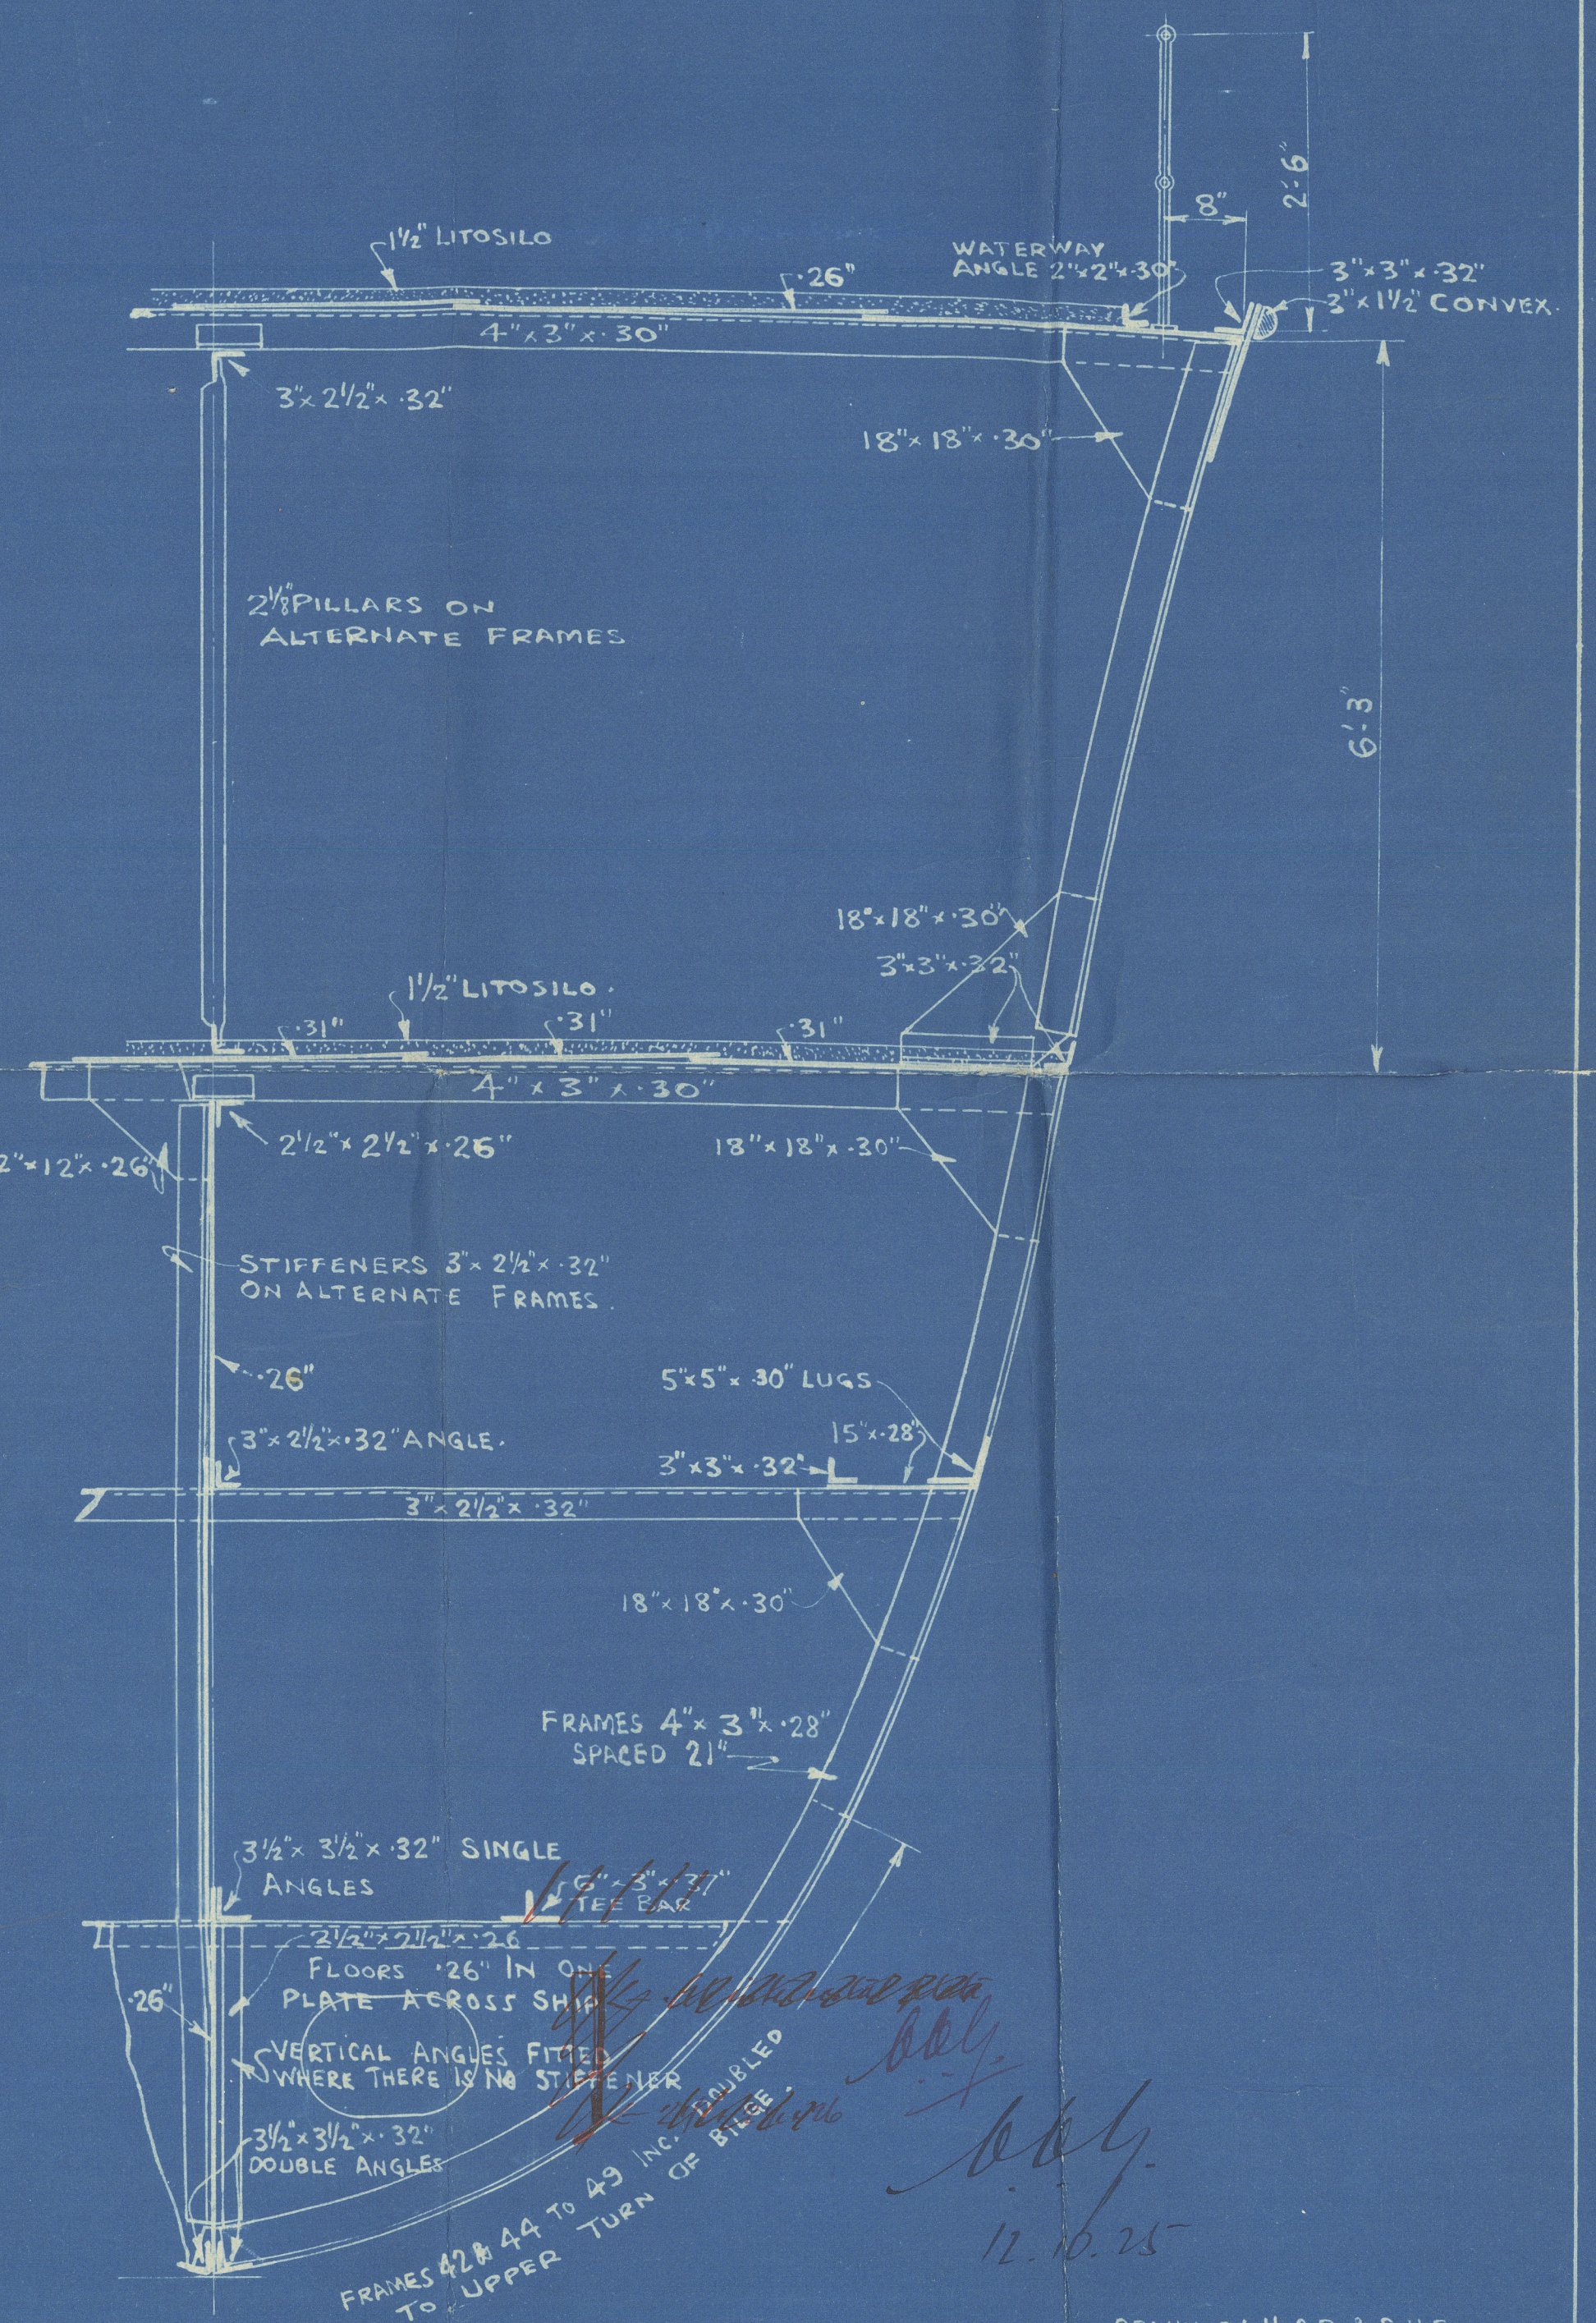

SECTION AT FRAME N° 47
LOOKING FORWARD

DRAWN BY H.C.B. & S.H.E.
 TRACED BY S.H.E.
 CHECKED BY P.C.
 DATE 7.10.25

PLAN N° 18169A
 JAMES POLLOCK, SONS & CO. LTD.
 SHIPBUILDERS & ENGINEERS,
 3, LLOYDS AVENUE,
 LONDON, E.C. 3.

Am M



© 2020

Lloyd's Register
Foundation

M. V. LIDO " NN. ANN M

James Pollock. Smo +60 La.

Yava No 1194.

Mudship Section.

London Report No. 90,244

ANN. M.



© 2020

Lloyd's Register
Foundation

002427-002434-0106