

18/8/20

Davito supported
to Davito's satisfaction

See plate

The Matter

1
BEAMS EXPOSED IN PLATES
3-10 APART
1-10 INCHES
4 3/4 RIVS.
15
V
22 CONUS
Information from
broken wire
C.C.
11

Cabin wall supported
to surveyor's satisfaction
equivalent to bill an

Boat deck front buckhead
to canopy's satisfaction
also sat 25 p.m.

664.
10-8-20.


Nº 1120 BOAT DECK $1/4" = 1'-0"$

ENCLOSURE
N° 402
JUSTO

N° 25607

SHIPPING DEPARTMENT
12-8-20
NEPTUNE WORKS
WALKER

Chavez

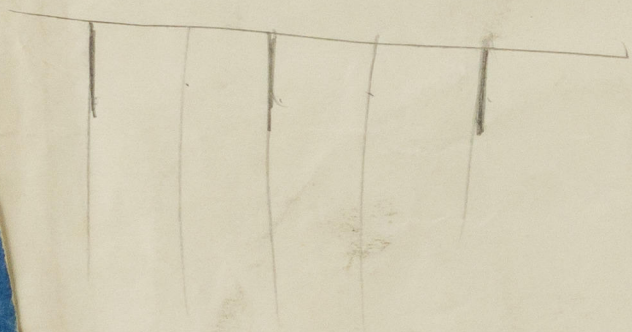


© 2020

Lloyd's Register
Foundation

SWR 1120

002435-002441-0002

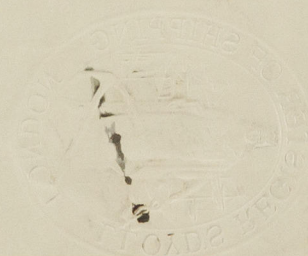


© 2020

Lloyd's Register

N^o 1120

Boat Deck

Messrs Swan Hunter &
Wigham Richardson & Co

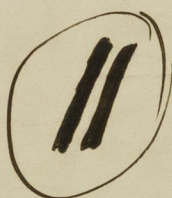

S/S ALL AMERICA
NEWCASTLE ON TYNE.

Report No. 44869



© 2020

Lloyd's Register
Foundation

002435-002441-0002