


20 JUN 1946

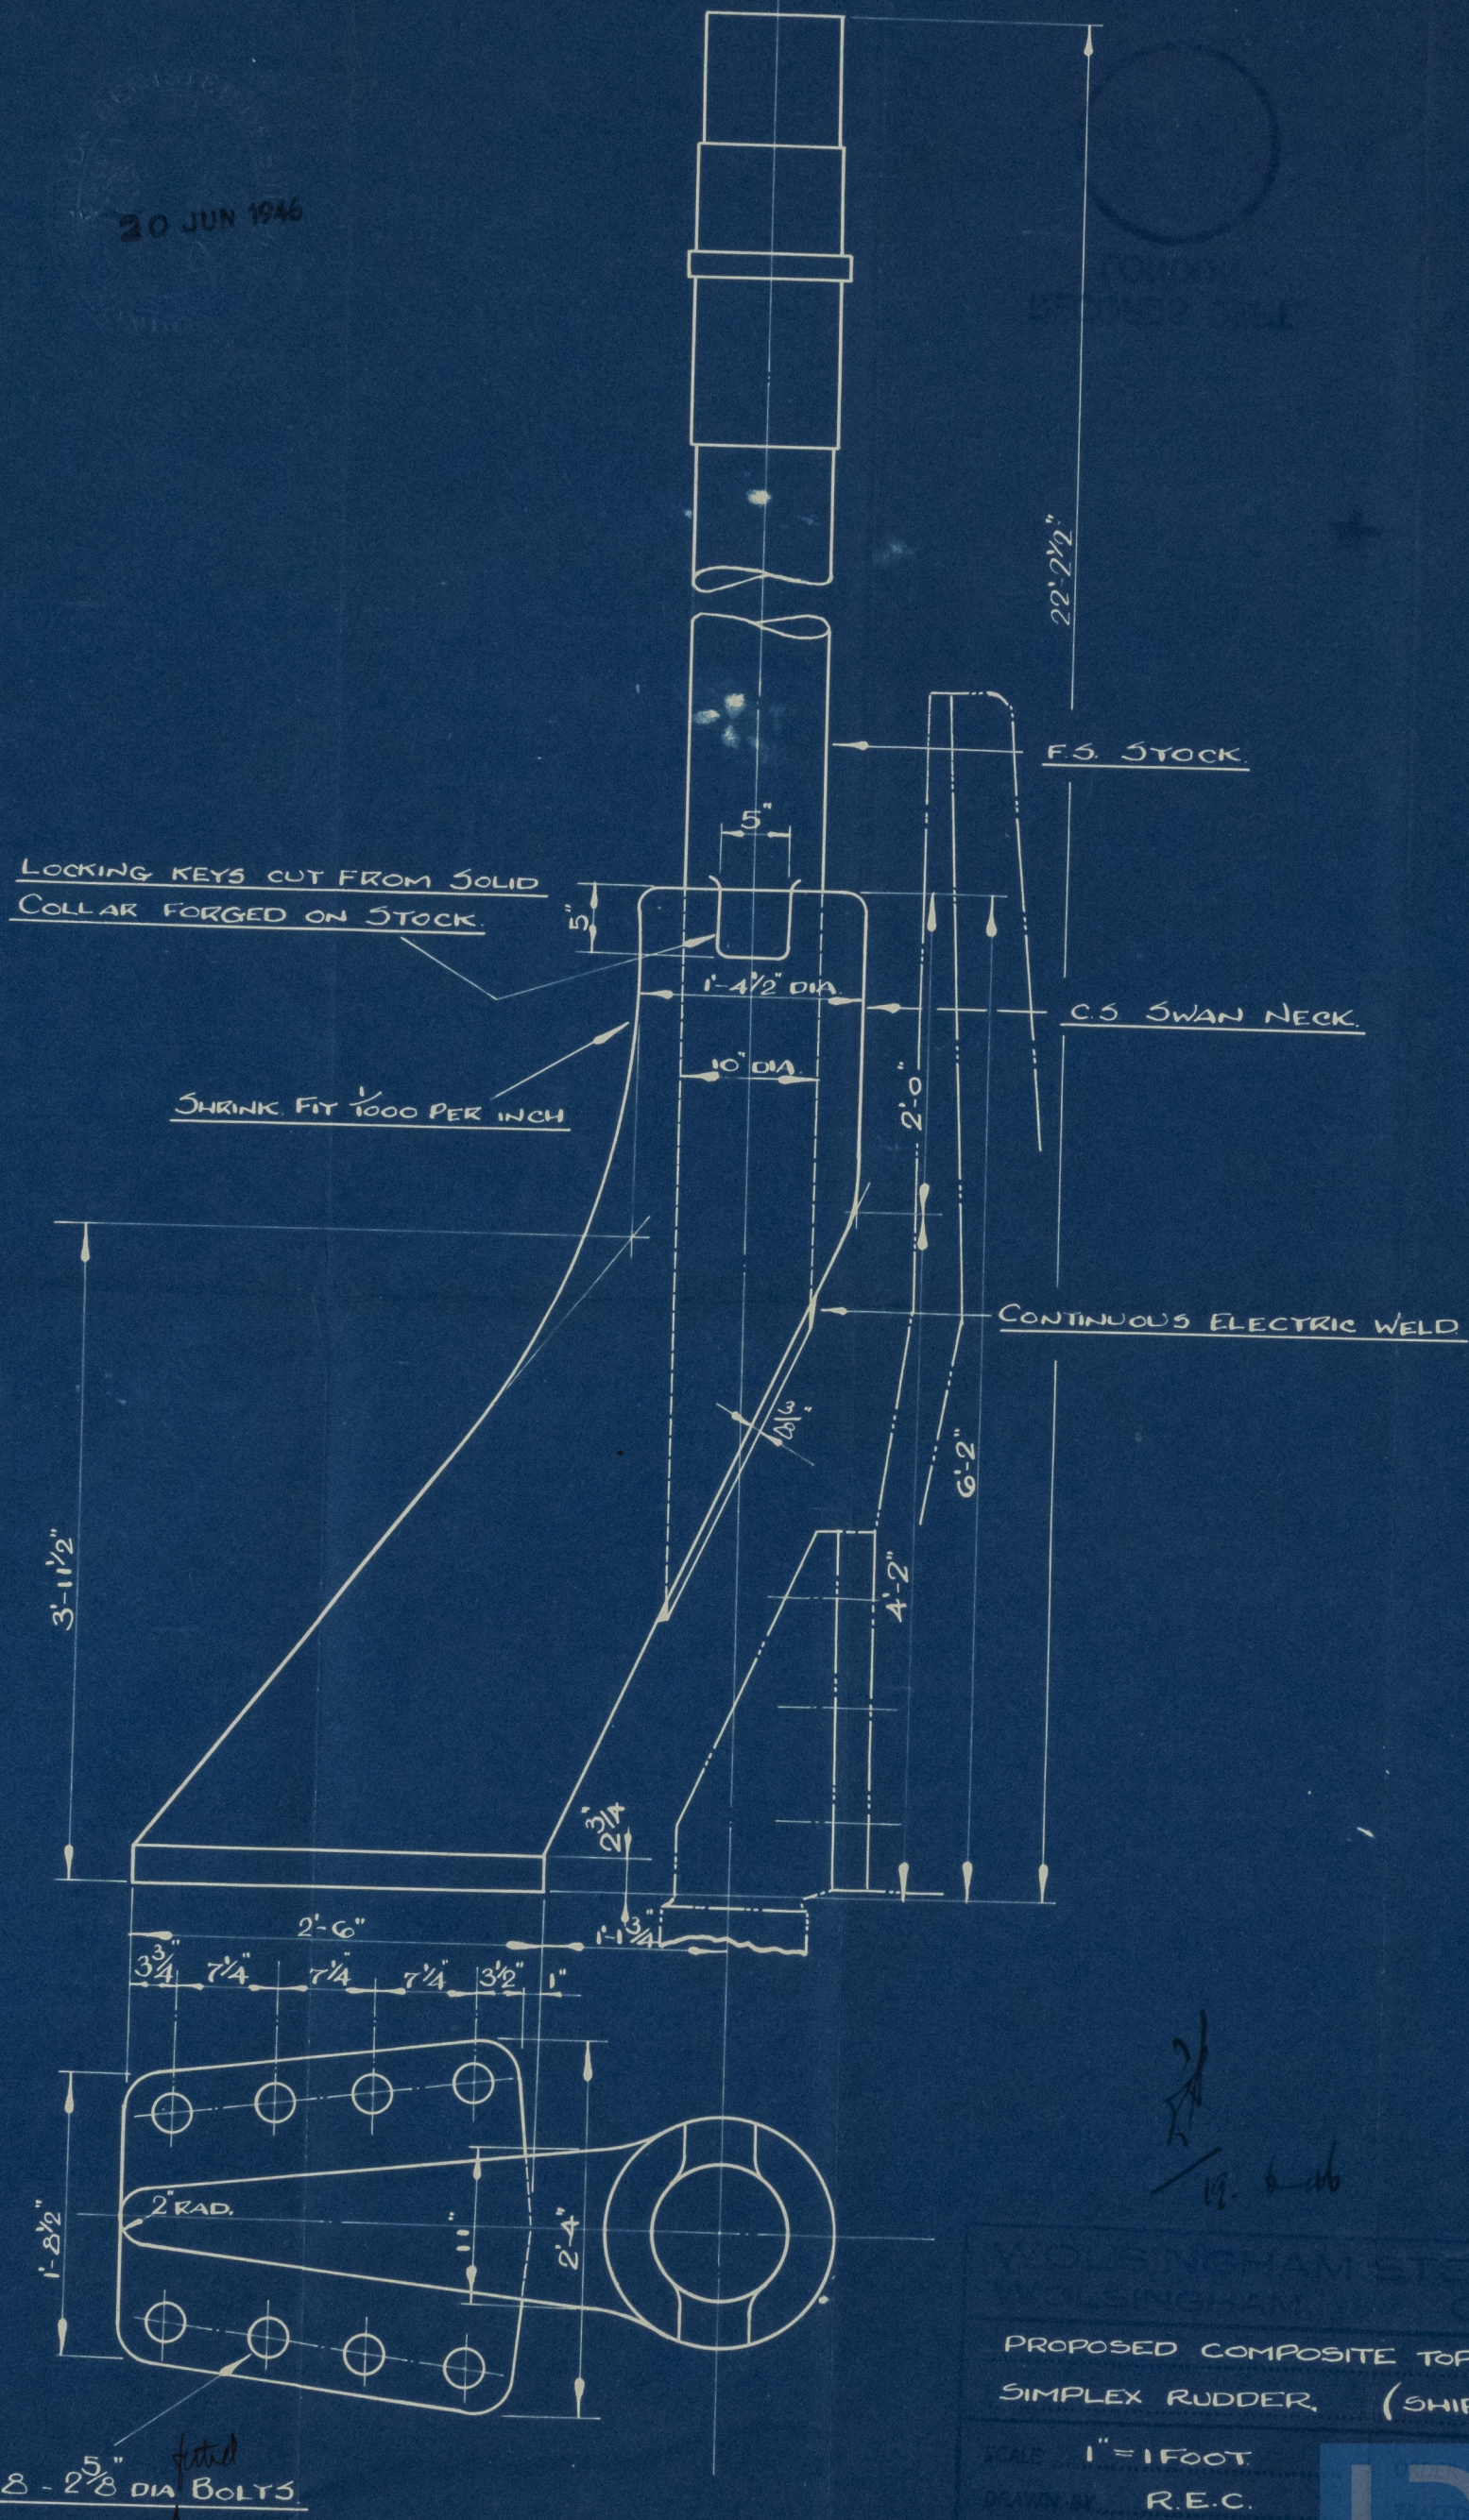

WOLSENGHAM STEEL CO. LTD.
WOLSENGHAM CO. DURHAM

PROPOSED COMPOSITE TOP POST FOR
SIMPLEX RUDDER. (SHIP NO. 656)

SCALE 1" = 1 FOOT

DRAWN BY R.E.C.

CHECKED BY

DRAWING NO. 3239.



R.E.S.

24:5:46

002442-002448-0101

TO

DRAWING No.

.....

FROM


WOLSINGHAM STEEL Co. LTD

WOLSINGHAM, Co. DURHAM.

Nº 656

Rudder Stock

Amendment

BRITISH VENTURE 

BUNDERLAND RPT. NO 35024

RECORDS DEPT.,
LONDON



© 2021

Lloyd's Register
Foundation

002442-002448-0101