

Req 9 attached. Approved plans, Midship Section & Profile, forwarded.

Index No. (For London Office only.)

20 JAN 1931

Hull Rpt No. 20573

31592

# EXT COPY WRITTEN Lloyd's Register of Shipping. SURVEYS FOR FREEBOARD.-STEAM SHIPS.

PARTICULARS RELATING TO ALL STEAM SHIPS EITHER FLUSH DECKED, OR WITH GALLANT FORECASTLES, SHORT POOPS AND BRIDGE HOUSES DISCONNECTED, OR WITH TOP GALLANT FORECASTLES HAVING LONG POOPS, OR RAISED QUARTER DECKS CONNECTED WITH BRIDGE HOUSES, OR OTHERWISE.

Port of Survey  
Date of Survey *While building*  
Name of Surveyor *M. M. M. M.*

Ship's Name. *S.S. Portavon* No. 265  
Port of Registry and Nationality. *British*  
Official Number. *148319*  
Gross Tonnage. *44588*  
Date of Build.  
Particulars of Classification. *+100A1 (Contemplated)*

Registered Dimensions from Ship's Register.	LENGTH.	BREADTH.	DEPTH.	UNDER DECK TONNAGE.
	<i>176.6</i>	<i>28.45</i>	<i>11.4</i>	<i>443.98</i>
Length on LOADLINE.	<i>176</i>	Frame Depth <i>5 1/2</i> Rule <i>3 1/2</i> <i>- .33</i> <i>+ .33</i>	Ceiling <i>fitted</i> Sheer <i>+ .47</i> <i>level tank</i> <i>to top of D.B.</i> <i>11.60'</i>	Peak } Incl. Tanks } <i>High floors in</i> <i>EB = +5.5</i> <i>Low floors</i> <i>BR = -3.6</i>
CORRECTED DIMENSIONS.	<i>176.0</i>	<i>28.45</i>	<i>12.07</i>	<i>44588</i>

Moulded Depth as measured..... *13'-6"*  
Addition for Keel below base line for draught record..... *one* inches.  
NOTE. - If the depth is measured when vessel is afloat, the details of measurement should be reported.  
*13-6*  
*7 1/2*  
*14-1 1/2*  
*2-6 1/4*  
*11-7 1/4*

CORRECTION FOR LENGTH.  
Length of Ship on Loadline..... *176*  
Length in Table ..... *162*  
Difference ..... *14*  
Correction for 10ft., Table A. .... *.9* Table C.  
x Difference divided by 10 ..... *1.26* (if required.)  
If  $\frac{1}{10}$ ths length covered divide by 2 *.63* *+ 3/4"*

CORRECTION FOR IRON DECK.  
Proportion covered, if less than  $\frac{1}{10}$ ths length covered ..... *no wood deck*  
Thickness of usual wood deck, less stringer ..... *3* *- 3"*

CORRECTION FOR ROUND OF BEAM.  
Breadth at Gunwale amidships..... *28'-4"*  
Round of Beam ..... *7 1/2*  
Normal round..... *7.08*  
Difference ..... *4.2*  $\div 2 =$  *.21*  
Proportion of Deck uncovered (Para. 19) ..... *.233*

Freeboard, Table A ..... *2'-1"*  
Correction for Sheer ..... *4 1/4"*  
*1'-8 3/4"*  
Correction for Length ..... *1'* *9 1/2"*  
Allowance for Deck Erections ..... *10"*  
*0'-11 1/2"*  
Correction for Round of Beam..... *✓*  
Correction for fall in Sheer (if any)..... *✓*  
Correction for Steel Deck (if required) ..... *3"*  
*0'-8 1/2"*  
Additions for non-compliance with provisions of  
Para. 11 (d) and (e)  $\dagger$   
Other Corrections (if any) *Raised Quarter Deck* *+ 4'-3"*  
*4'-11 1/2"*

Winter Freeboard ..... *4'-11 1/2"*  
Summer Freeboard ..... *(1 1/2 - 2) = -2"* *4'-9 1/2"*  
Indian Summer Freeboard ..... *✓*  
N. A. Winter Freeboard ..... *✓*

Correction necessary because clearside amidships, measured in accordance with the Statute, is not taken at the intersection of the wood or steel deck with side. *1 1/4"*

Winter Freeboard from deck line ..... *5'-0 3/4"*  
Summer " " " ..... *4'-10 3/4"*  
Indian Summer " " " ..... *✓*  
N. A. Winter " " " ..... *✓*

FREEBOARD recommended amidships from centre of Disc to top of Statutory Deck Line, Wood (Steel) Deck :-  
Fresh Water Line above centre of Disc ..... *3*  
Indian Summer Line " " " ..... *✓*  
Winter Line below " " " ..... *2*  
Winter North Atlantic Line " " " ..... *✓*

Co-efficient of fineness..... *.738*  
Any modification necessary }  
[Para. 4 (a) to (e)]\* } *C.D.B.*  
Co-efficient as corrected ..... *.72*

Sheer { Stem..... *57*  
at { Sternpost... *33* } *90' ÷ 2 = 45"* Mean  
Sheer at  $\frac{1}{2}$  of the length from { Stem *31*  
Sternpost *18* } *49' ÷ 2 = 24.5"* Mean  
*÷ .85 = 44.54"*  
Gradual mean Sheer ..... *44.54"*  
Standard mean Sheer [Table, Para. 18] ..... *27.60* Correction  
Difference..... *16.94*  $\div 4 =$  *4.24*  
§ If limited as Para. 18 (f) ..... *- 4 1/4"*

Rise in Sheer { At front of bridge house..... *✓*  
from amidships {  
[Para. 18 (e)] { At after end of forecastle ..... *✓*  
Fall in Sheer }  $\div 2 =$  *✓*  
Para. 18 (d) }  
Length uncovered ..... Correction

ALLOWANCE FOR DECK ERECTIONS :-  
Freeboard, Table C..... *0'-5"*  
Correction for Length, if required (Para. 12, 13, and 14) ..... *✓*  
Freeboard by Table A, corrected for sheer, and for length, if required (Para. 11, 12, 13, and 14) }  
Difference ..... *1'-8 3/4"*  
Percentage as below..... *1 - 3 3/4"*  
*65.05%*  
*- 10.24"*

Correction for R. Q. Dk. if engine and boiler openings not covered by bridge house (Para. 11) } *+ .35*  
Allowance for Deck Erections ..... *9.89*  
*- 10"*

	Length.	Length allowed.	Height.
Forecastle.....	<i>23'</i>	<i>22.70</i>	<i>6-11</i>
Bridge House .....	<i>11'</i>	<i>11.00</i>	<i>7-2'</i>
† Raised Qr. Dk.....	<i>101.33'</i>	<i>101.33</i>	<i>4'-3"</i>
Peop.....	<i>✓</i>	<i>✓</i>	<i>✓</i>
Total .....	<i>135.03</i>	<i>135.03</i>	<i>.767</i>
Length of Ship .....	<i>176</i>		

Corresponding percentage }  
(Para. 11, 12, 13, or 14) } *65.05%*

FREEBOARD recommended amidships from centre of Disc to top of Statutory Deck Line, Wood (Steel) Deck :-  
Fresh Water Line above centre of Disc ..... *3*  
Indian Summer Line " " " ..... *✓*  
Winter Line below " " " ..... *2*  
Winter North Atlantic Line " " " ..... *✓*

† If the frames, skin planking, or ceiling are of unusual thickness the breadth of vessel to inside of ceiling should be reported if possible.  
† If vessels obtaining an allowance for deck erections under Para. 11 where the sheer drops abaft amidships the height of the R.Q.D. is to be taken from the level of the top of the amidship beam.  
† In vessels having poops and forecastles, it means the sheer measured at points distant one-eighth of the vessel's length from stem and stern-post.

State dimensions of freeing port area on back of this form.  
The Surveyor should state whether the fall in sheer as reported is measured relatively to the straight line of keel or to the water line. If measured relatively to water line the vessel's draft at time of survey, and also the normal load draft forward and aft, should be reported.  
MARKING FORM  
RECEIVED 29 AUG 1931  
RECEIVED 3 FEB 1930

002442-002448-0187



Do all the Frames extend to the top height in the Poop? ☒ Raised Quarter Deck? *yes* Bridge House? *yes* Forecastle? *yes*

To what height do the Reverse Frames extend? *None*

Has the ~~Poop or~~ Raised Quarter Deck an efficient ~~Iron~~ Bulkhead at the fore end? *yes*

Give particulars of the means for closing the openings in Bulkhead *no openings*

Is the ~~Poop or~~ Raised Quarter Deck connected with the Bridge House? *yes* Has the Bridge House an efficient Bulkhead at the fore end? *yes*

Give particulars of the means for closing the openings in Bulkhead *no openings*

What is the thickness of the Bridge Front plating? *30* and Coaming plate? *30*

Give scantlings and spacing of the Stiffeners *6 x 3 x .32 B.A. spaced 30"*

Are bracket plates fitted at each end of the Stiffeners? *yes* Are hor'l. brackets fitted connecting Bridge Bulk'd. with Bulwarks? *yes*

Has the Bridge House an efficient ~~Iron~~ Bulkhead at the after end? *yes*

How are the openings closed? *no openings*

Is the Forecastle at least as high as the main or top-gallant rail? *yes* Has the Forecastle an efficient ~~Iron or Wood~~ Bulk'd. at after end? *yes*

Are the Engine and Boiler openings covered by a Bridge, Poop, Raised Quarter Deck, or enclosed by a Strong Iron or Steel Deckhouse? *by Raised Quarter deck*

If the openings are not so protected are the exposed parts of the Casings efficiently constructed? ☒

Give thickness of plating; scantlings and spacing of Stiffeners ☒

What is the height of the exposed Casings? *6-9"* Are suitable means provided for closing all openings in them in bad weather? *yes*

Are the Weather Deck Hatchways efficiently constructed and at least equal to the requirements of the Rules? Give particulars below:— *yes*

Position.	Forward	Keel	On Raised Quarter Deck						
Size.	31'-6" x 17'-6"		32'-4" x 17'-6"						
Height above top of DECK	3'-6"		3'-0"						
COAMING Thickness { Sides.....	.42		.42						
Ends.....	.42		.42						
SHIFTING BEAMS OR WEB PLATES. { Number.....	6		6						
Section and Scantlings.....	15" x .34		15" x .34						
Material.....	Steel		Steel						
* FORE AND AFTERS. { Number.....	none		none						
Section and Scantlings.....									
Material.....									
HATCHES Thickness.....	2 1/2"		2 1/2"						
Remarks.....									

\* The depth of Fore and Afters should be stated from the underside of the hatches in all cases.

(If the sill of the lowest side scuttle will be less than 6 inches above the Indian Summer Load Line if assigned under the tables, state vertical distance from top of keel to lower edge of lowest side scuttle.)

The following information is to be given in all Cases of vessels dealt with under Paras. 11, 12 (under 15 feet Moulded depth) and under Shelter Deck Rules.

What is the thickness of the Bridge Sheerstrake? *.26* Strake between Main and Bridge Sheerstrakes? *.56*

Delete the words { The Crew ~~are~~ are not, berthed in the bridge house. *will be made*

that do not apply { The arrangements to enable them to get backwards and forwards from their quarters ~~are~~ are not satisfactory. *are*

Length of Bulwarks in well *40 feet*



Area of Freeing Ports required by Para. 11 (e) each side of vessel = *10.5* Sq. ft.

in well { Ft. Tenths. Ft. Tenths. No. Freeing Ports = *14.9* Sq. ft.

(each side of vessel)

R.Q.Dk. { 2.75 x 1.5 x 4

Total deficiency or excess = *4.4* Sq. ft.

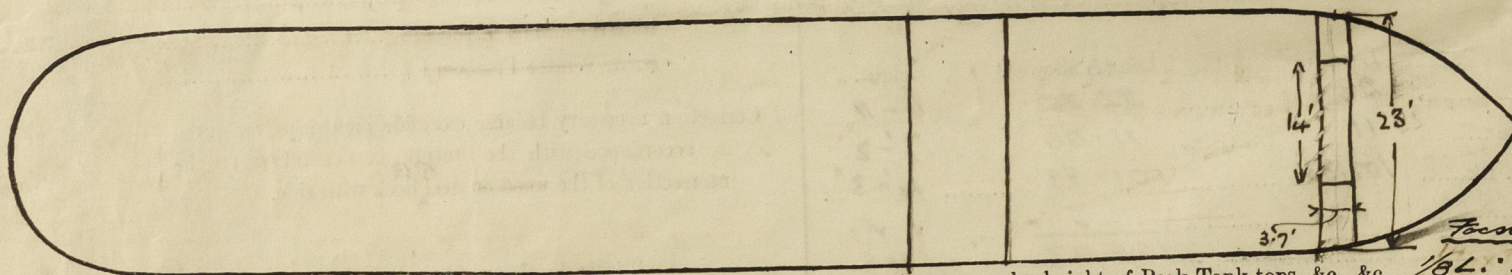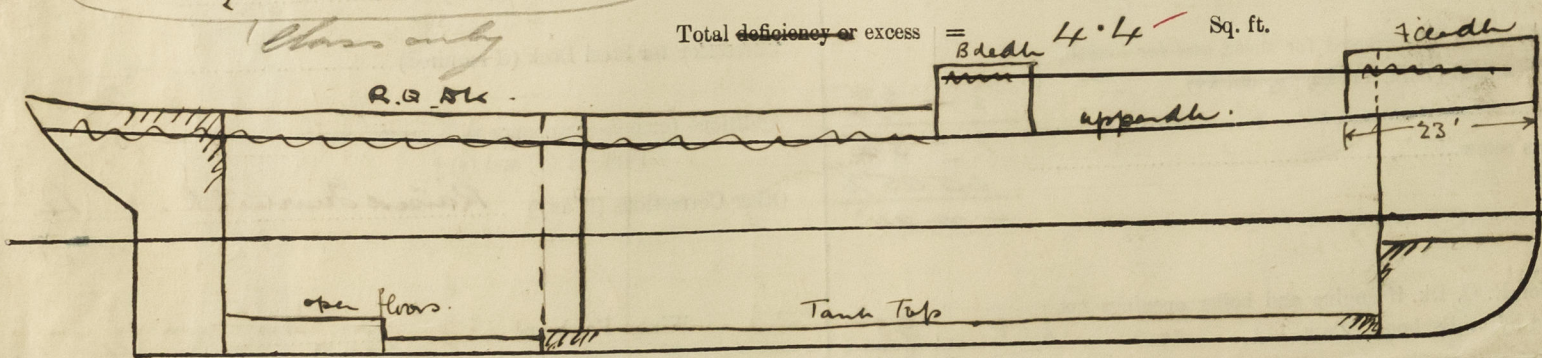

Show hereon line of Floors or Tank Top with position of any Breaks in same, also height of Peak Tank tops, &c., &c.

State any special features in the construction of the Vessel *Keel laid in August 1925.*

Builder's name and yard number *Goole Shipbuilding & Repairing Co (1927) Ltd. Yard No 265.*

Names of sister vessels

Owners *Portfield Shipping Co. Ltd of Cardiff. W.E. Hinde of Cardiff. Ingers.*

Address

Fee £ *3* : *6* : *8*

Not yet. To be applied for with 9. E. Fees.  
Received by me *See F.E. Report.*