


**FORCED STEEL TILLER.**


**HYD. GEAR** 278-1279

**SCALE 3" = 1 FOOT.**

**APPROVED**  
LLOYD'S REGISTER OF SHIPPING  
*H. Dickenson*  
DATE 10-7-36

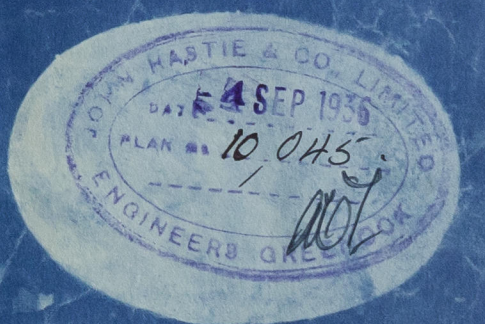

SHIP No 1514-1516 SWAN HUNTER + WIGHAM RICHARDSON.  
SURVEY. LLOYDS.

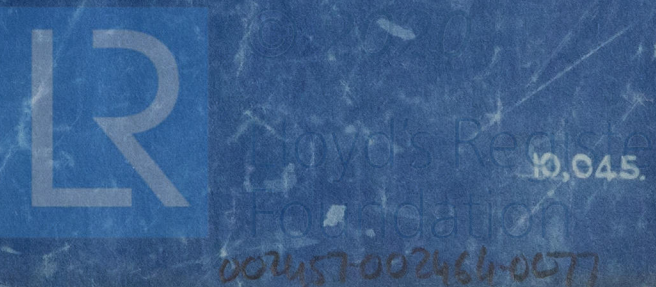



Sum Hunter to 1514-1516

Teller

M.S. "British Resolution"  
NEWCASTLE ON TYNE.

Report No. 95349.

M.S. "Arndale".


NEWCASTLE ON TYNE.

Report No. 95474.

m.v. "British Tenacity".

NEWCASTLE ON TYNE.

Report No. 97170.

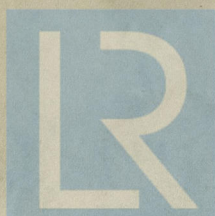

© 2020

Lloyd's Register  
Foundation

002457-002464-0077