




13.12.19

PROFILE & DECK PLAN


STEEL SCREW STEAMER

DIMS { 334.0 BP. 47.9 M.D. 24.11 M.D.
333.9 ON L.W.L.
SCALE 1/8"=1'-0"
CLASS 100A 1 LLO/SS.










DETAIL OF LARGE KNEES IN CENTRE & AT CORNERS OF BUNKER HATCH.

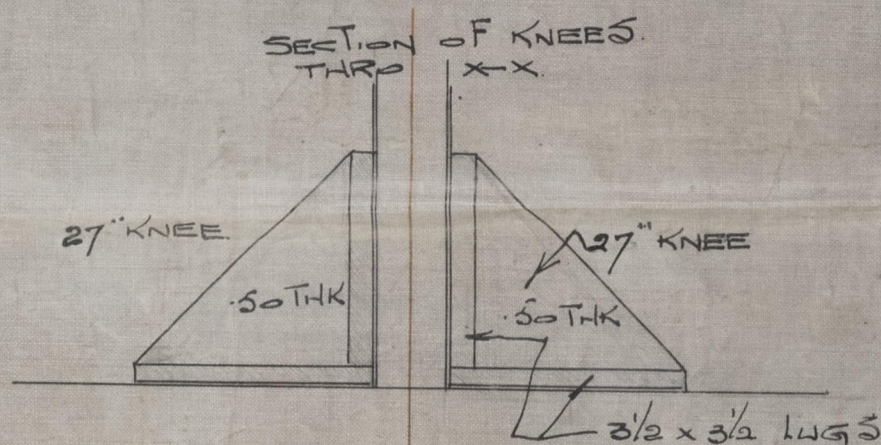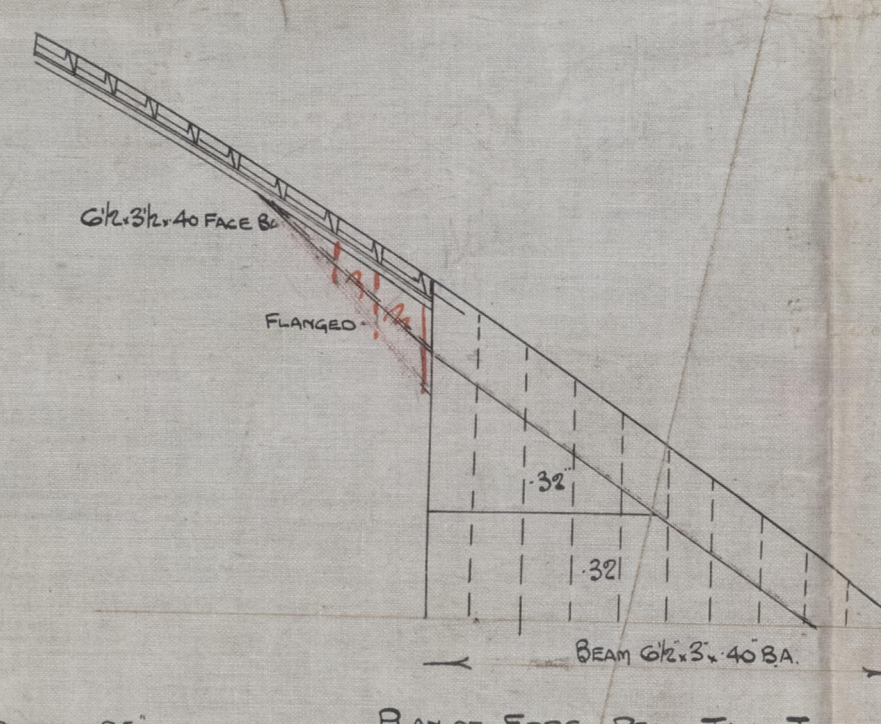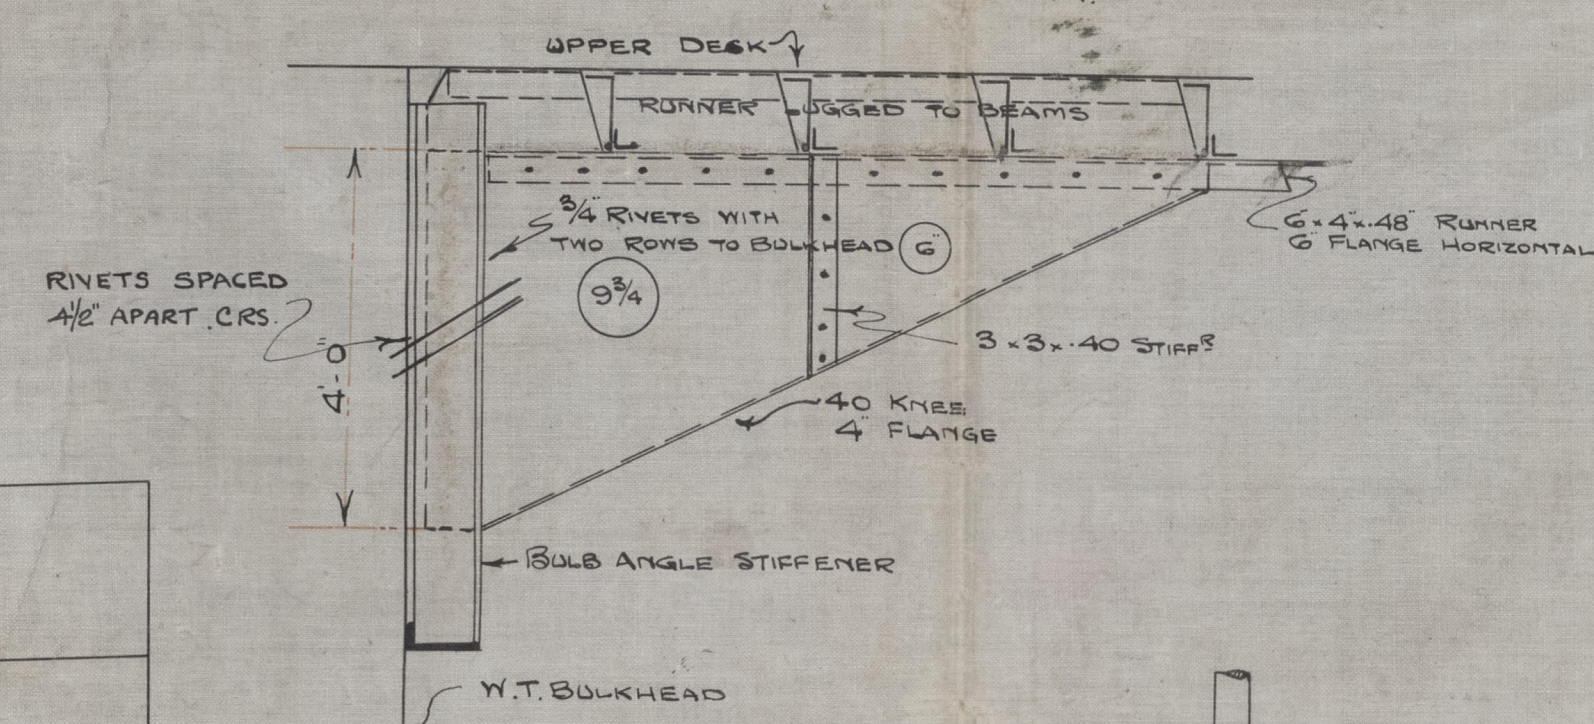

PLAN OF THWARTSHIP KNEES AT JOIST PILLARS.

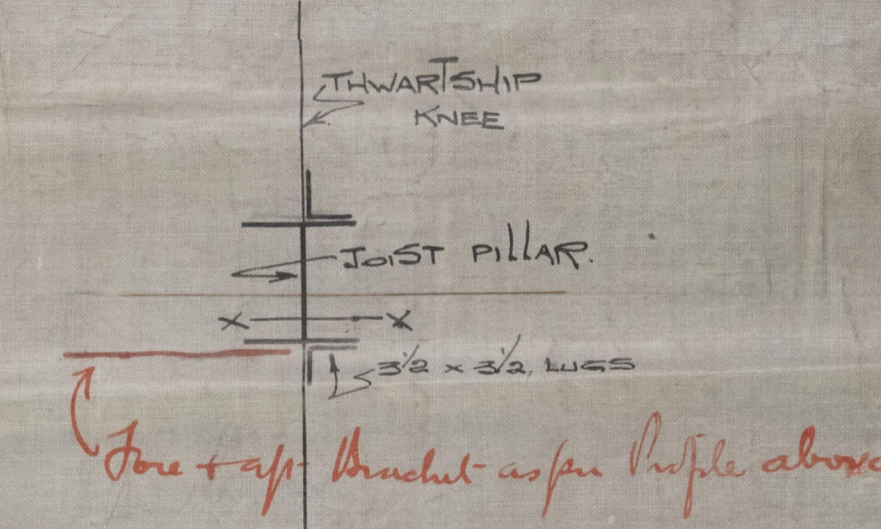

DETAILS OF BULKHEAD STEEL KNEES

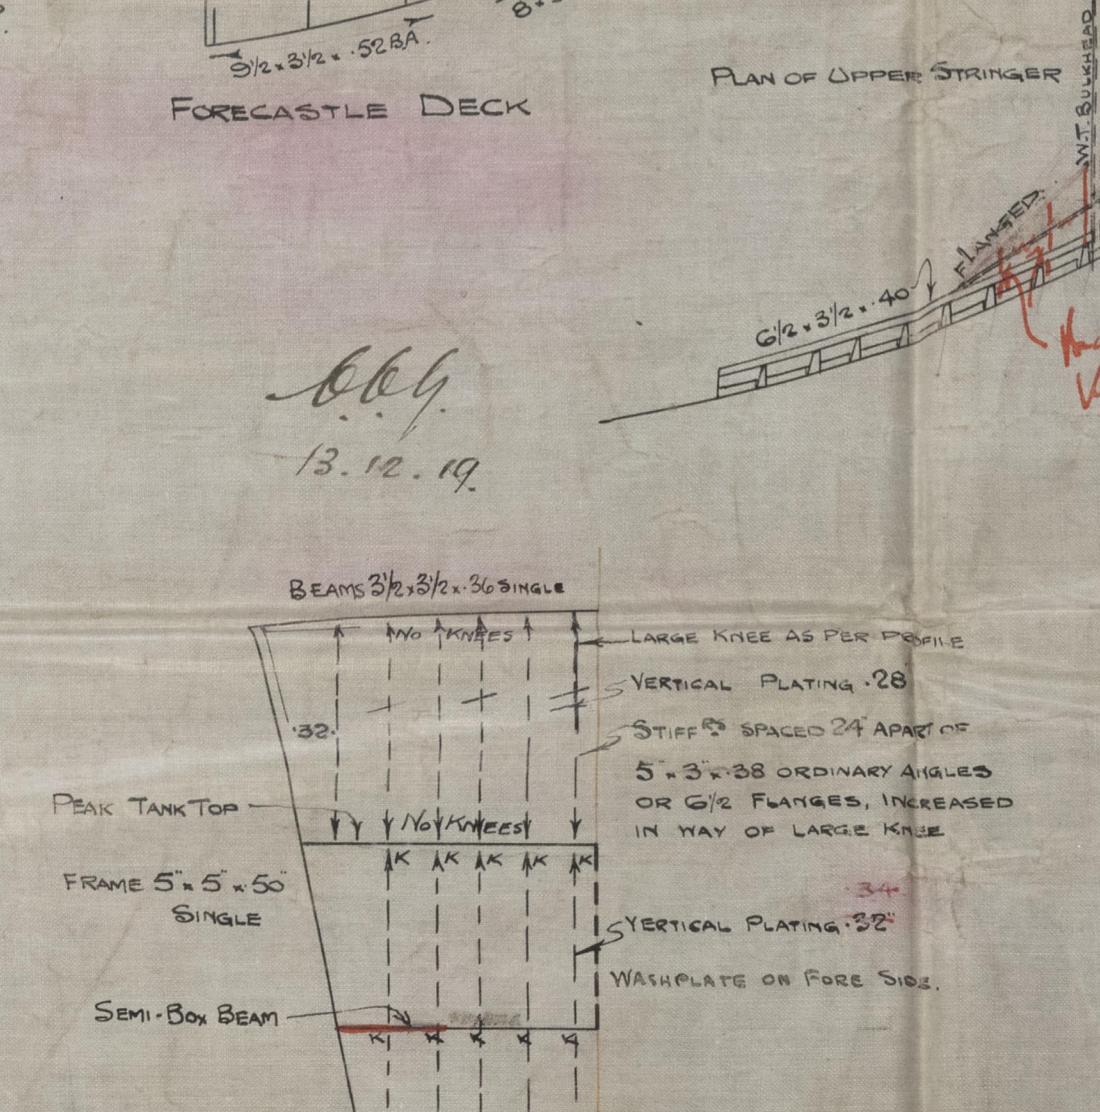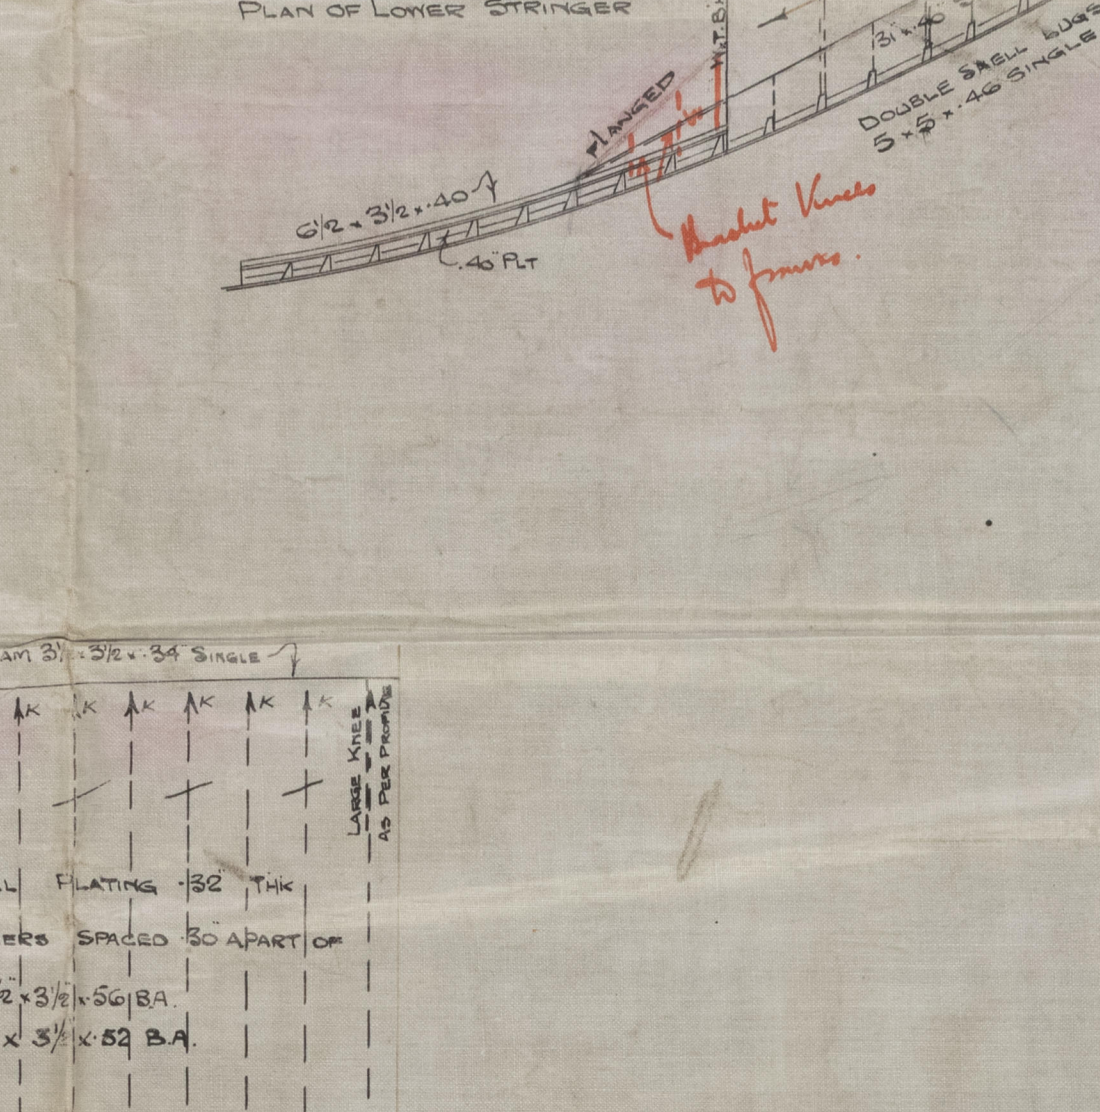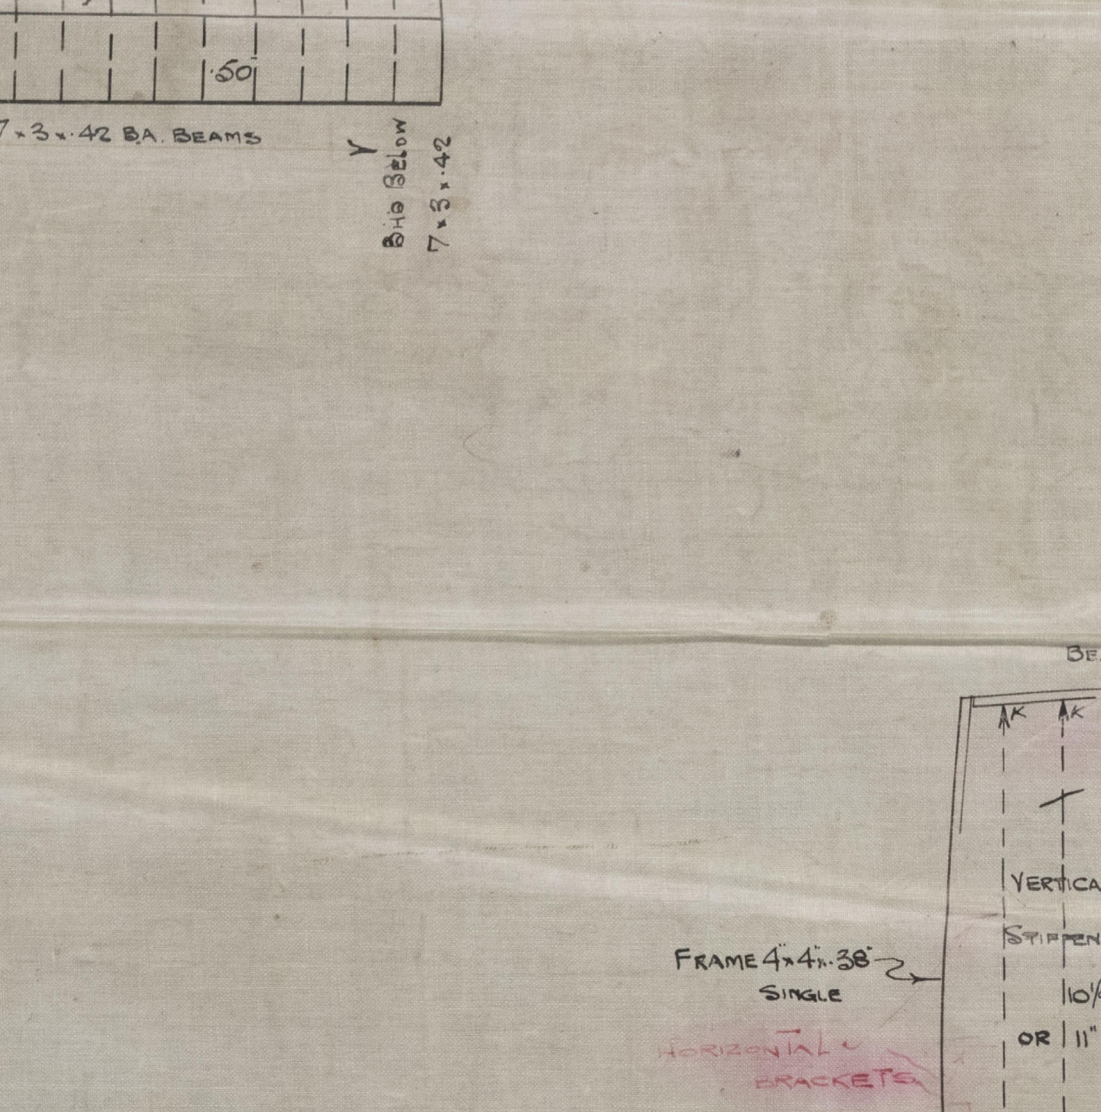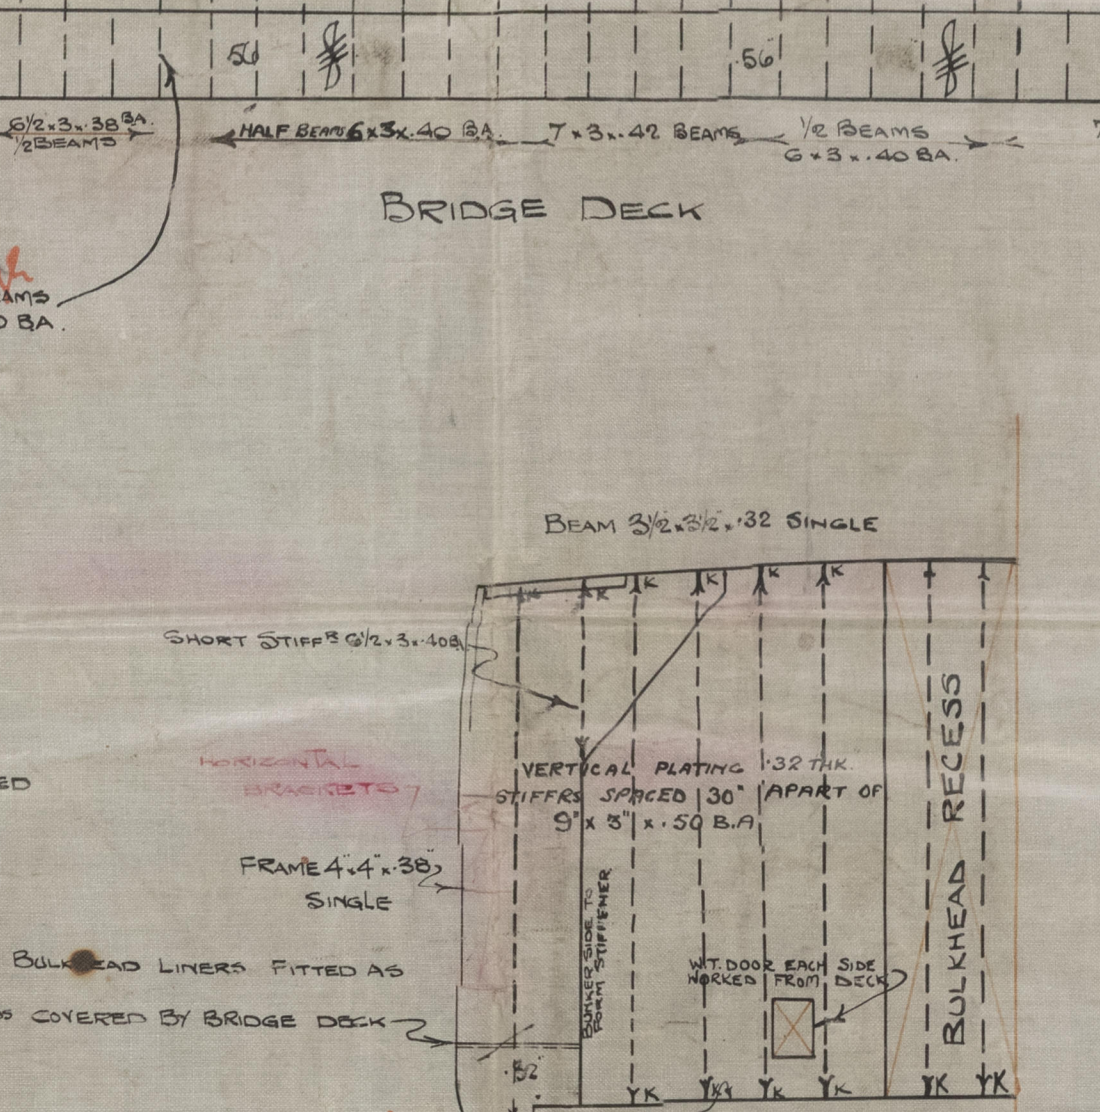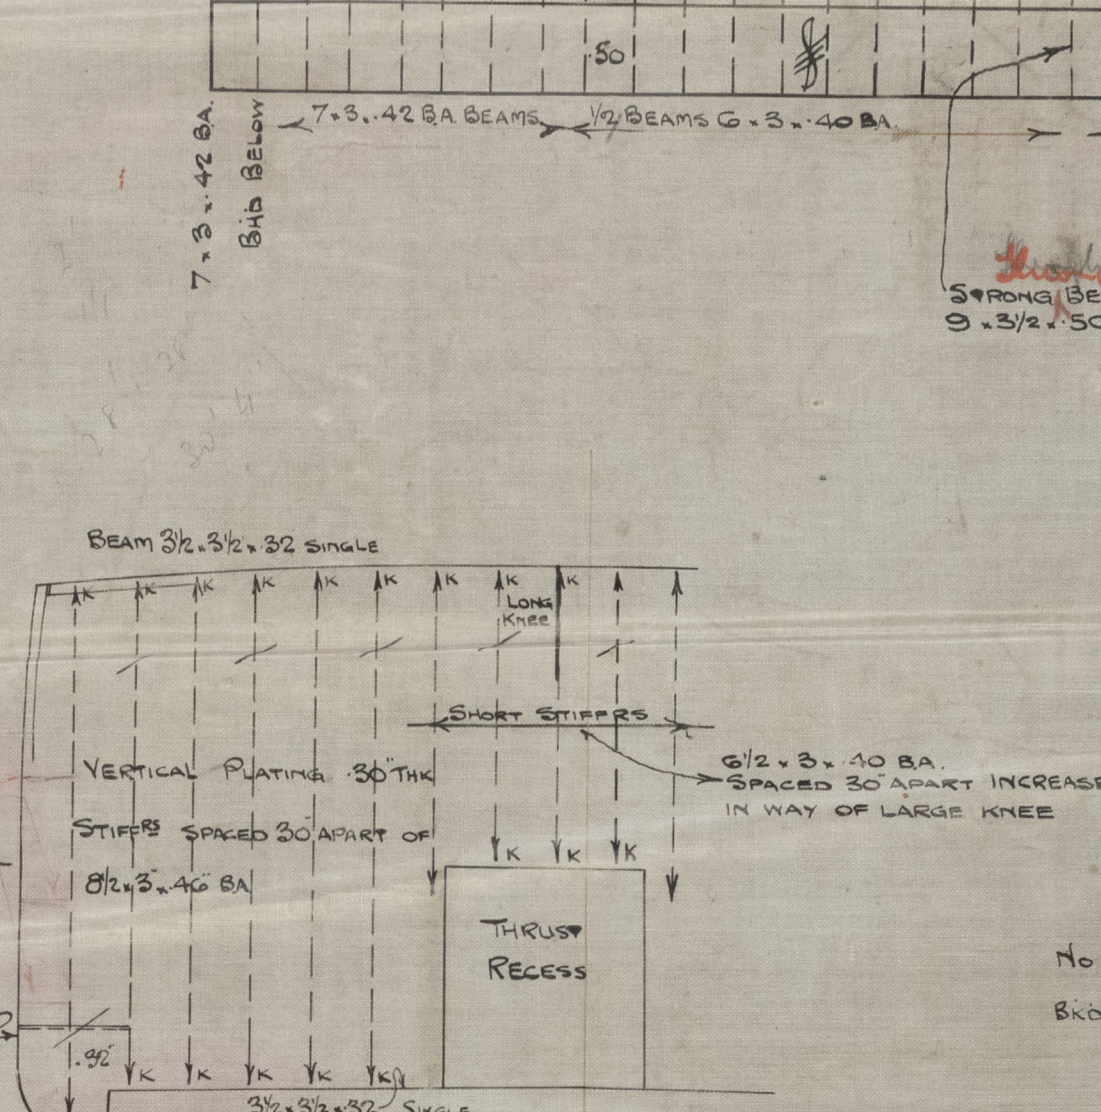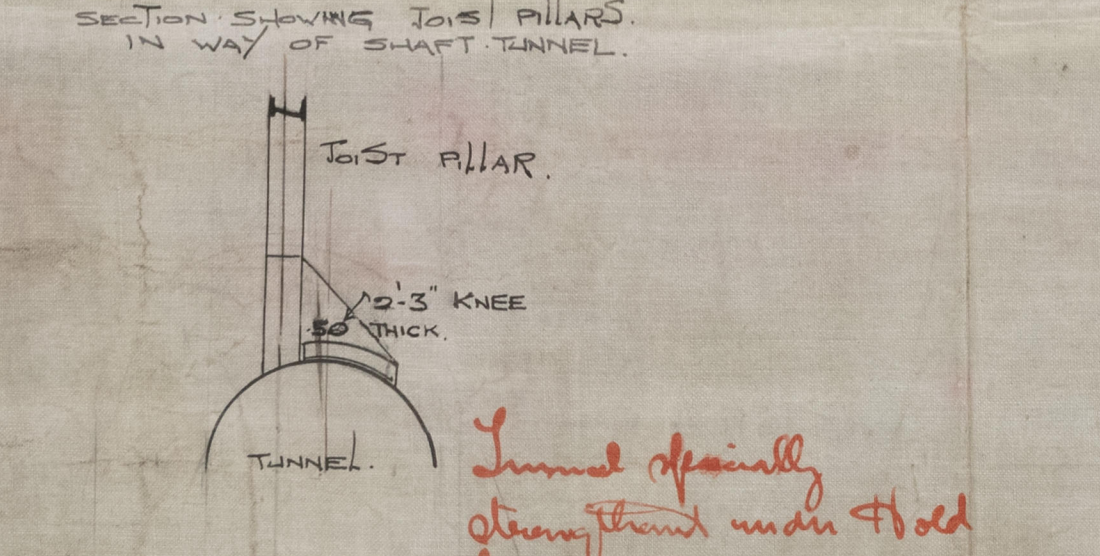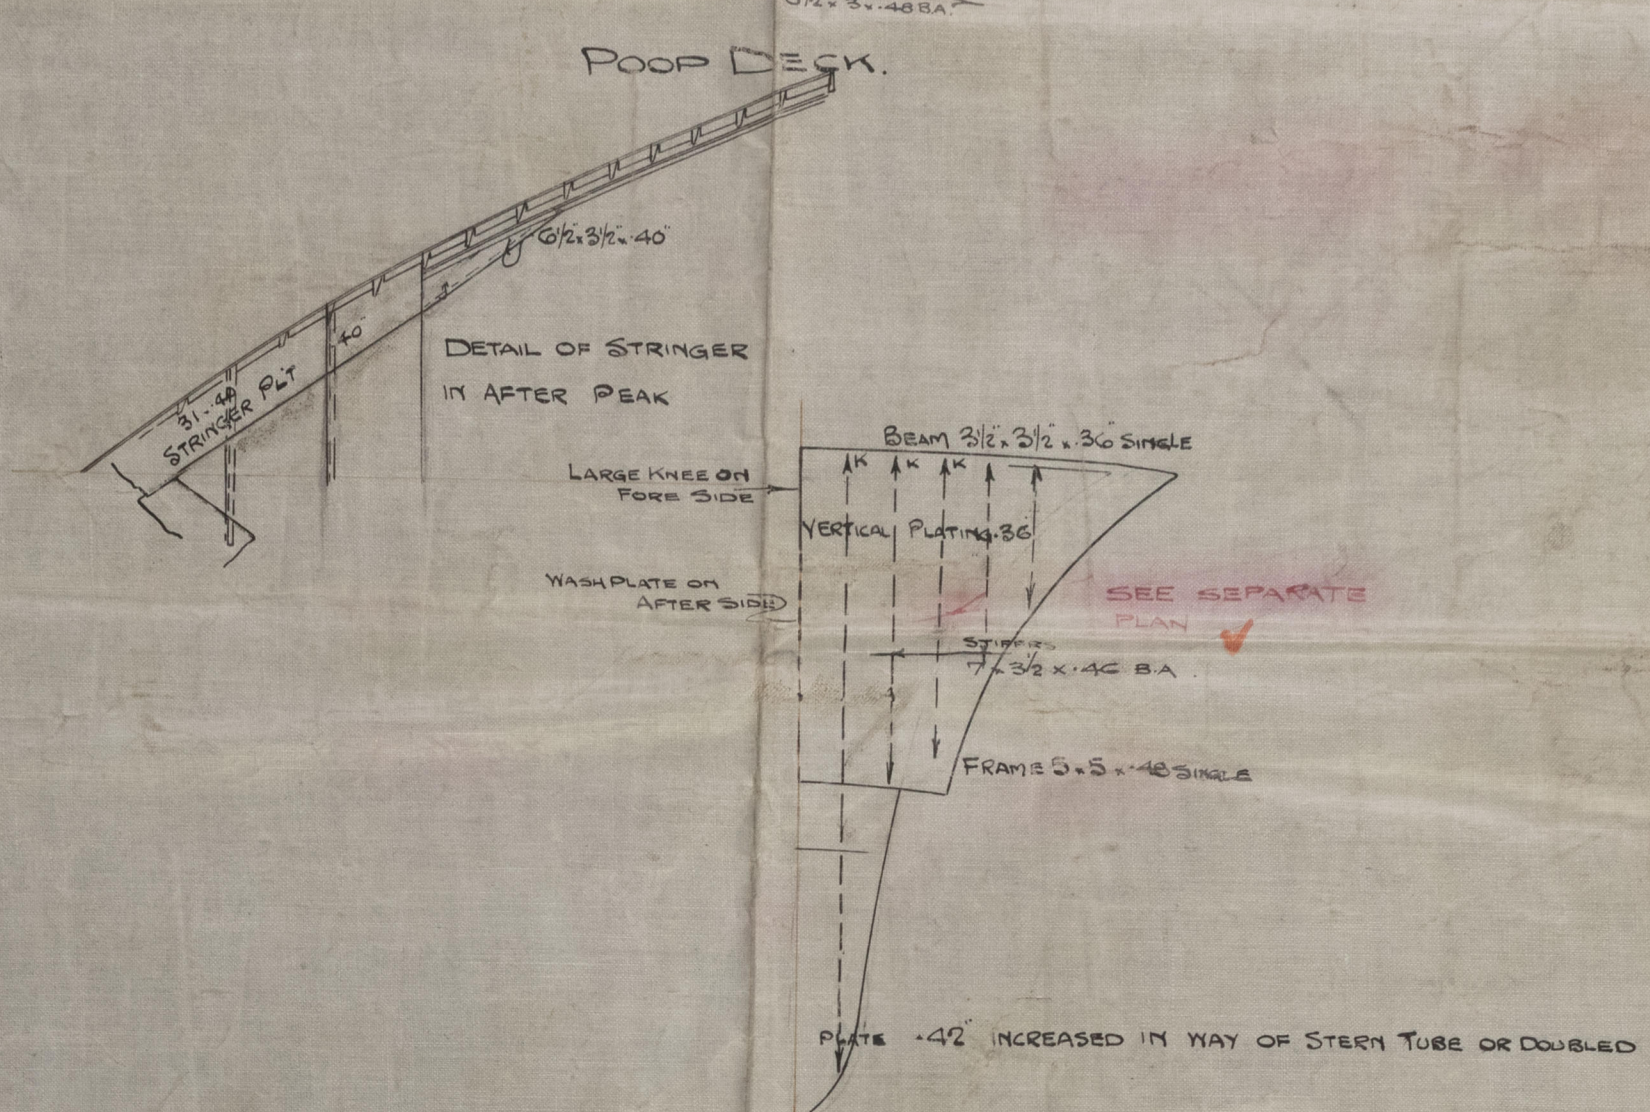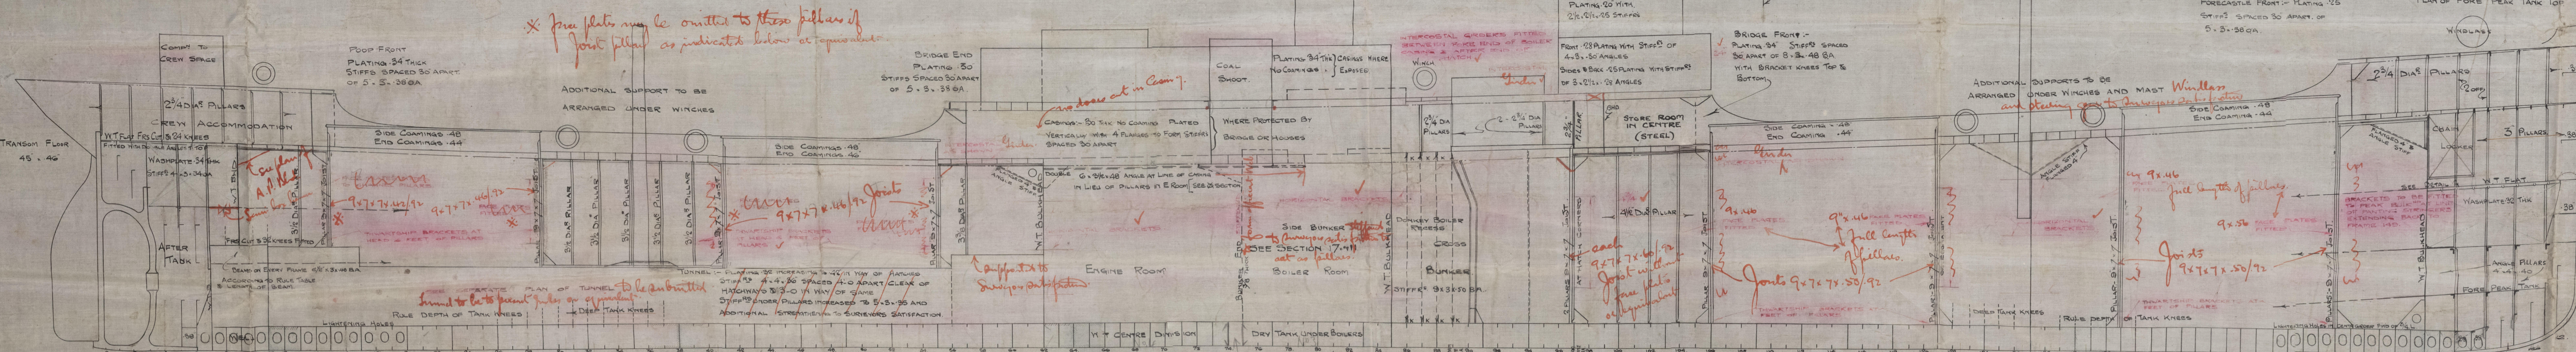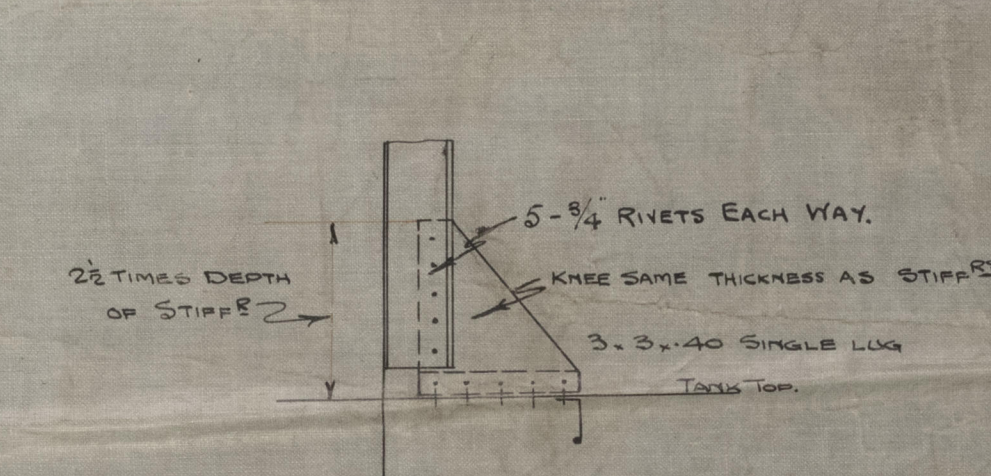

SMITHS DOCK CO. L.D.
SHIPBUILDERS & ENGINEERS

Nº 759

MARIA CRISTINA

~~EST~~

MESSRS
SMITHS Dock Co.

No 759

PROFILE & DECKS.

10782

- ARETI



© 2020

Lloyd's Register

002465-002470-0045

Foundation