


PROPOSED SINGLE SCREW STEAMER.

SCALE $\frac{1}{16}$ INCH = 1 FOOT.

DIMENSIONS.

LENGTH. FROM FORE PART OF STEM TO AFTER PART OF STERNPOST ON RANGE OF 26'-0" WATERLINE... 425'-0"
BREADTH MOULDED... 54'-6"
DEPTH... TO UPPER DECK AT LOWEST PART OF SHEER... 32'-9"

6 - JUL 1922

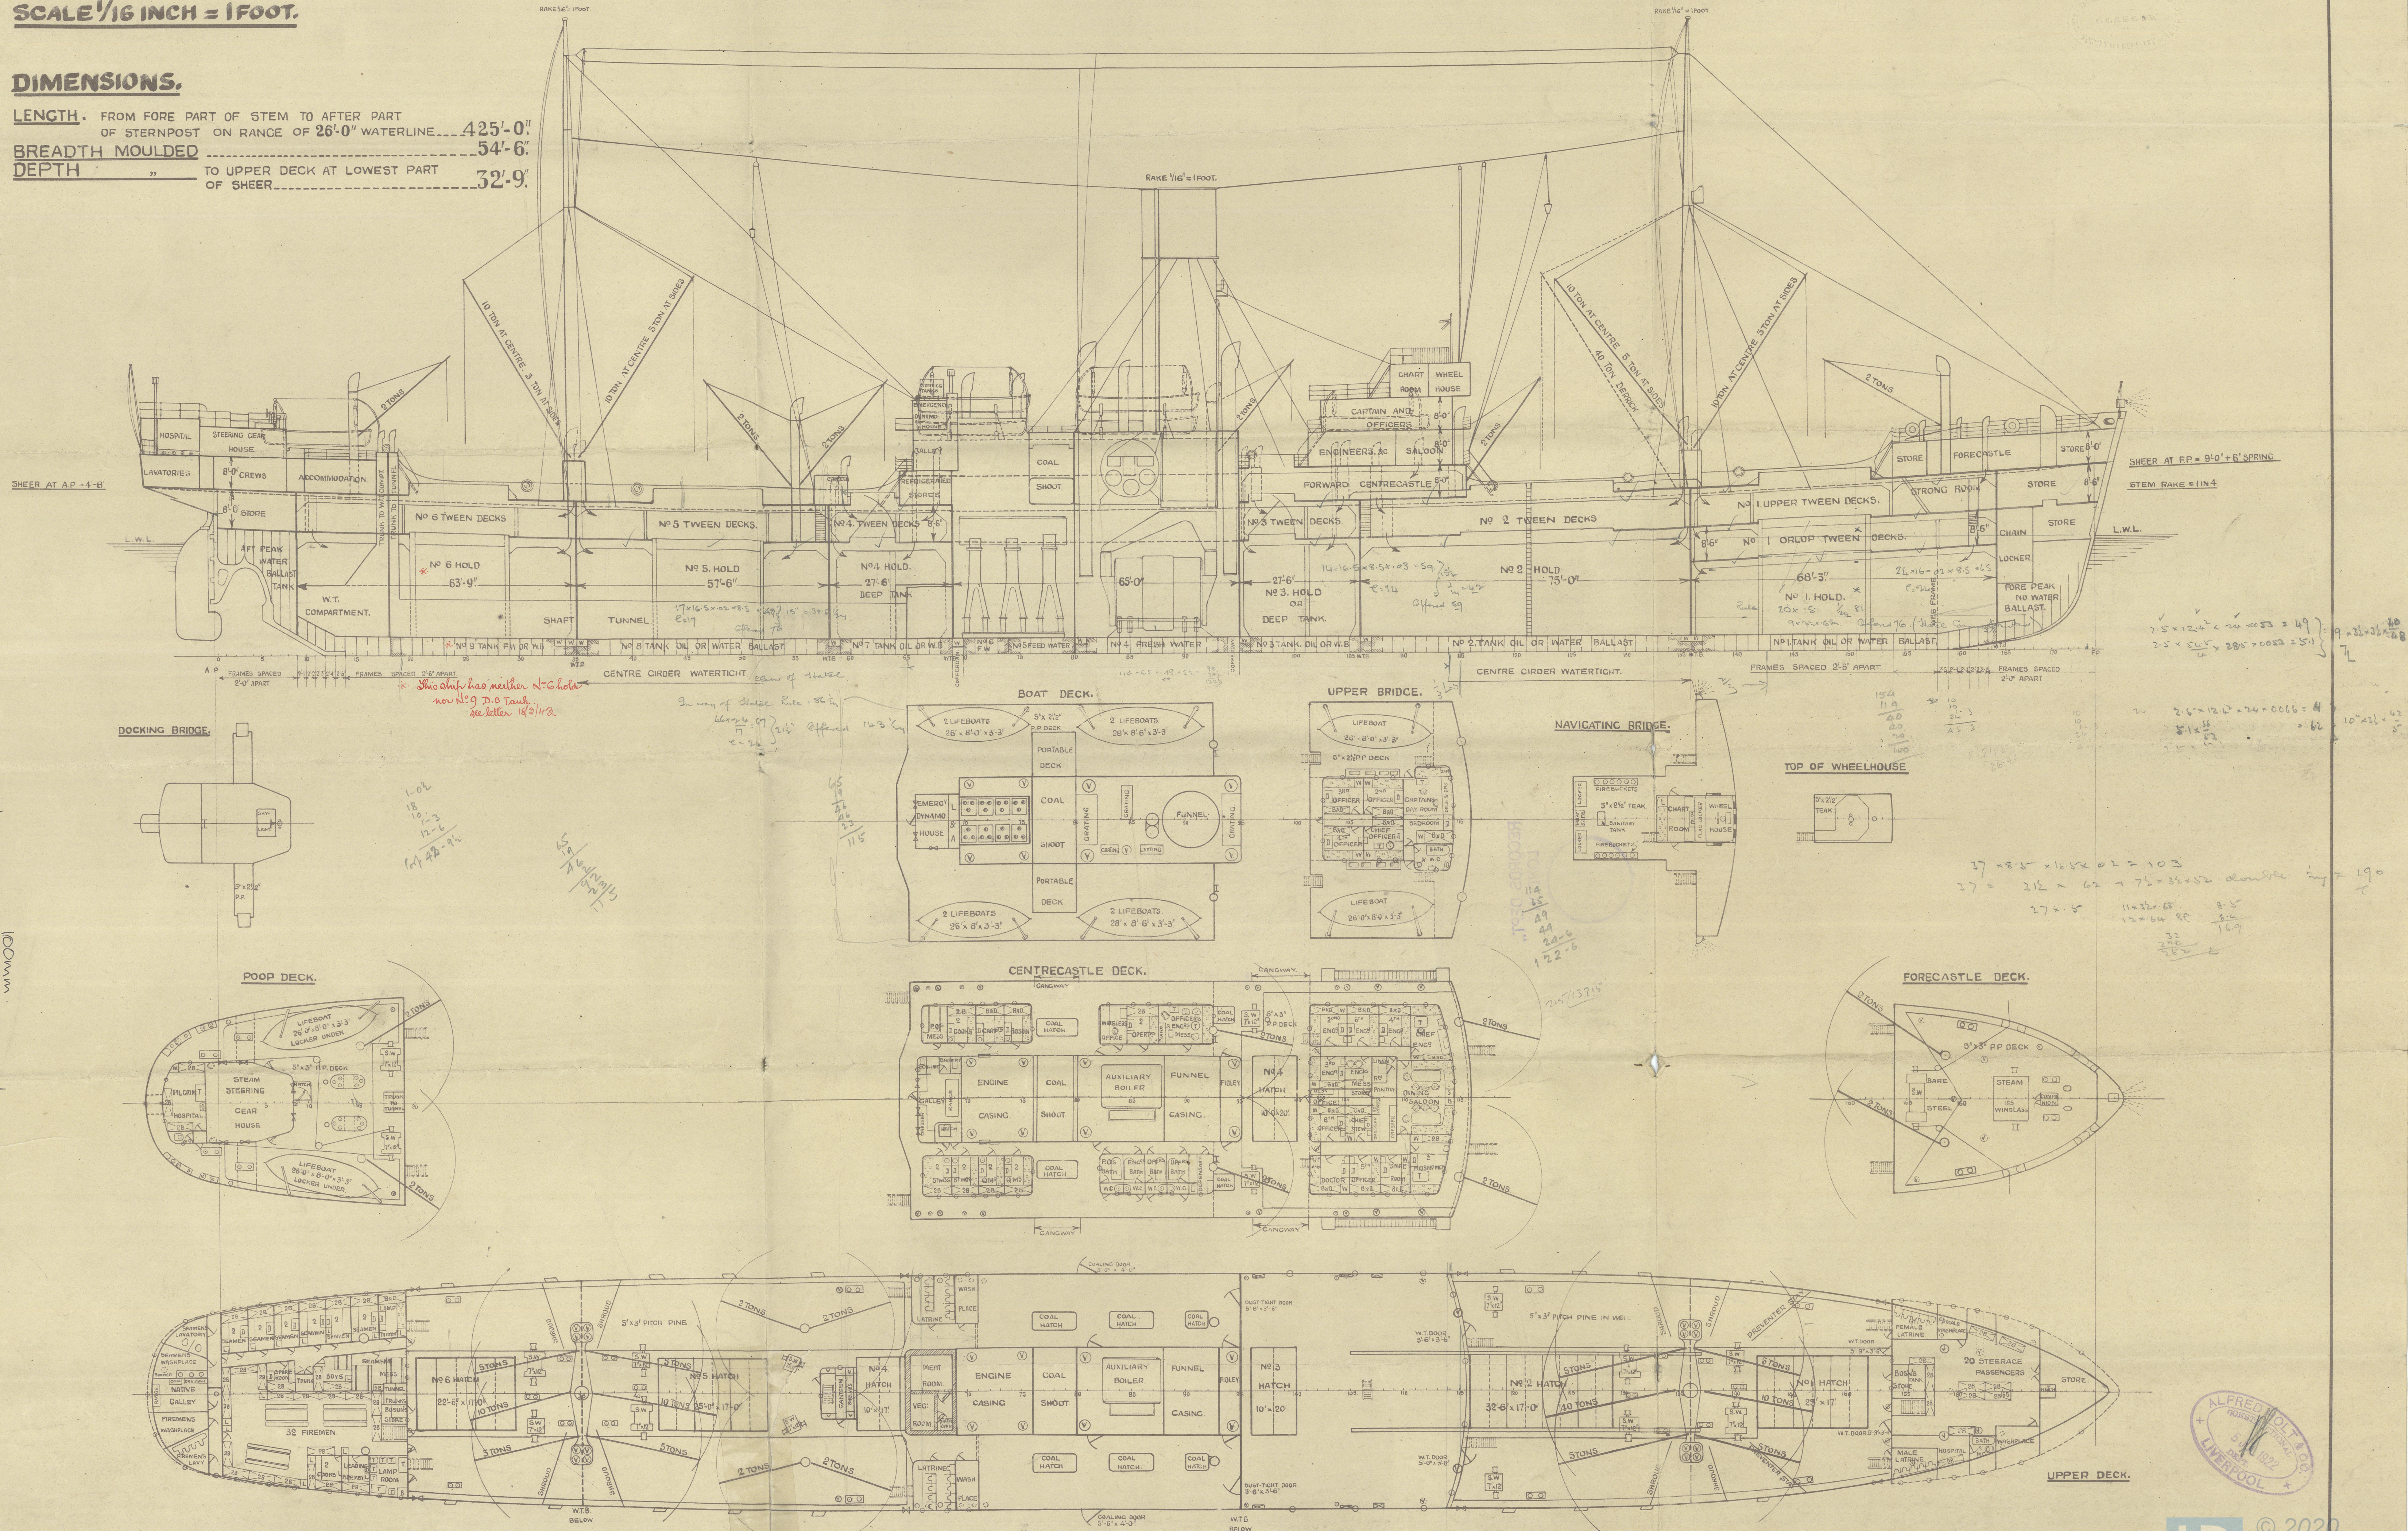

002498-002505-0148

A Holt & Co

pro S/S

Gen Arrangd

475 x 54'6 x 32'9"

Bag.

Y

Scotts 522. S/S

ASPHALION ★

A Holt & Co

pro S/S

General Arrangement
475 x 54'6 x 32'9"

10. 4 52

RECORDS DEPT.,
LONDON



© 2020

Lloyd's Register
Foundation

002498-002505-0148