


FOLD
HERE

STARBOARD SMOKEBOX

CENTRE SMOKEBOX

PORT SMOKEBOX

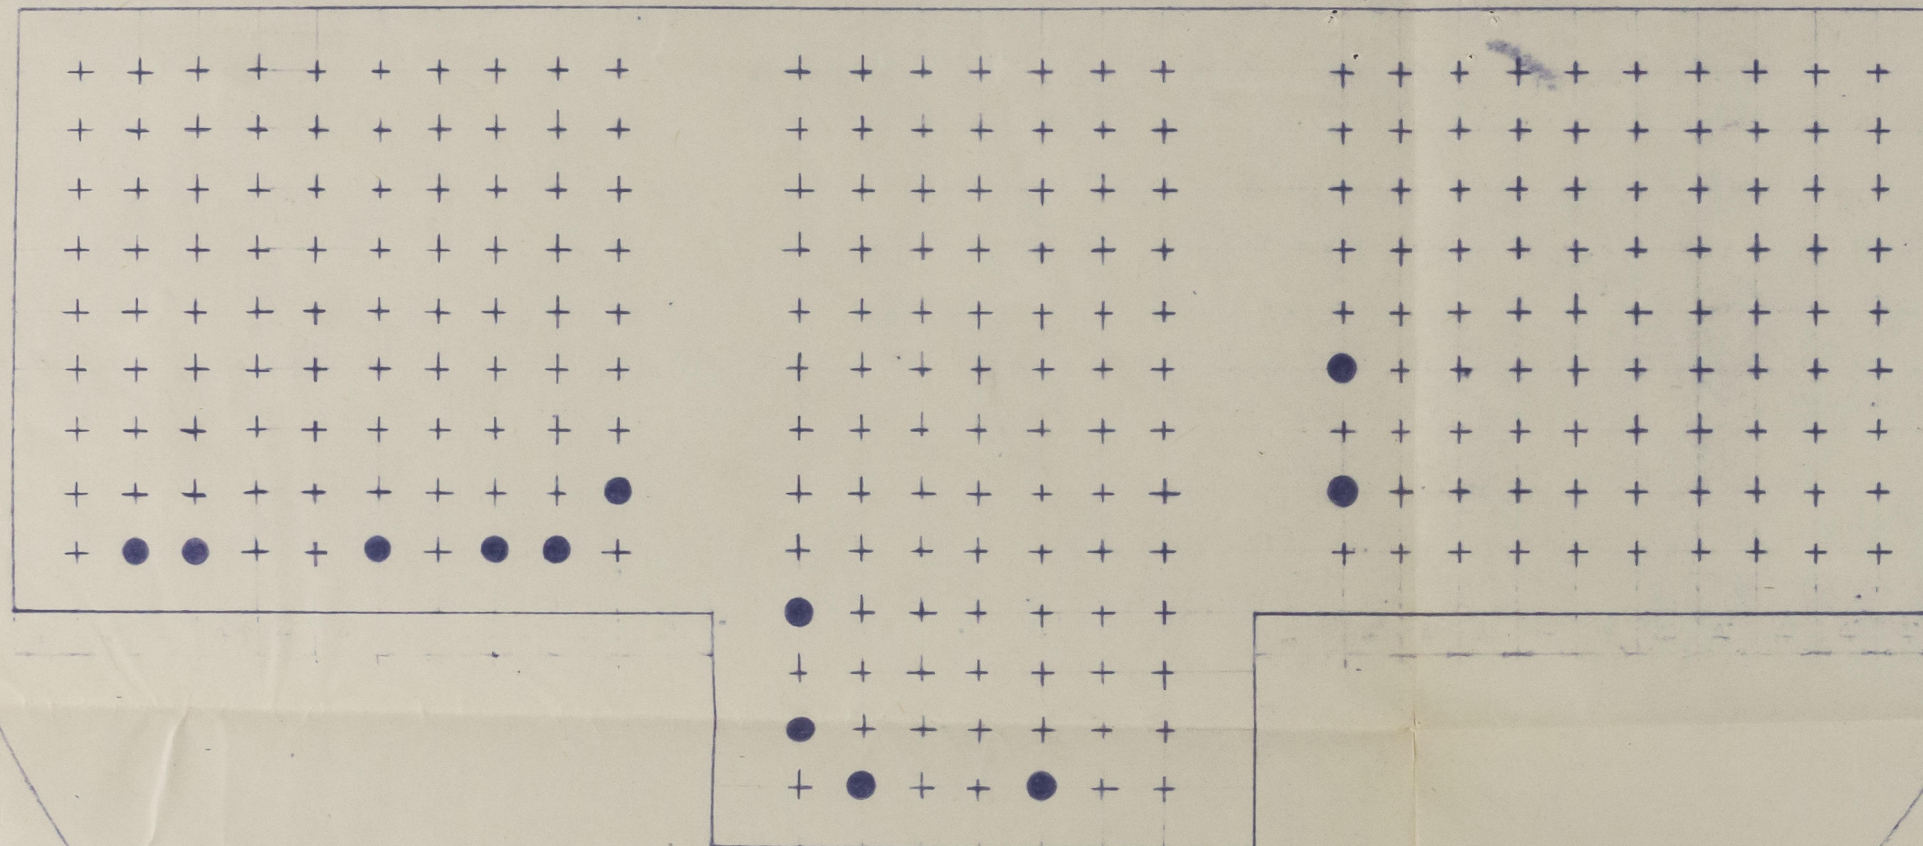

S.S. BALLYDUFF

POSITION OF NEW PLAIN TUBES (FITTED JANUARY 1957)

NOTE: ~ ● DENOTES NEW PLAIN TUBES

SCALE: 1" = 1'-0"

"BALLYDUFF"

Position of new plain tubes.

Gls. rept No. 88447.



© 2020

Lloyd's Register
Foundation

002506-002514-0142