


SCALE $\frac{1}{8}'' = 1 \text{ FOOT}$.

11.7.19 MODIFIED IN BLUE AS BUILT.

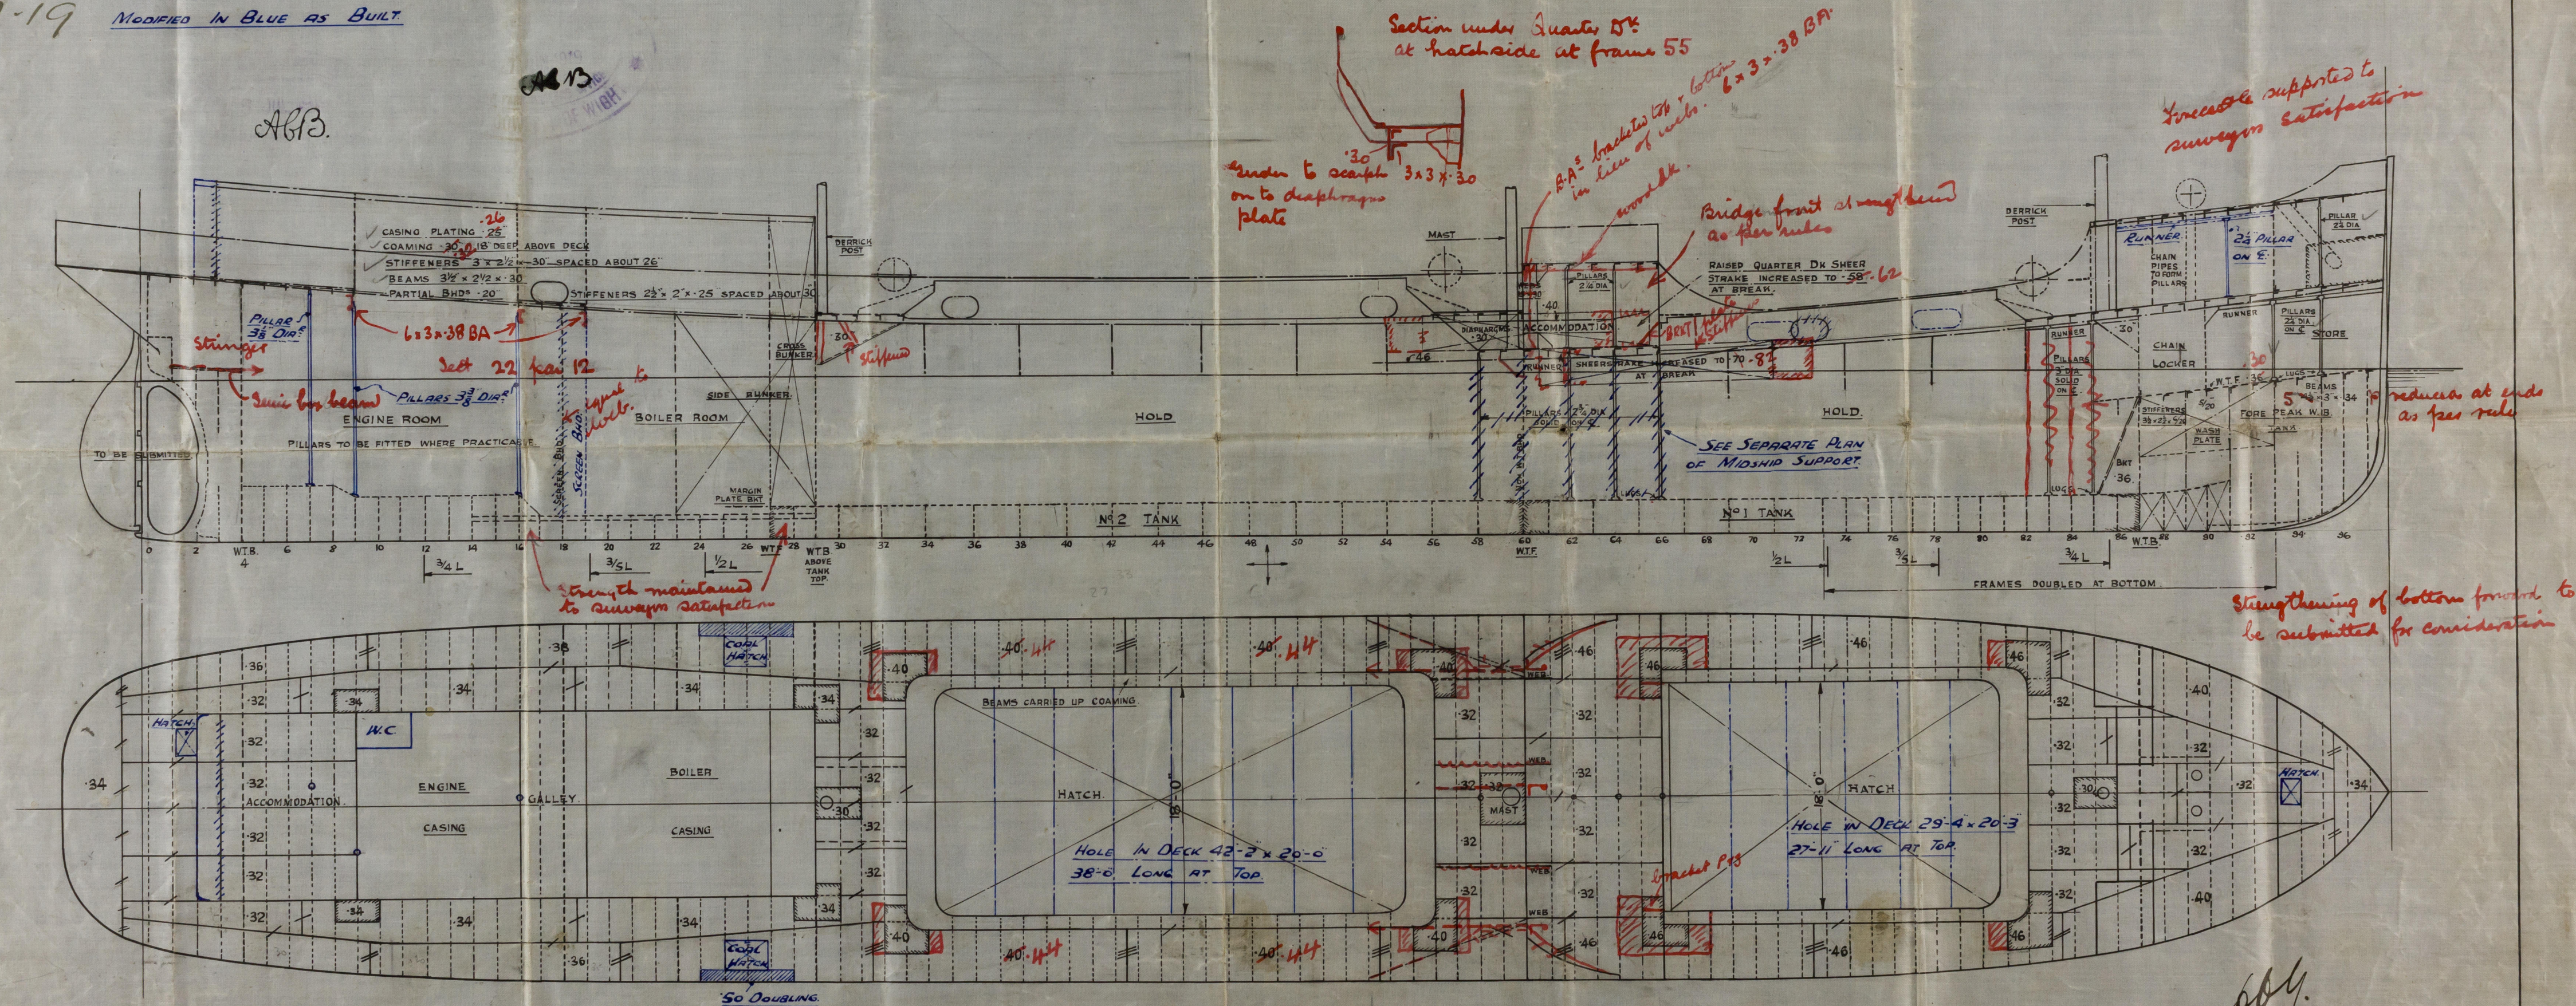

604.
11. 7. 19

002515-002521-0024

5/5 "Bilton"

Lon 10681.

Mass: J. S. White & Co.
East Comes I.W.

Profile & Deck.

N^o 1545-b-7

Section with station 106
at station 106.81



Section to south of station
106.81

Bridge front of station
106.81

RAISED QUARTER ON SHEER
STRAKE HIGHER TO
AT BILTON.



© 2020

Lloyd's Register
Foundation

002515-002521-0024