


A circular purple ink stamp. The outer ring contains the text "ROBT. DUNCAN & CO. LTD." at the top and "SHIPBUILDERS" at the bottom. The center of the stamp contains the date "28. MAY 1929" and the location "PORT-GLASGOW" below it.

PLAN OF STRENGTHENING AT BRIDGE
ENDS TO BE SUBMITTED.

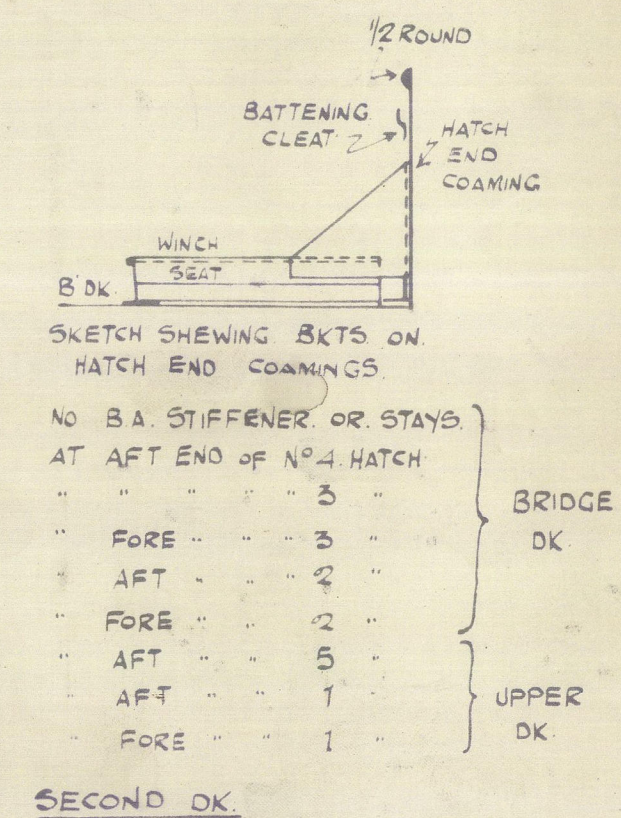

MESSRS.

ROBERT DUNCAN & CO., LTD.,

N^o. 390.

DECKS (AS BUILT)

S. S. "ROMNEY".

GREENOCK REPORT N^o. 19047..



© 2020

Lloyd's Register
Foundation

002522-002528-0070