



121 BH<sup>o</sup> 23 STR<sup>o</sup>




BH<sup>o</sup> 33 STB<sup>o</sup>

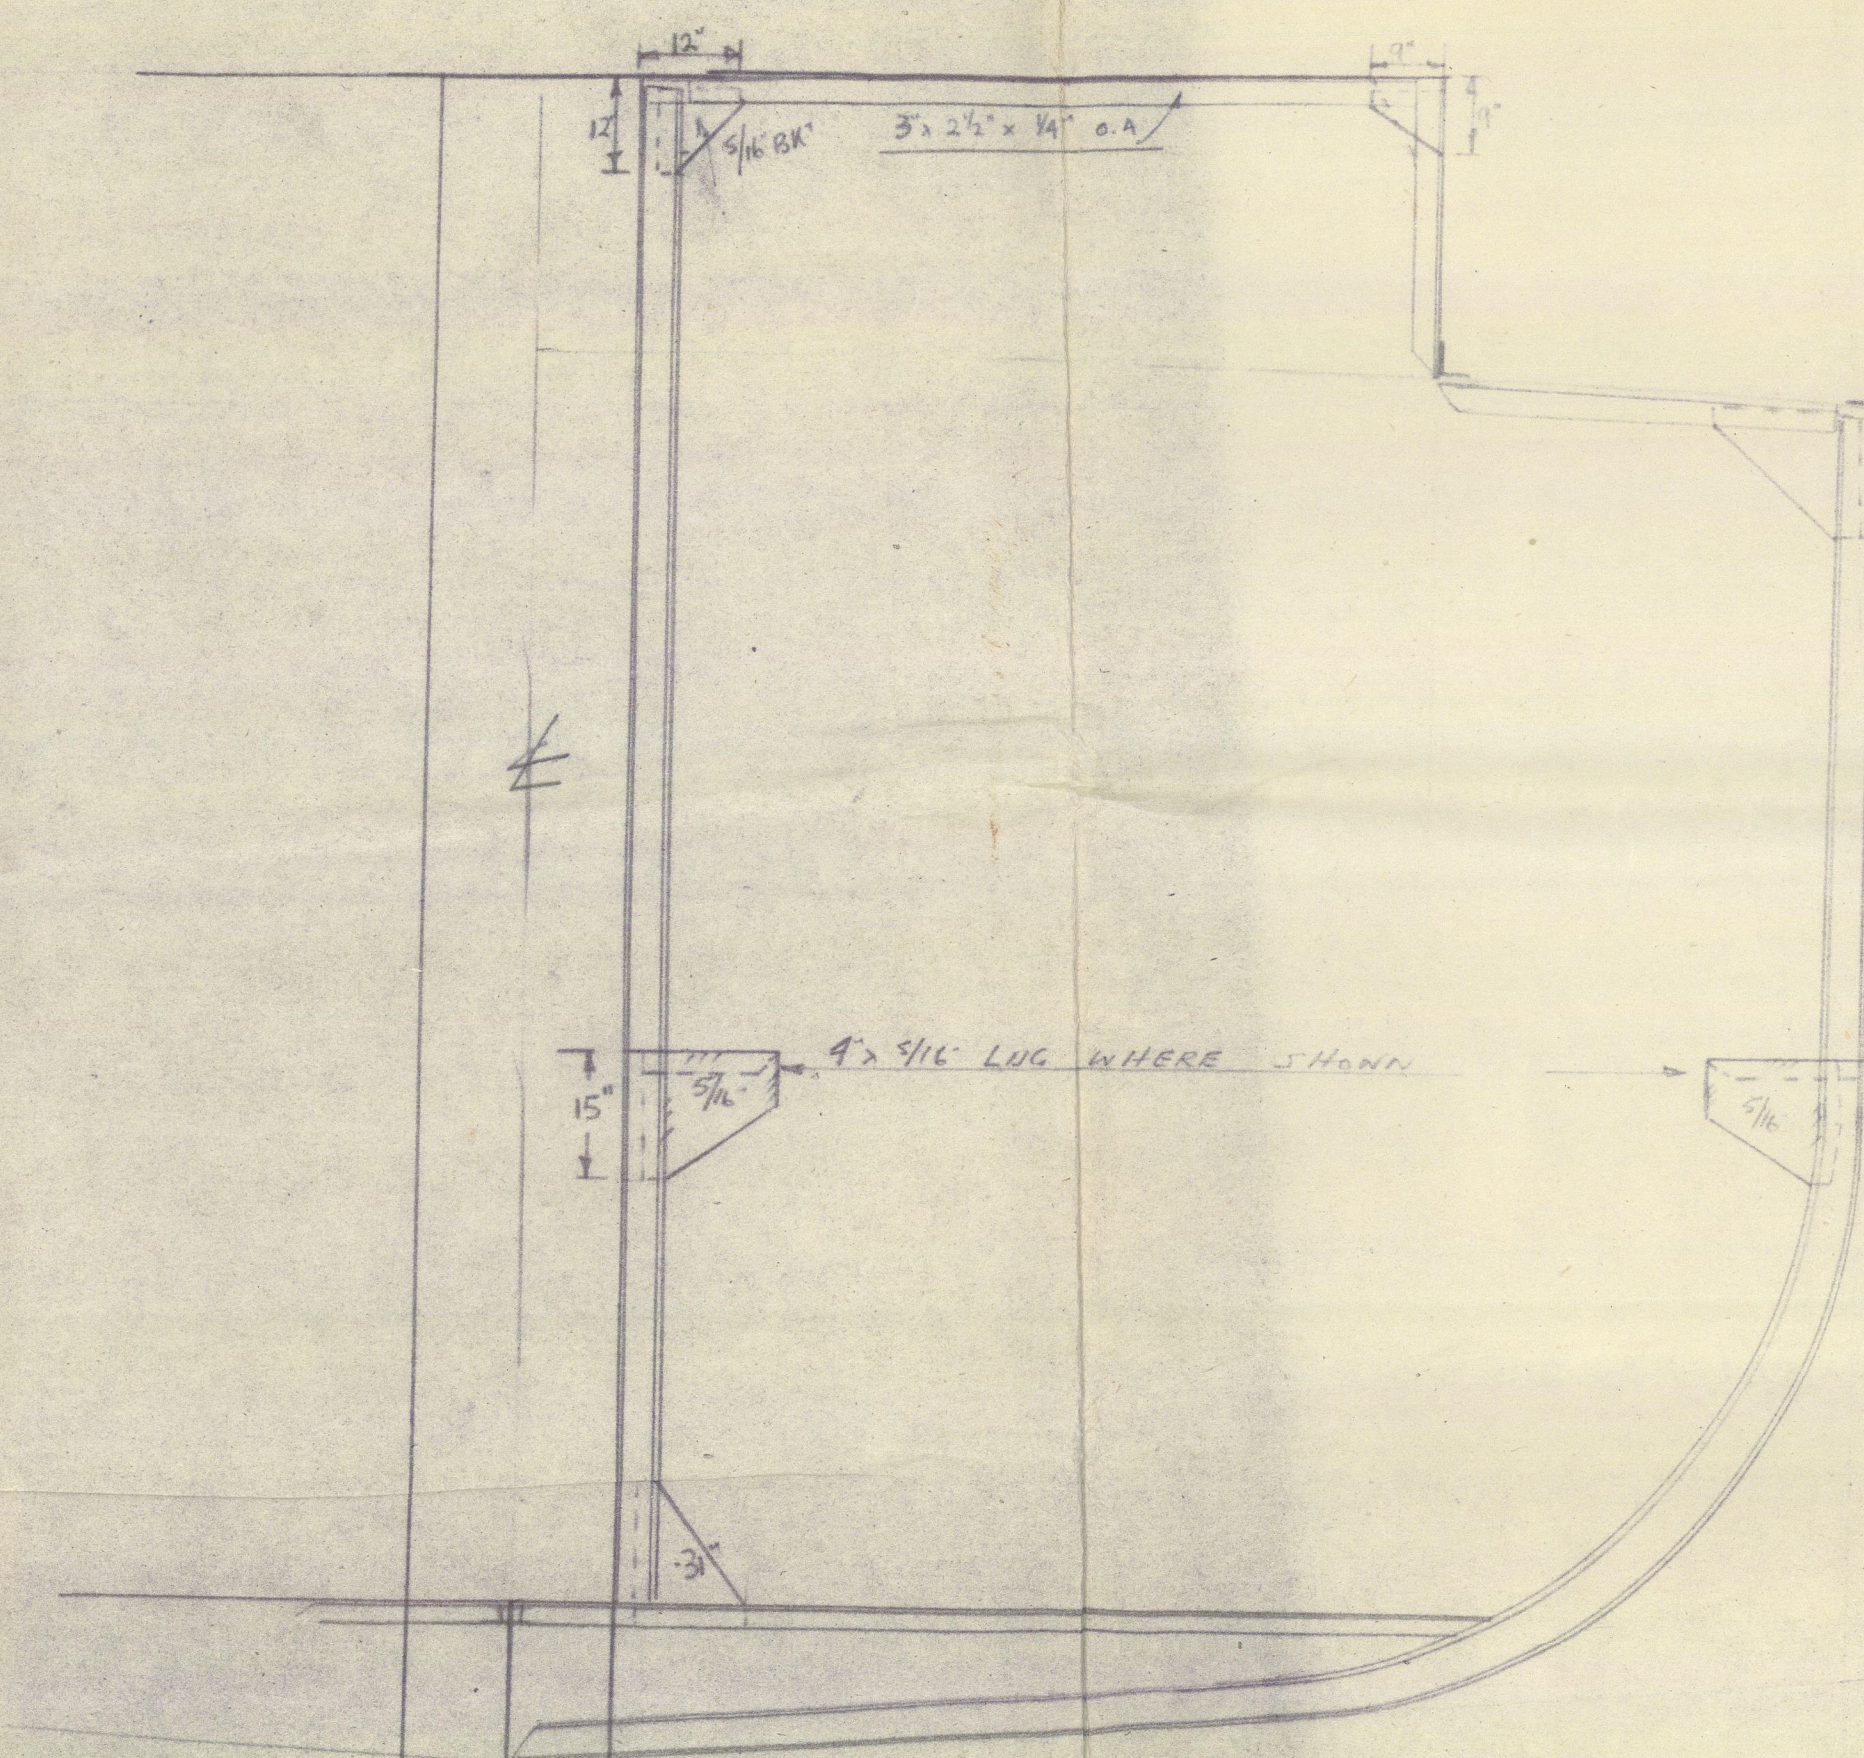



SECTION THRO' STBD TANK

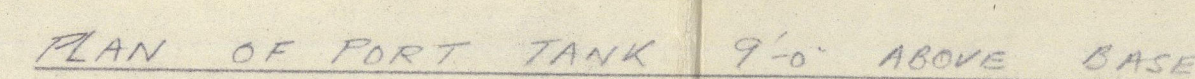


STB<sup>d</sup> SIMILAR

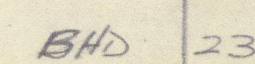

BH<sup>d</sup> 8'-9" OFF & TO PORT

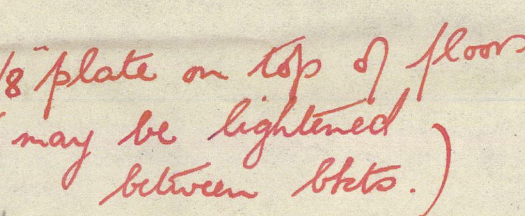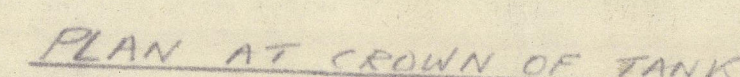


TYPICAL BKT  
AT STFR<sup>3</sup> ON BH<sup>2</sup> 23 & BH<sup>2</sup> 33

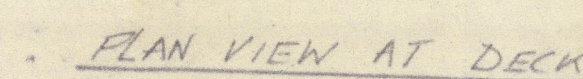

APPROVED  
DYDS REGISTER OF SHIPPING  
UNITED WITH  
JITISE CORPORATION REGISTER

*James R. Carl*  
Date *25/8/55*

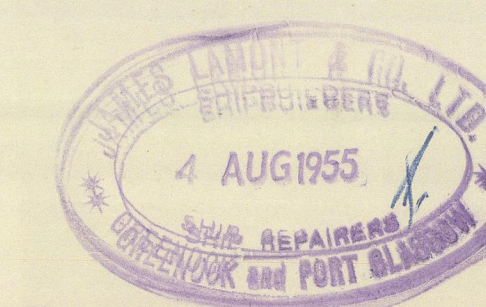



"  
brigades."

Oil Fuel Conversion

Grk. rept. No. 25504.



© 2020

Lloyd's Register  
Foundation

002522-002528-0199