
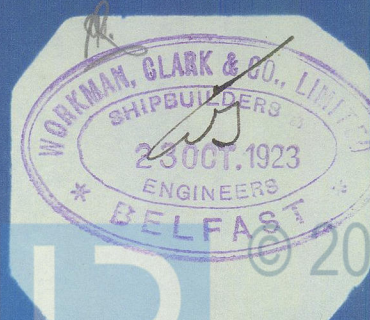


26.10.23.

Nº 472 S.S.
STERN FRAME
 SCALE 1/2" = 1 FOOT
 To LLOYDS APPROVAL.

RIVET HOLES TO BE DRILLED BY CONTRACTORS IN POSITIONS SHOWN.
 RIVET HOLES 1 3/16 DIAR. & SPACED 5 7/8" APART UNLESS NOTED OTHERWISE.
 GUDGEONS BORED BY CONTRACTOR AS SHOWN ON PLAN.
 FACES OF BOSS TO BE MACHINED SQUARE TO SHAFT CENTRE.

FORGED IRON.

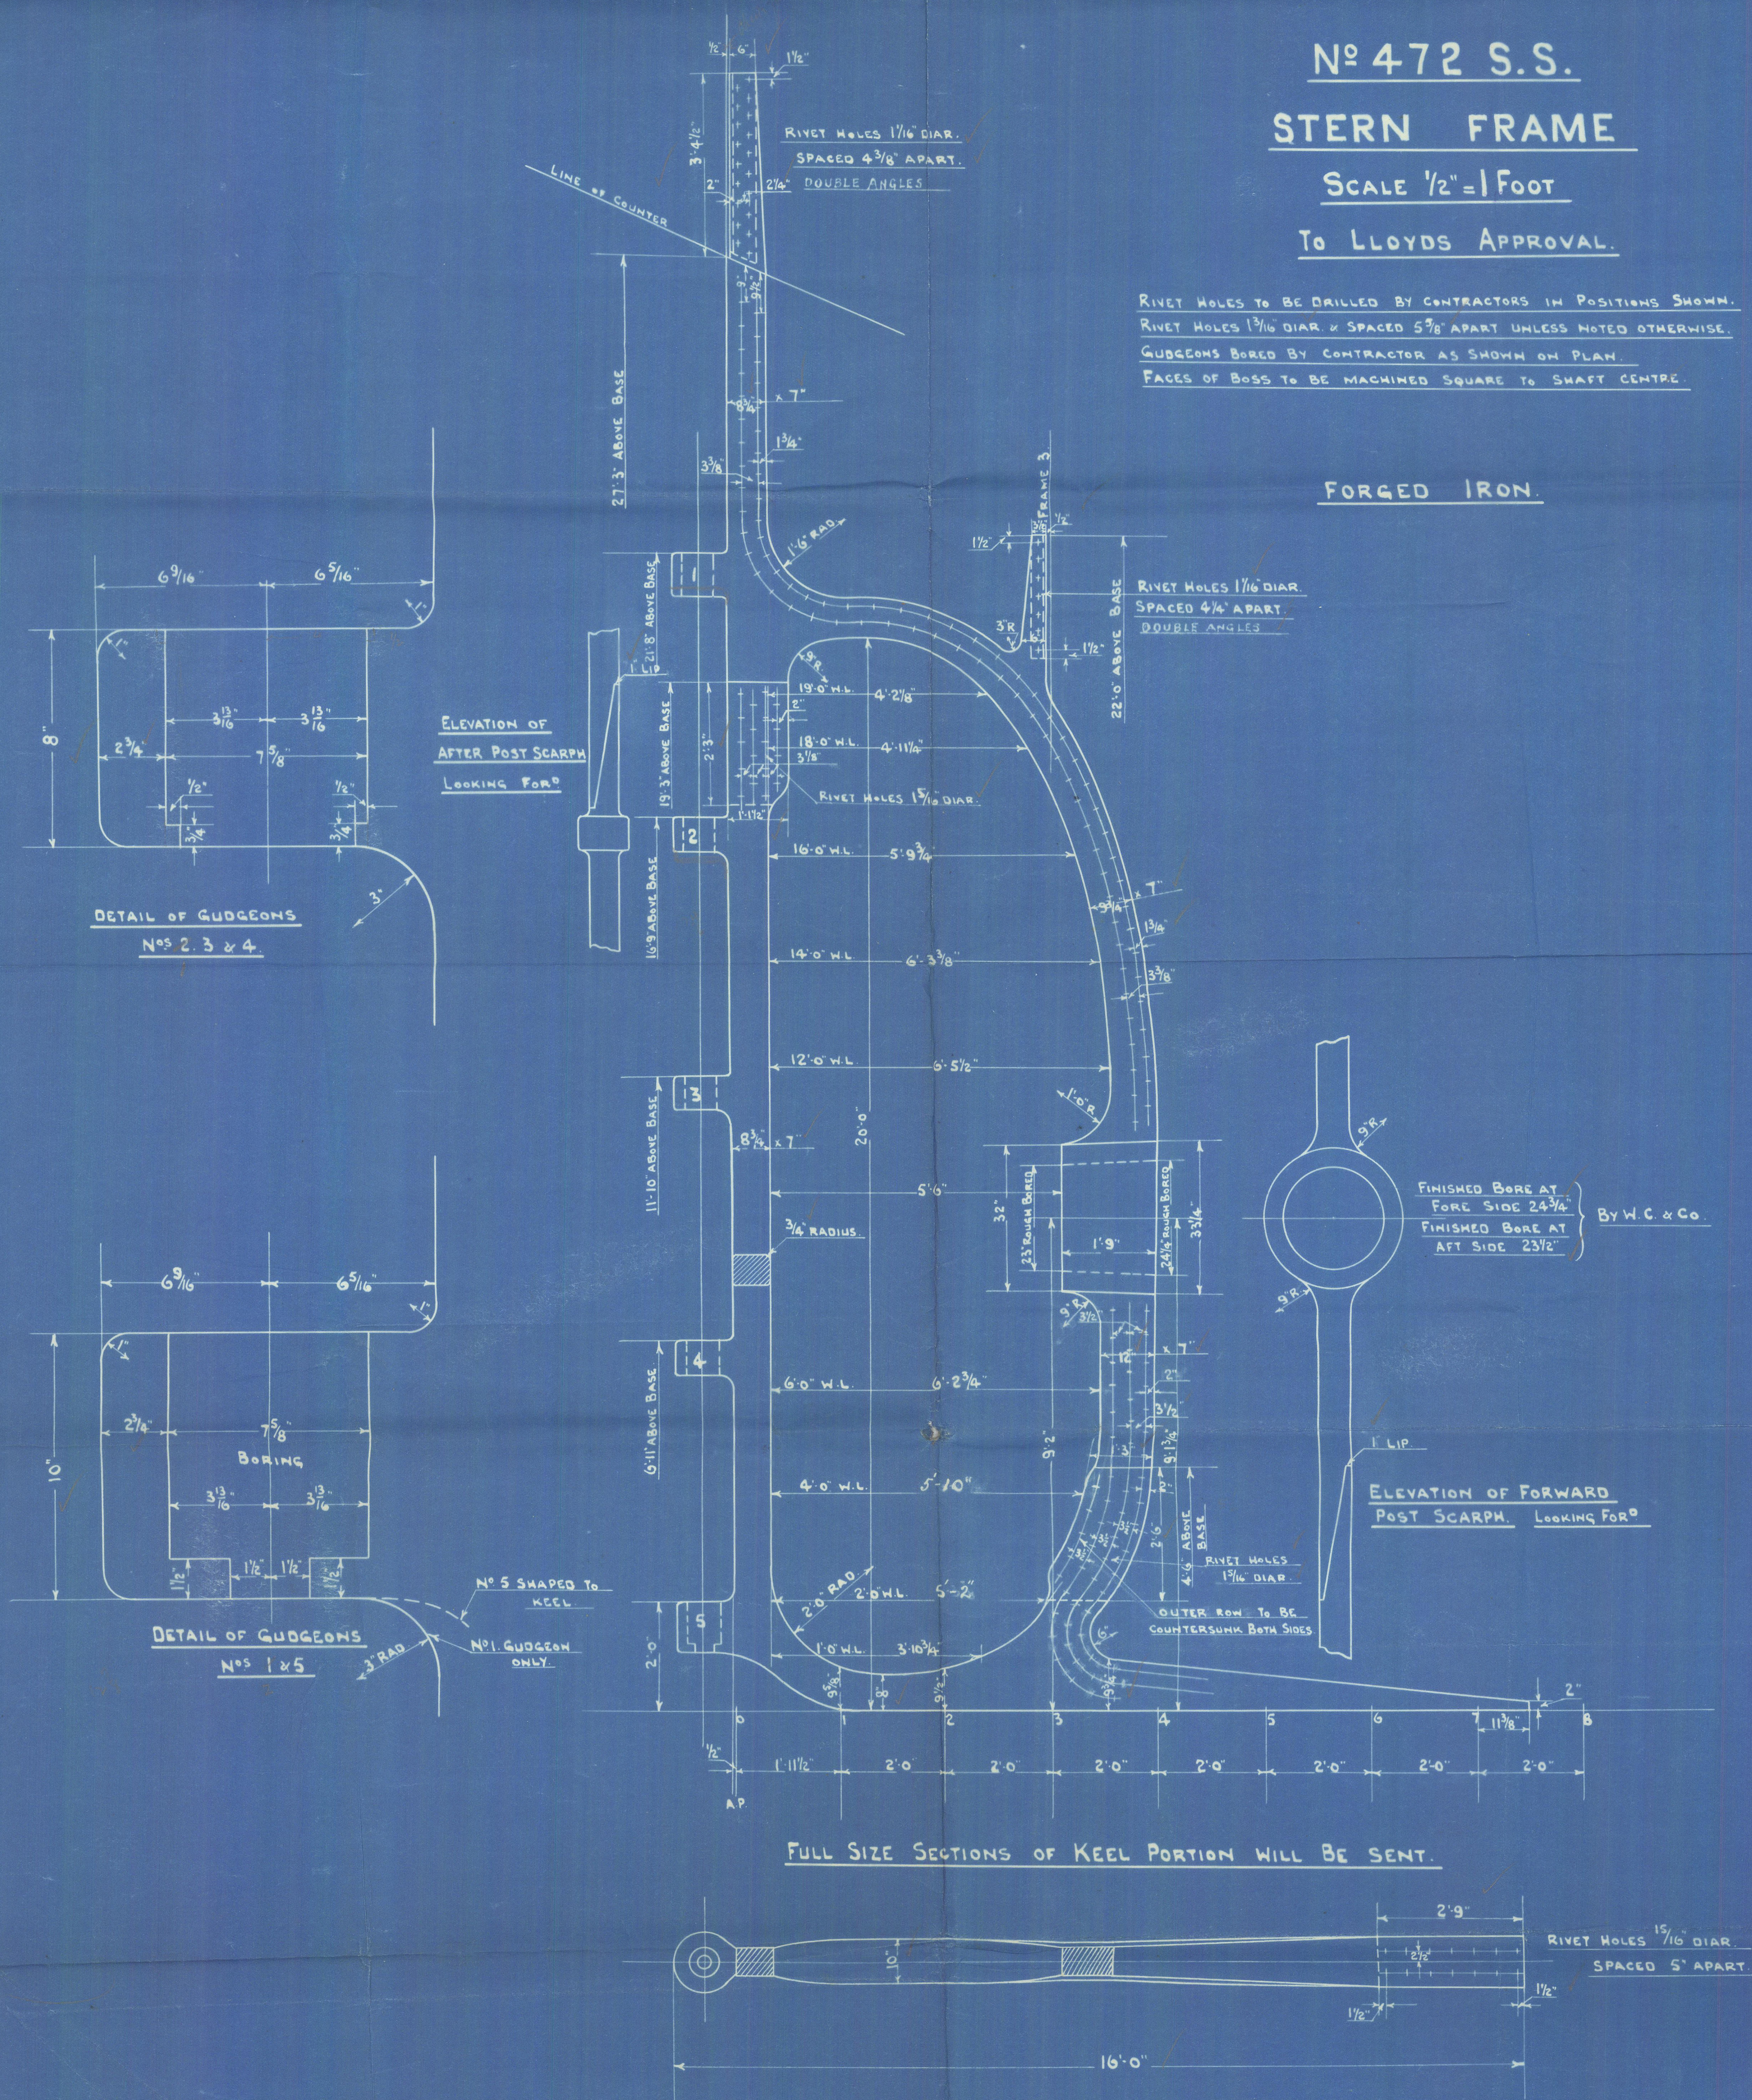

Plan of

Stern Frame

1712 A 12

For Enclosure to

Messrs.

Lloyds Surveyors

Belfast.

S. S. 472.

STERN. FRAME

(AMENDED).

1/5 Atlantida

Pat 9122



© 2021

Lloyd's Register
Foundation

002529-002535-0017